
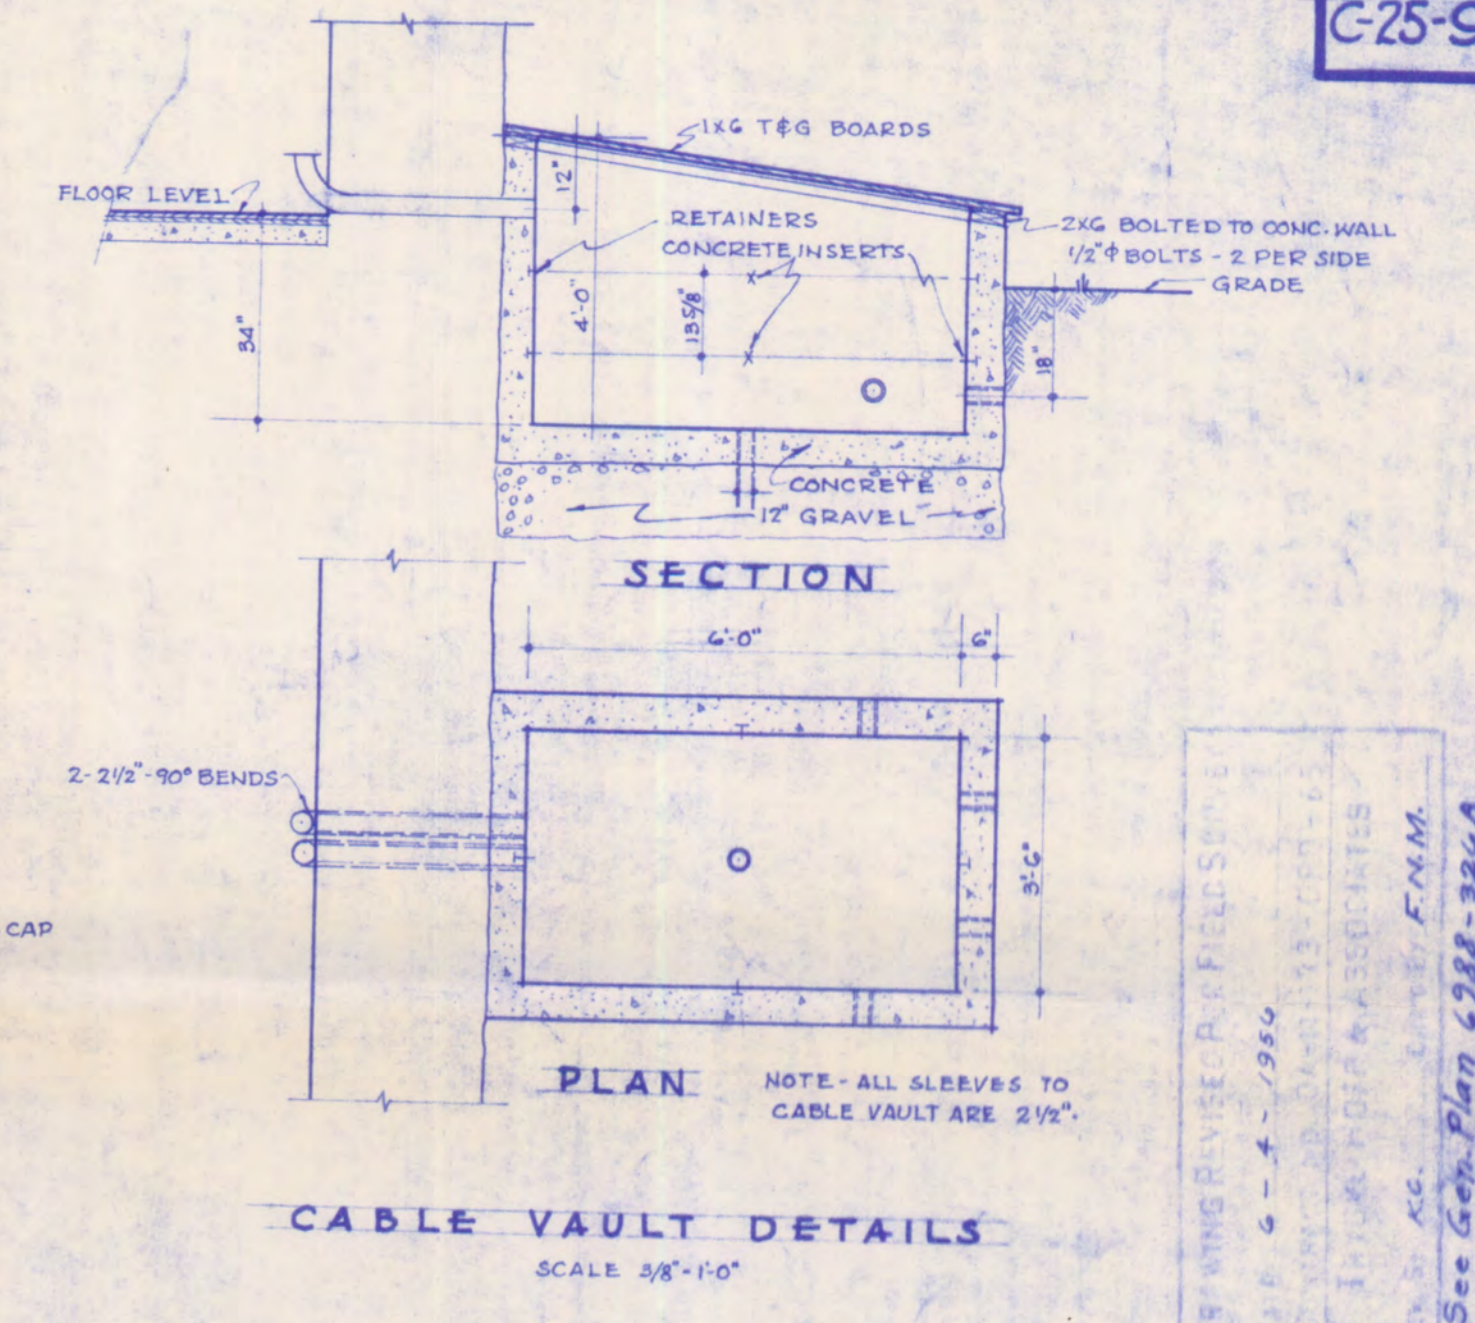








DOOR SCHEDULE

TYPE	NUMBER	WIDE	HIGH	THICK	REMARKS
A	101	6'-0"	7'-0"	1 3/4"	WOOD-METAL COVERED-DOUBLE DOOR
B	102-104	-	-	-	EXISTING DOORS
C	105	-	-	-	-

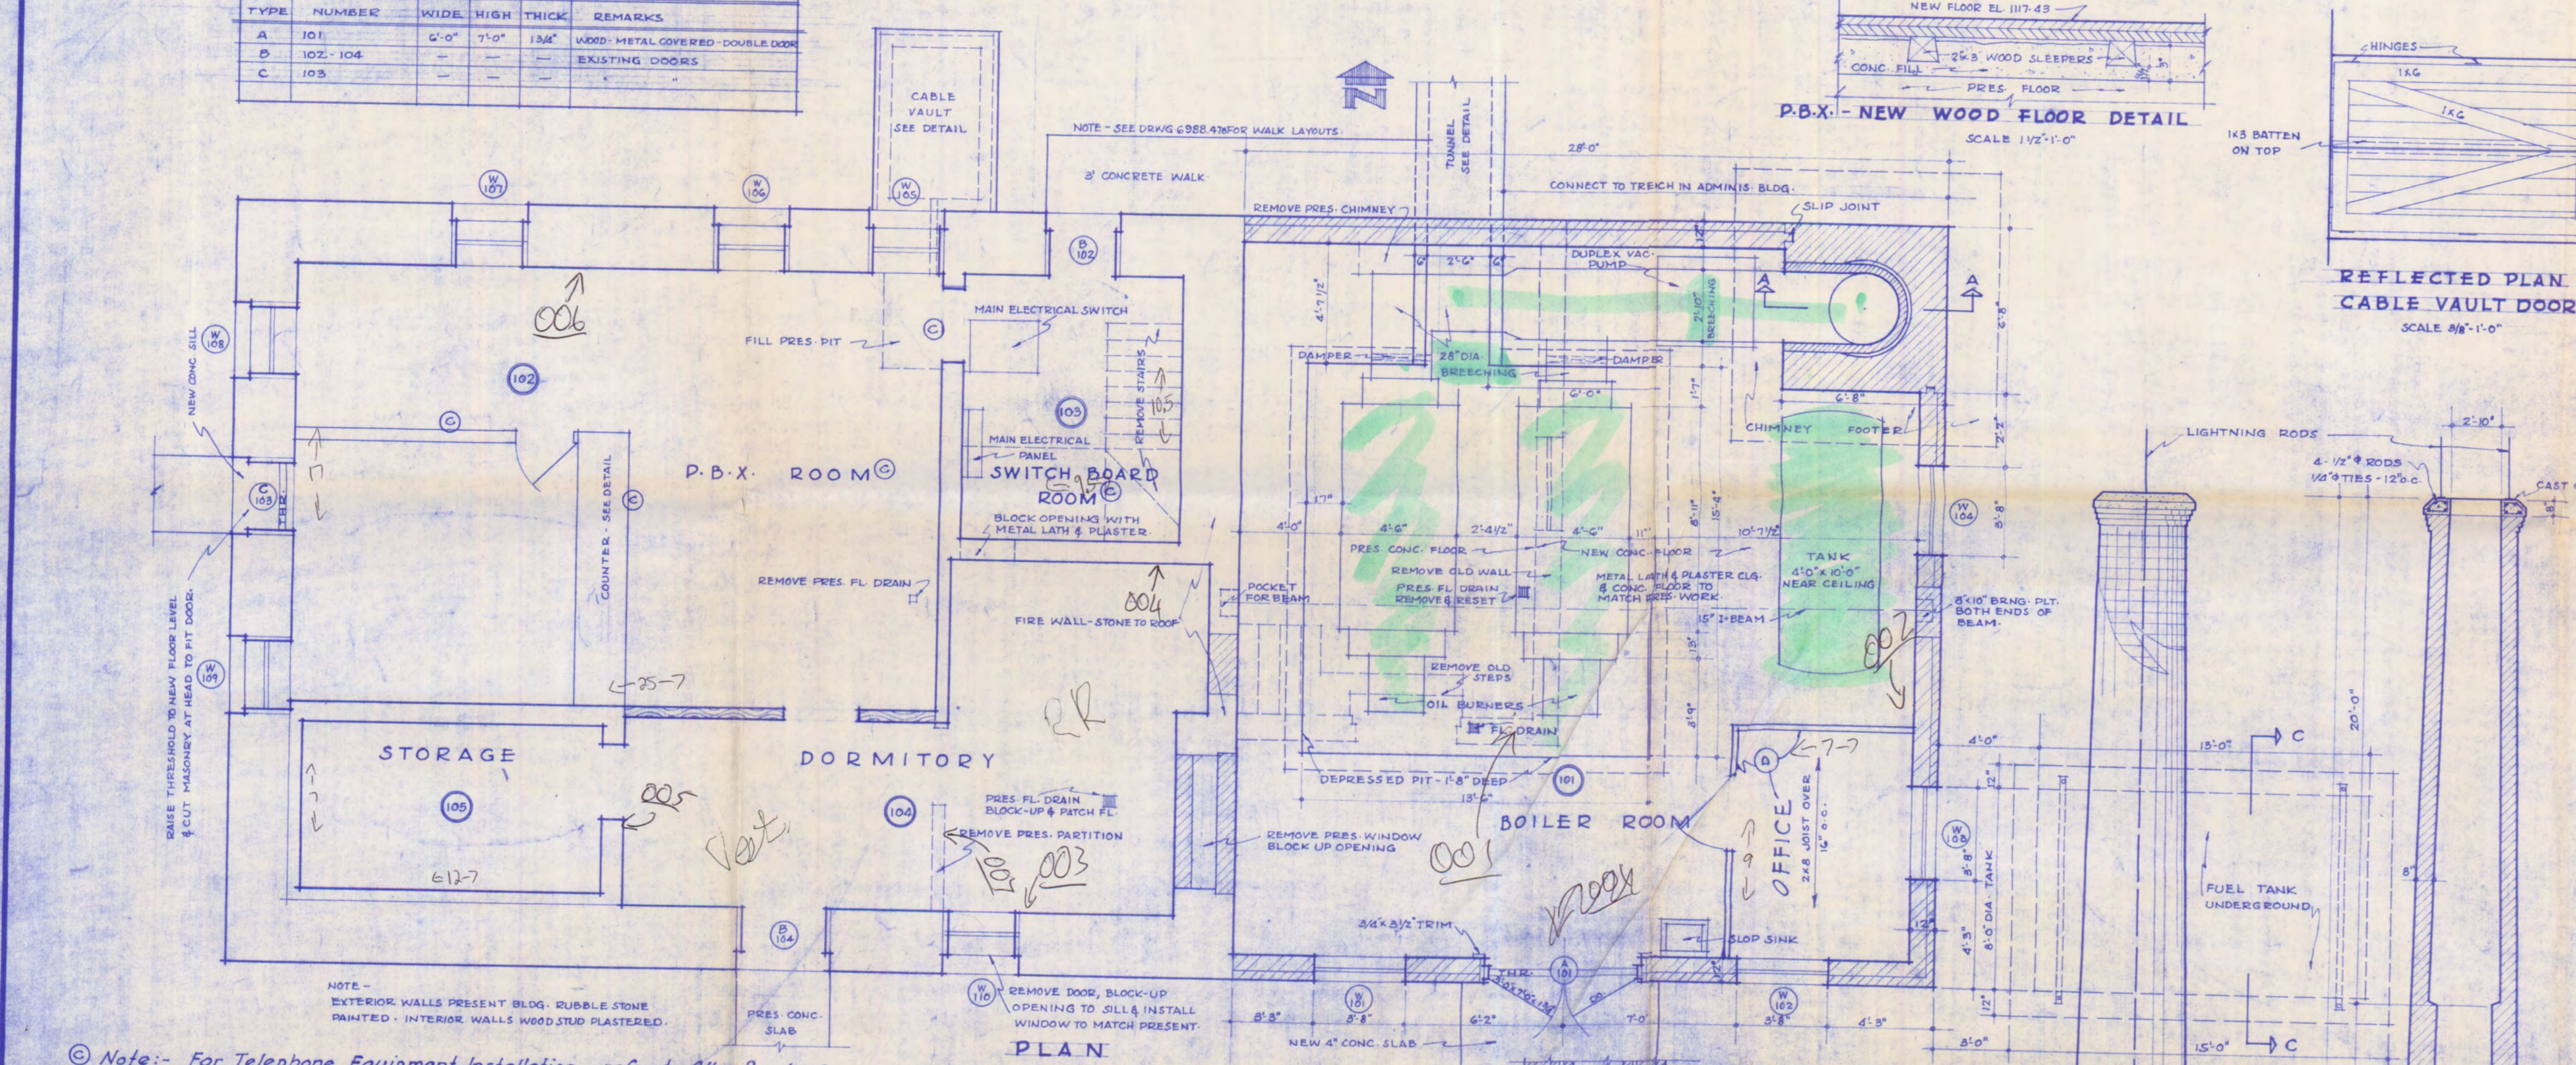

ROOM SCHEDULE

No.	NAME	FLOOR	BASE	WALLS	CEILING	REMARKS
101	BOILER ROOM	NEW 5"	CONC.	EXP. TILE	NEW CEMENT PLASTER	REMOVE PRE-FL. FINISH. INSTALL NEW CONC.
102	P.B.X. ROOM	NEW WOOD	NEW WOOD	PATCH PLASTER	PATCH PLASTER	REMOVE PRE-FL. WALL BOARD
103	SW. BD. ROOM	PRE-CONC.	PRE-CONC.	NEW	NEW	REMOVE PRE-FL. WALL BOARD
104	DORMITORY	-	-	PATCH	PATCH	REMOVE PRE-FL. WALL BOARD
105	STORAGE	-	-	-	-	-

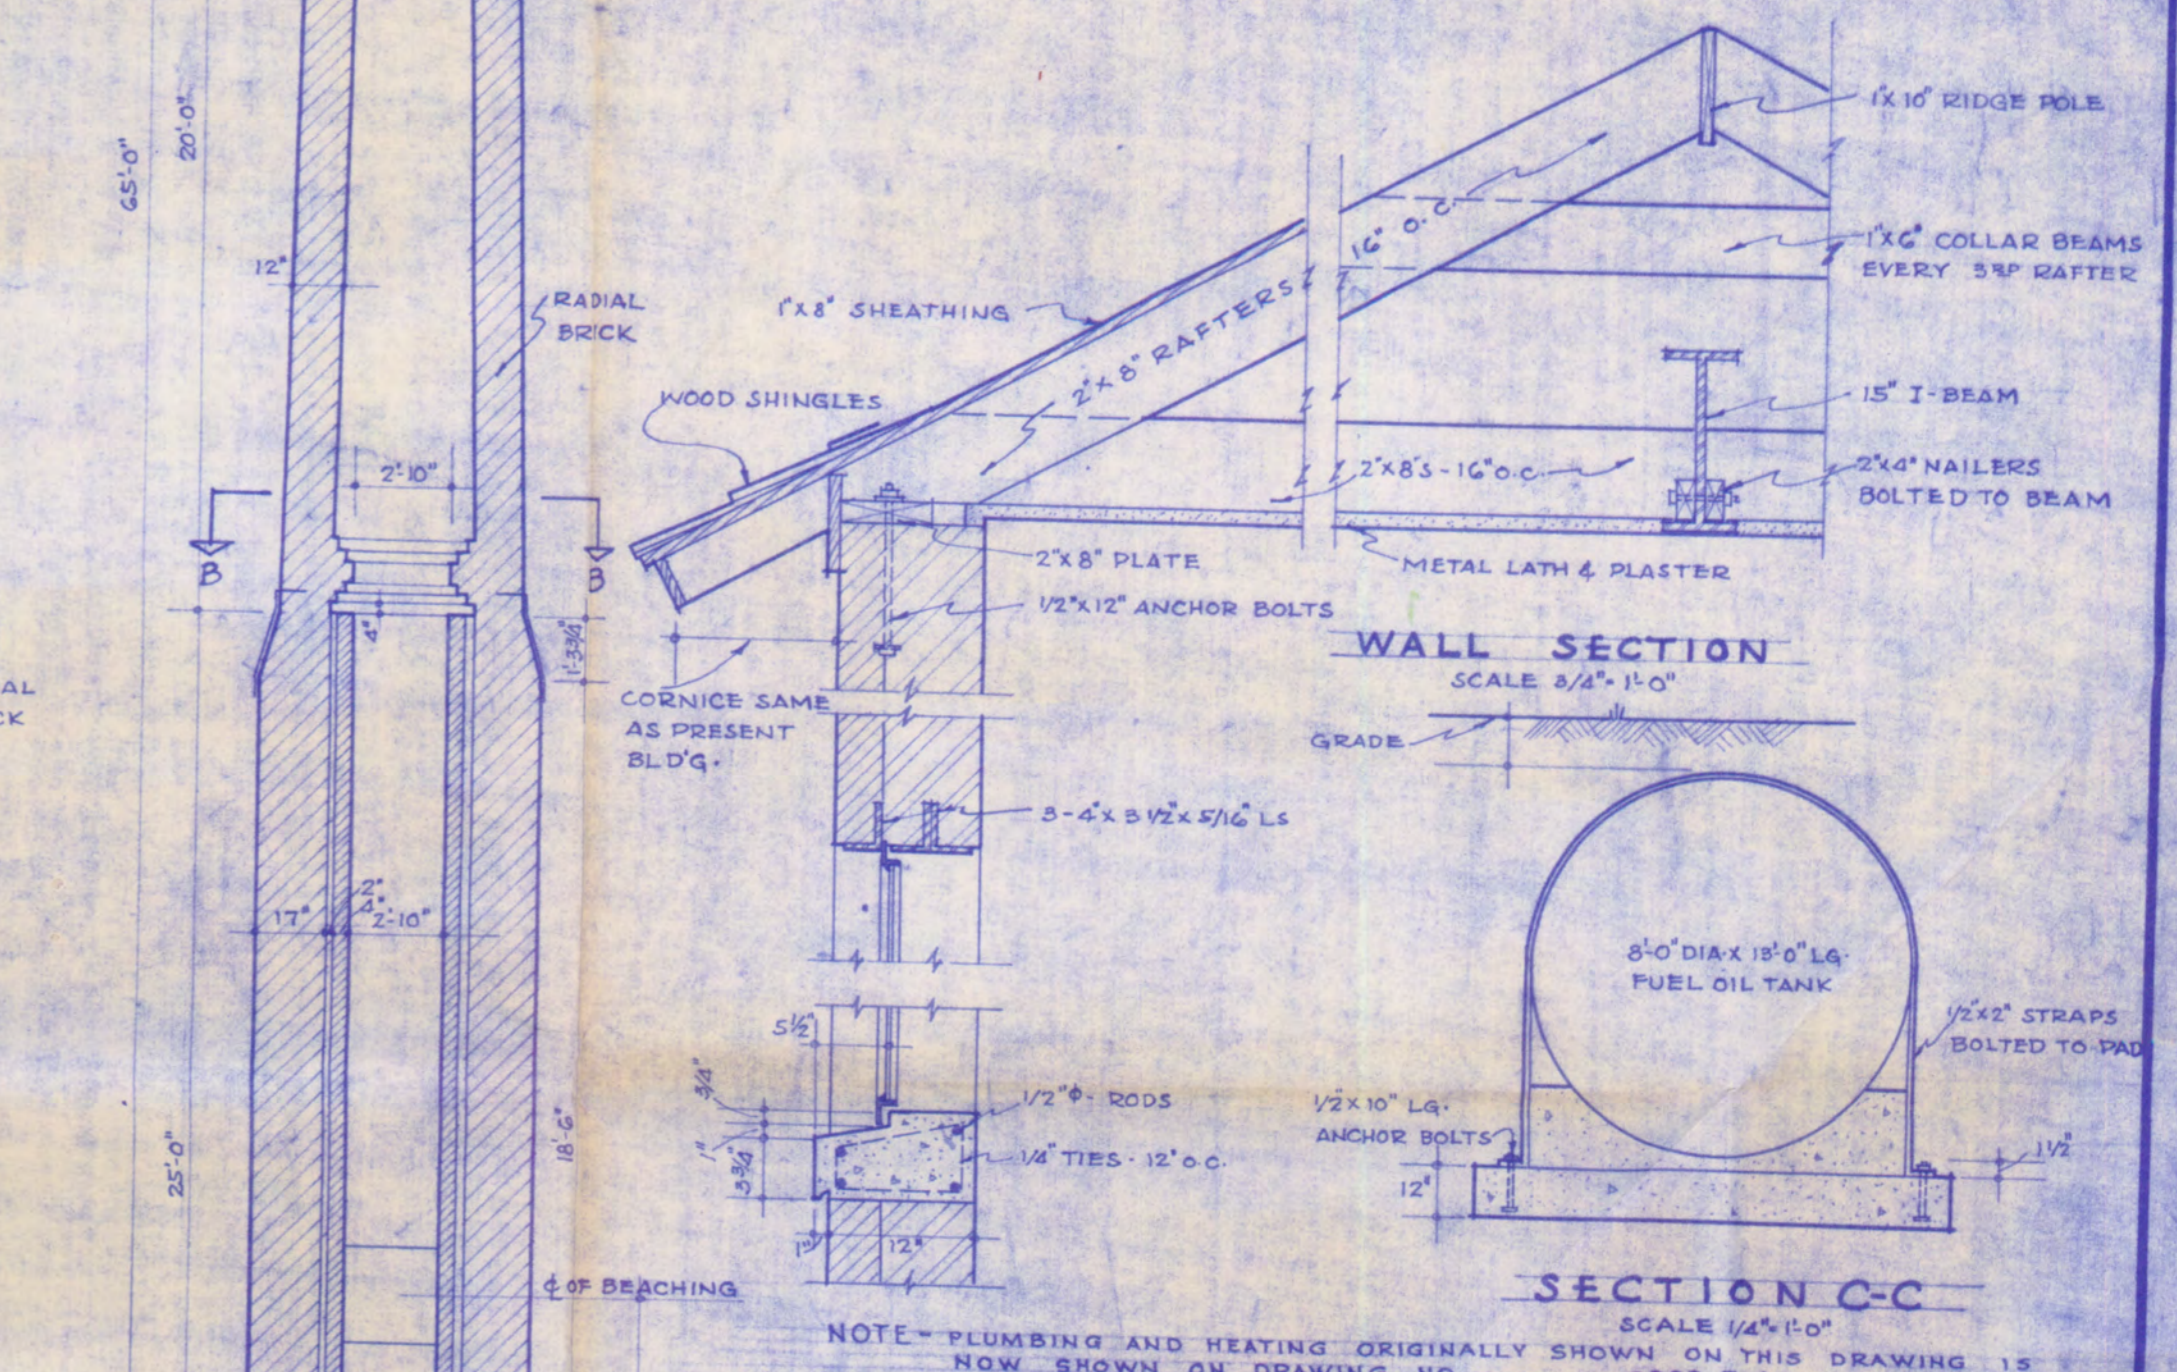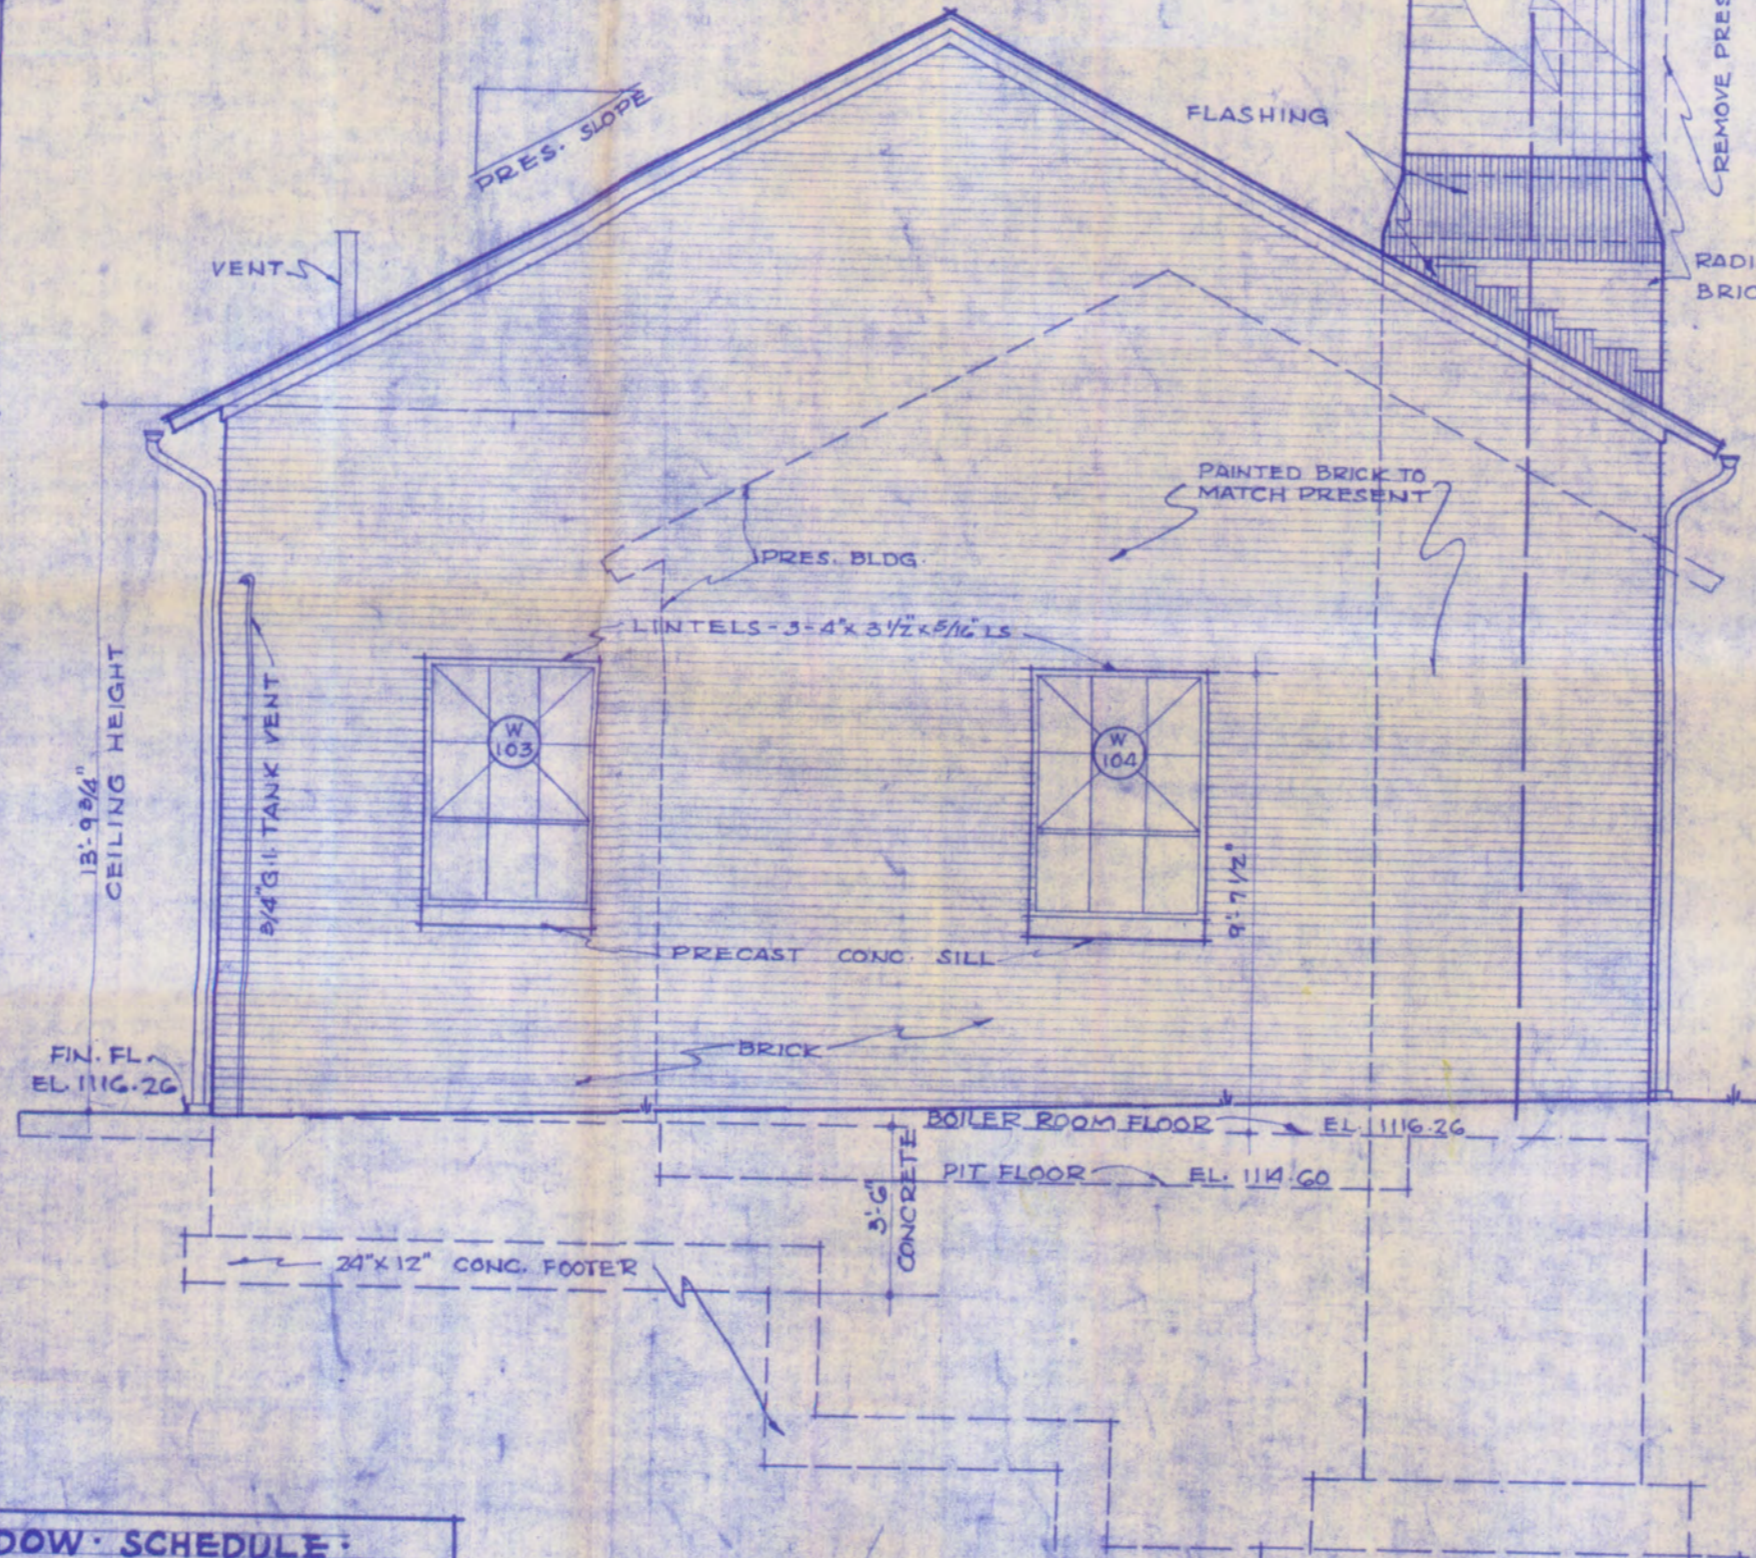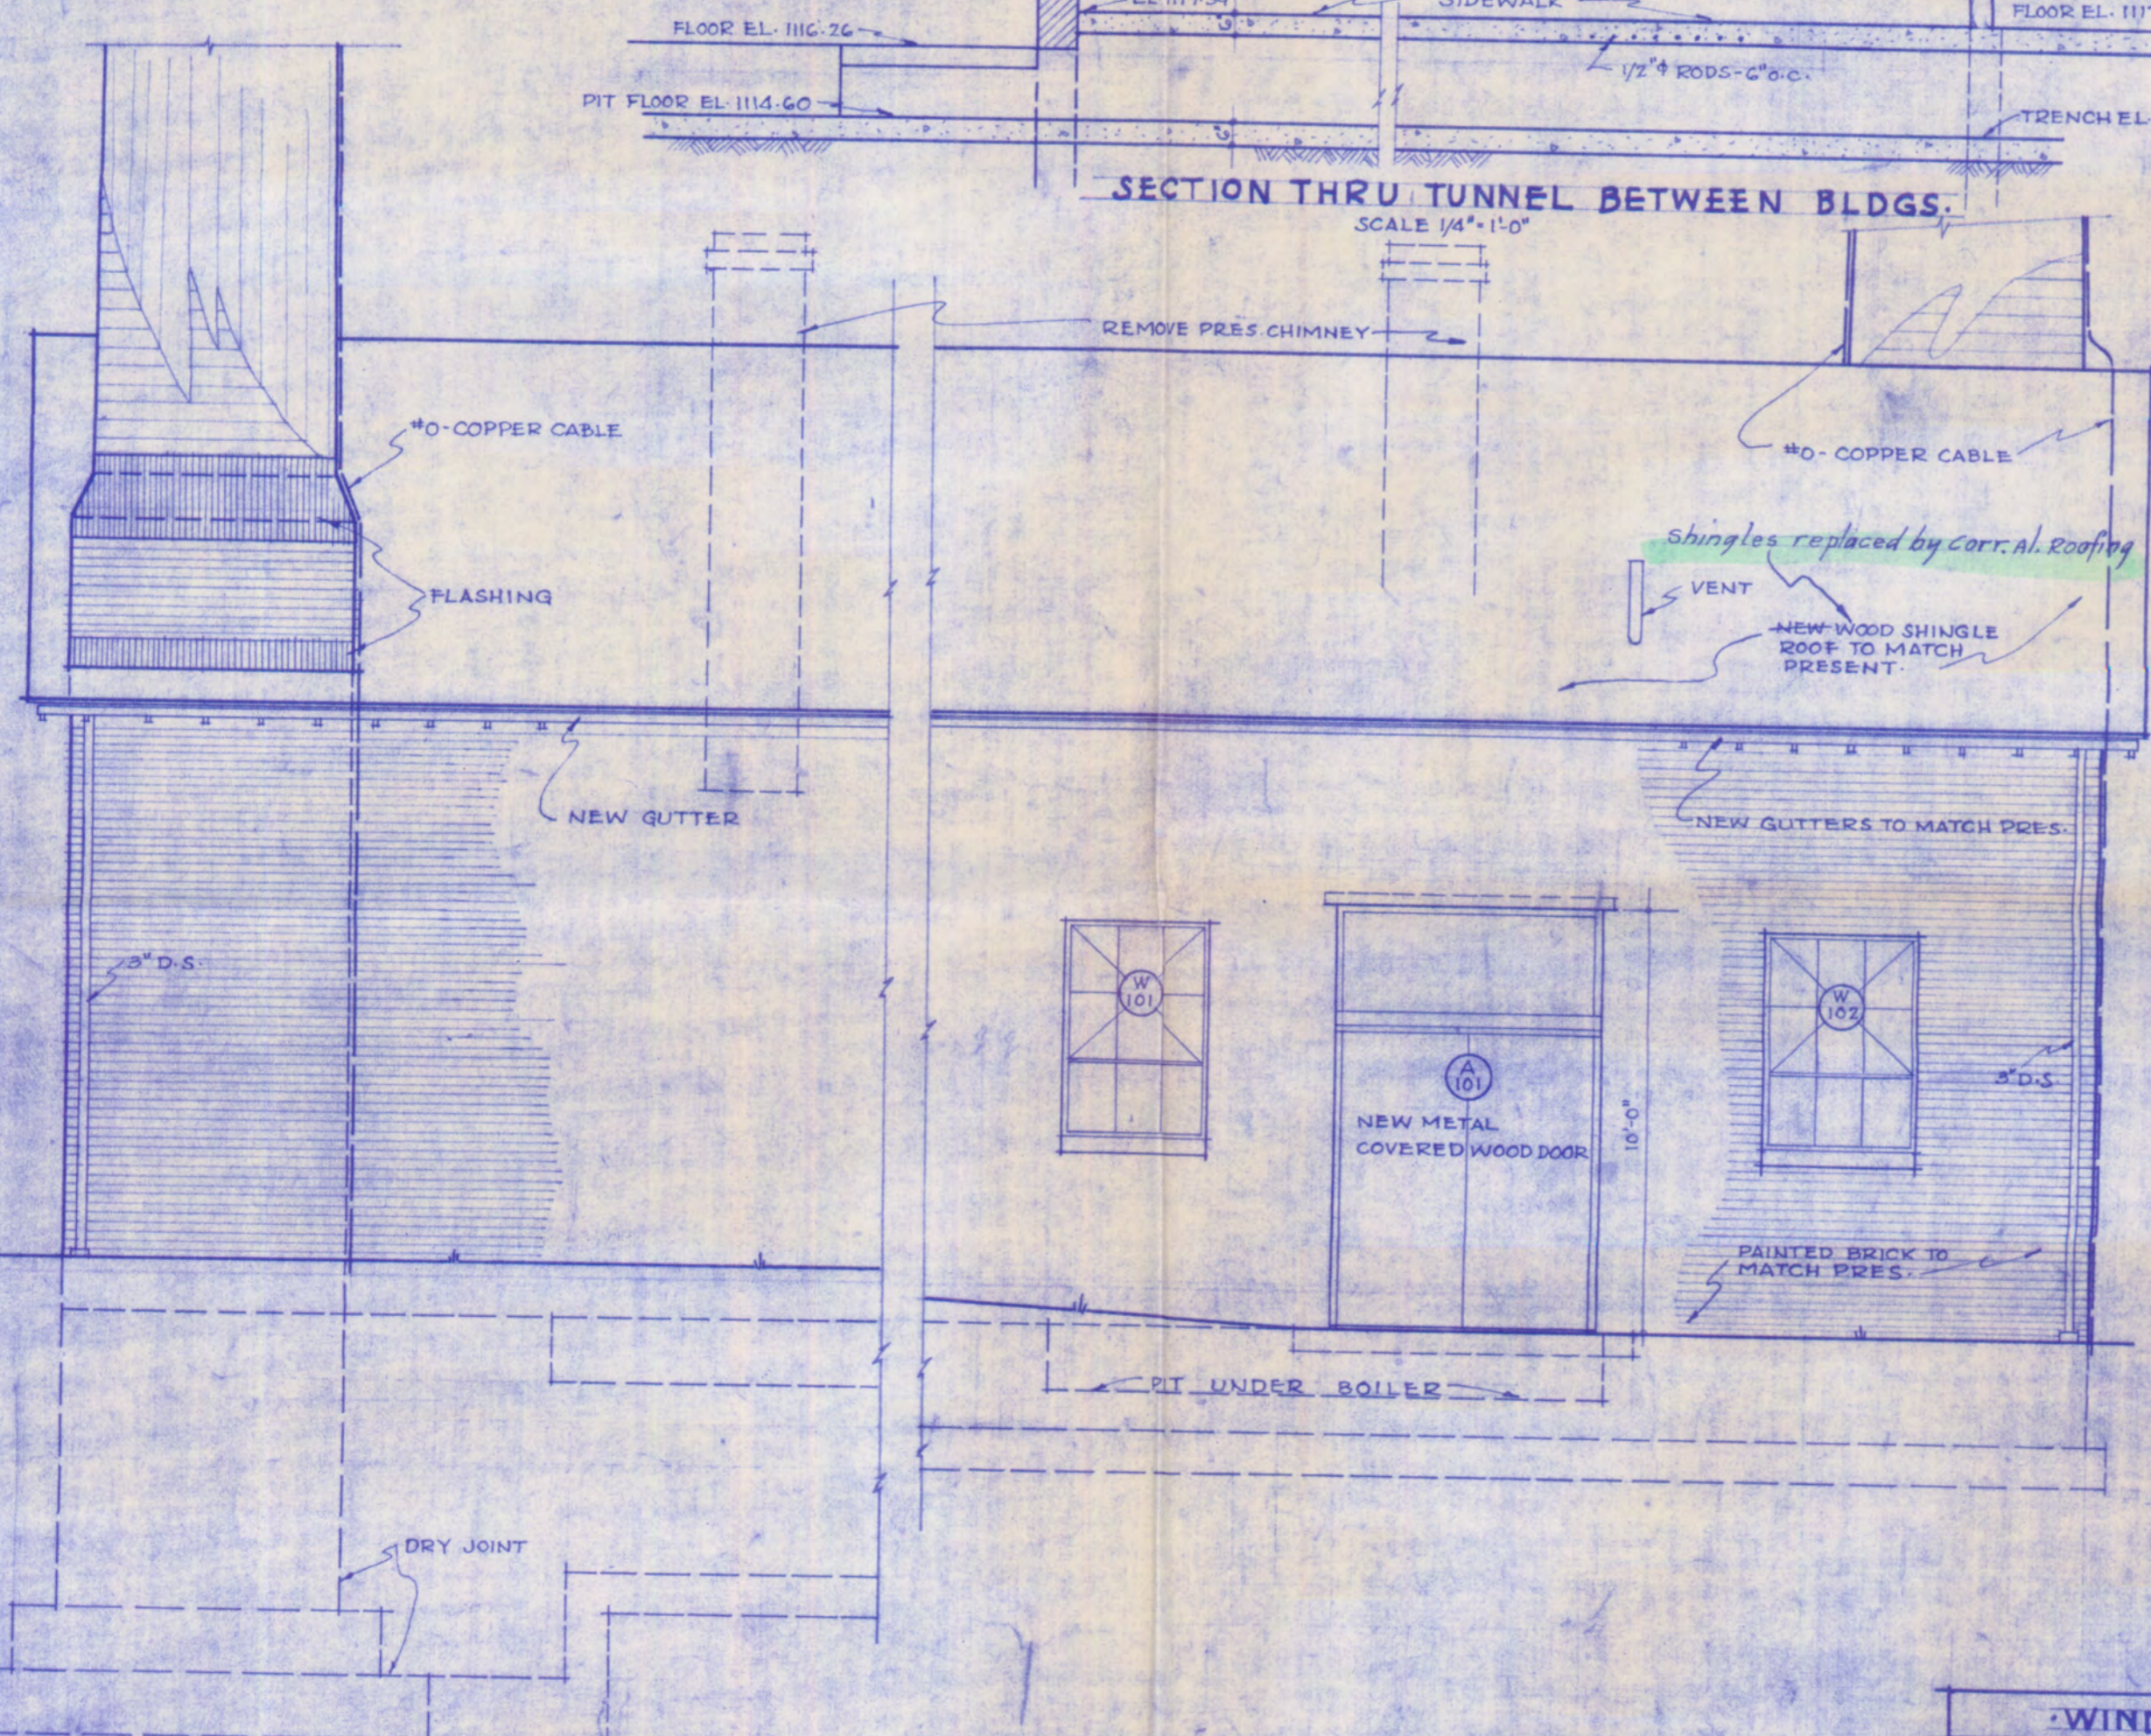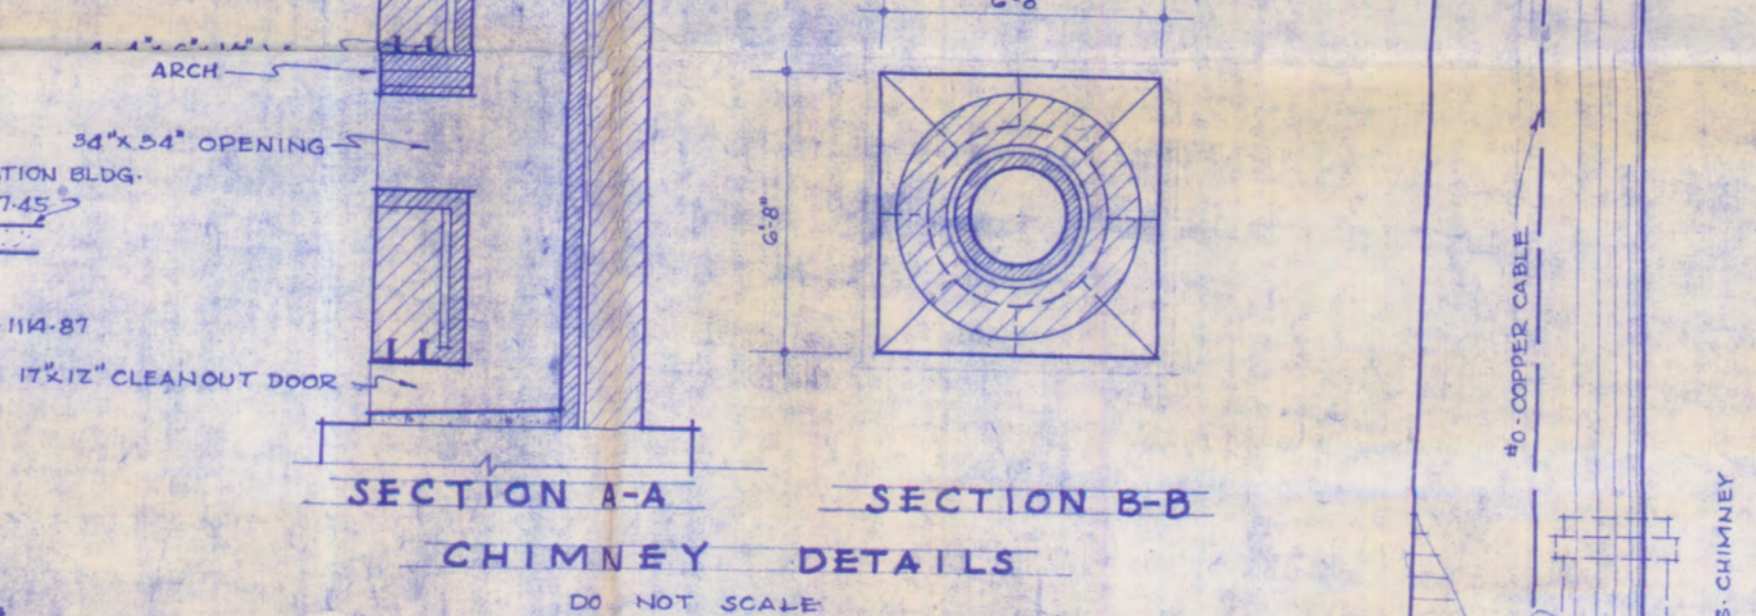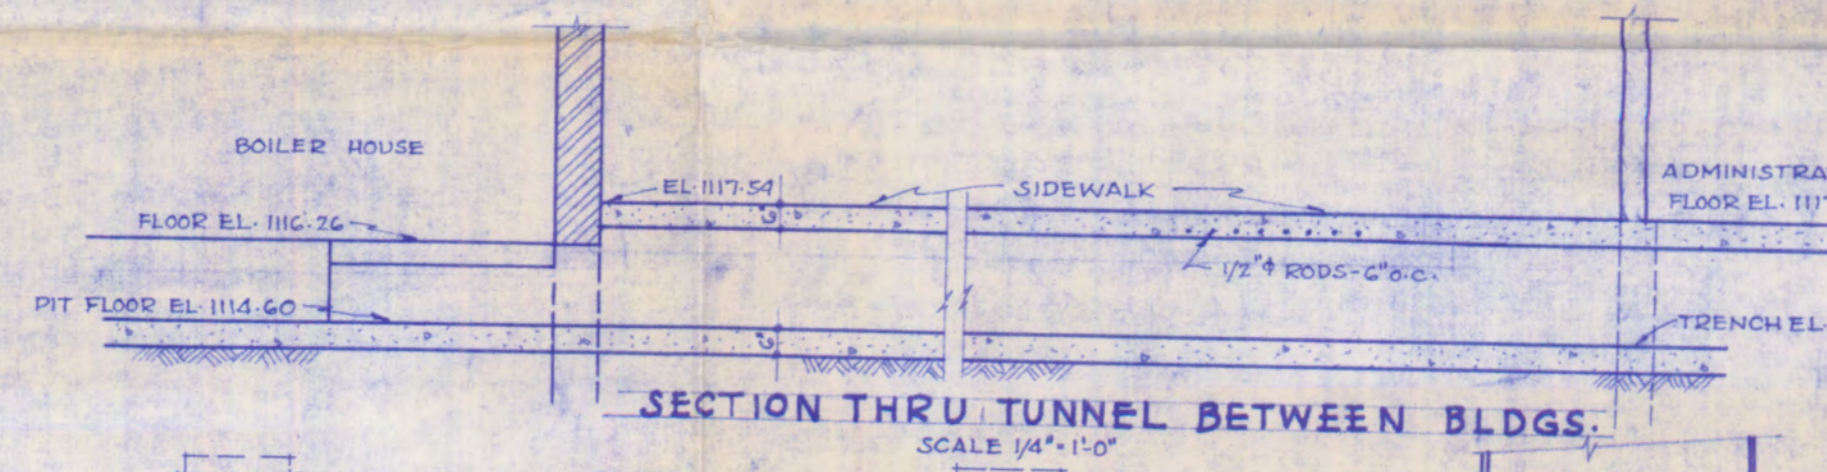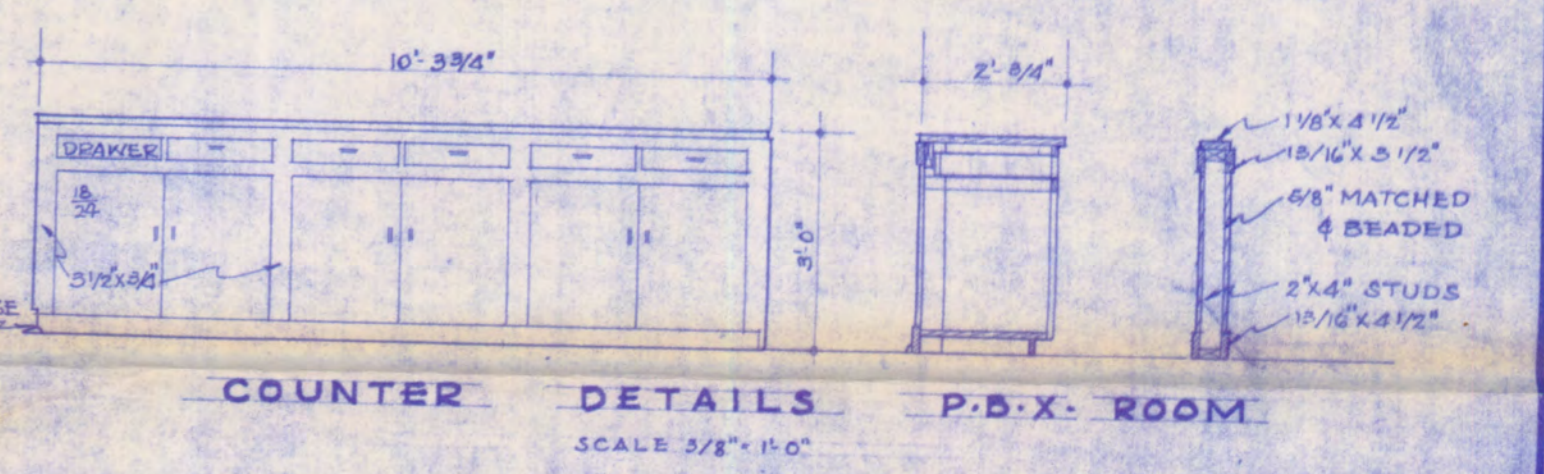

WINDOW SCHEDULE

NUMBER	REMARKS
101-102-103-104	STEEL SASH (NEW)
105-106-107-108-109-110	WOOD-DR. HUNG (PRES.)

THE JENNINGS - LAWRENCE Co.
ARCHITECT - ENGINEER
COLUMBUS, O. - RAVENNA, O.

CONSTRUCTION DIVISION
 OFFICE OF THE QUARTERMASTER GENERAL

PORTAGE ORDNANCE DEPOT
BOILER HOUSE
BOLTON BARN AREA

SCALE AS NOTED
 REVISIONS:
 A TRACED ORG. DRAWING WITH CORRECTIONS AS BUILT. 2/22/54
 B BLDG. NO. 101 2/24/54
 C REP. IN REV. PLAN 2/24/54
 D OFFICE REVISION 2/24/54

DRAWN BY: S.H.R. CHECKED BY: W.E.R. APPROVED BY: DIRECTOR DATE: 9-8-51

TRACED BY: S.H.R. DRAWN BY: D.S. CHAVIN / S. LT. COL. ORD. DEPT. PLAN NUMBER: 6988-503

© BUILDING NO. A-1