

WEST ELEVATION
SCALE 1/4" = 1'-0"

SOUTH ELEVATION
SCALE 1/4" = 1'-0"

EAST ELEVATION
SCALE 1/4" = 1'-0"

NORTH ELEVATION
SCALE 1/4" = 1'-0"

SECTION-A-A
SCALE 3/4" = 1'-0"

FOUNDATION PLAN
SCALE 1/4" = 1'-0"



FLOOR PLAN
SCALE 1/4" = 1'-0"

ROOM SCHEDULE

| NO | NAME | FLOOR | BASE | WALLS | CEILING | WAINSC | TRIM FINISH | FINISH | REMARKS |
|-----|--------------|--------|-------------|-------------|---------|--------|-------------|--------|---------|
| 101 | STORAGE ROOM | CEMENT | CEMENT BLK. | M. L. & PL. | | | PAINT | | |
| 102 | OFFICE | do. | do. | do. | | | do. | | |
| 103 | HEATER ROOM | do. | do. | do. | | | do. | | |


DOOR SCHEDULE

| TYPE | NUMBER | WIDE | HIGH | THICK | REMARKS |
|------|--------|-------|-------|--------|---------------------------------------|
| A | 101 | 3'-0" | 7'-0" | 1 3/4" | EXTERIOR DOORS |
| A | 102 | 3'-0" | 6'-8" | 1 3/4" | do. do. |
| B | 103 | 3'-0" | 6'-8" | 1 3/8" | |
| B | 104 | 2'-4" | 6'-8" | 1 3/8" | |
| C | 105 | 3'-0" | 6'-8" | 1 3/8" | METAL COVERED - HEATER ROOM SIDE ONLY |

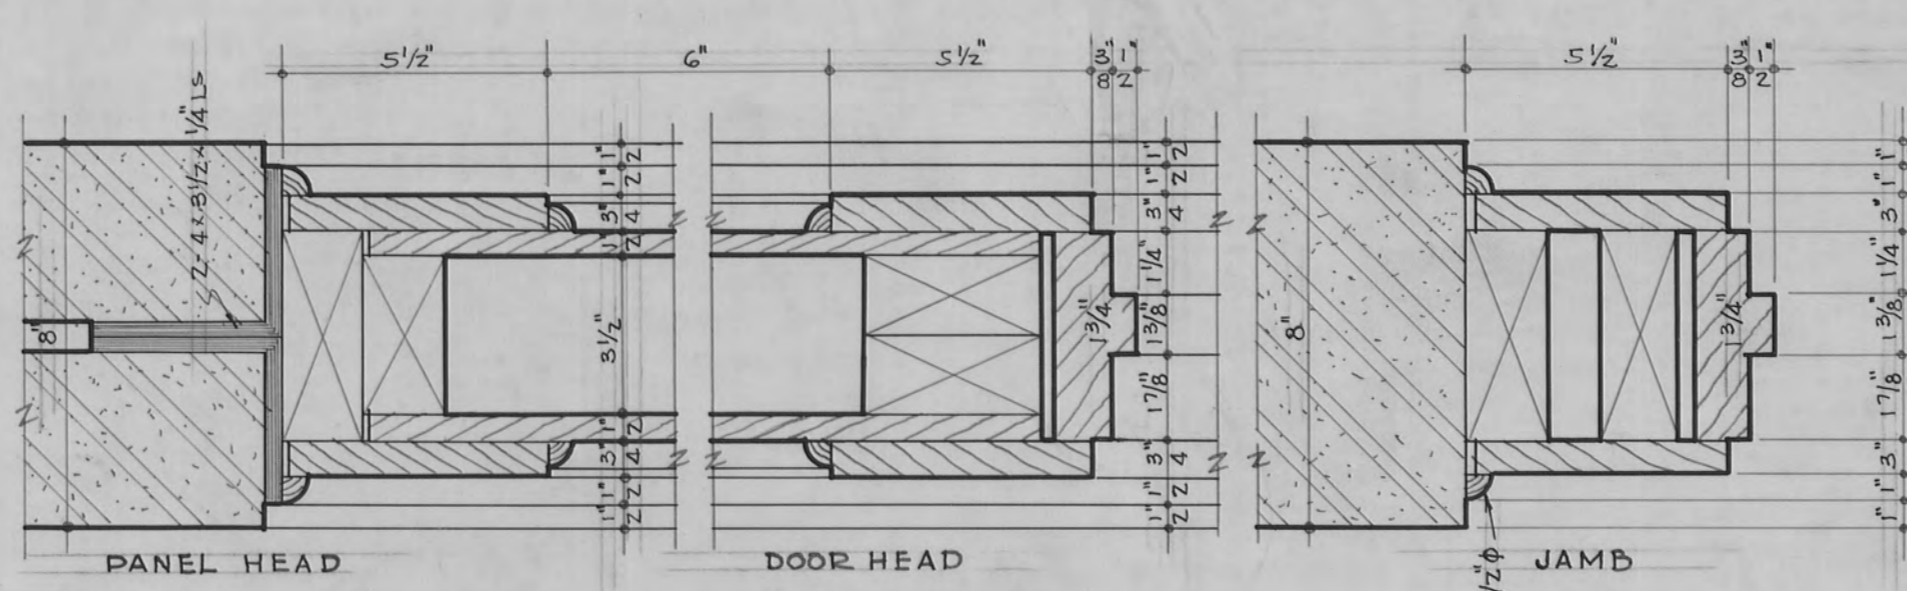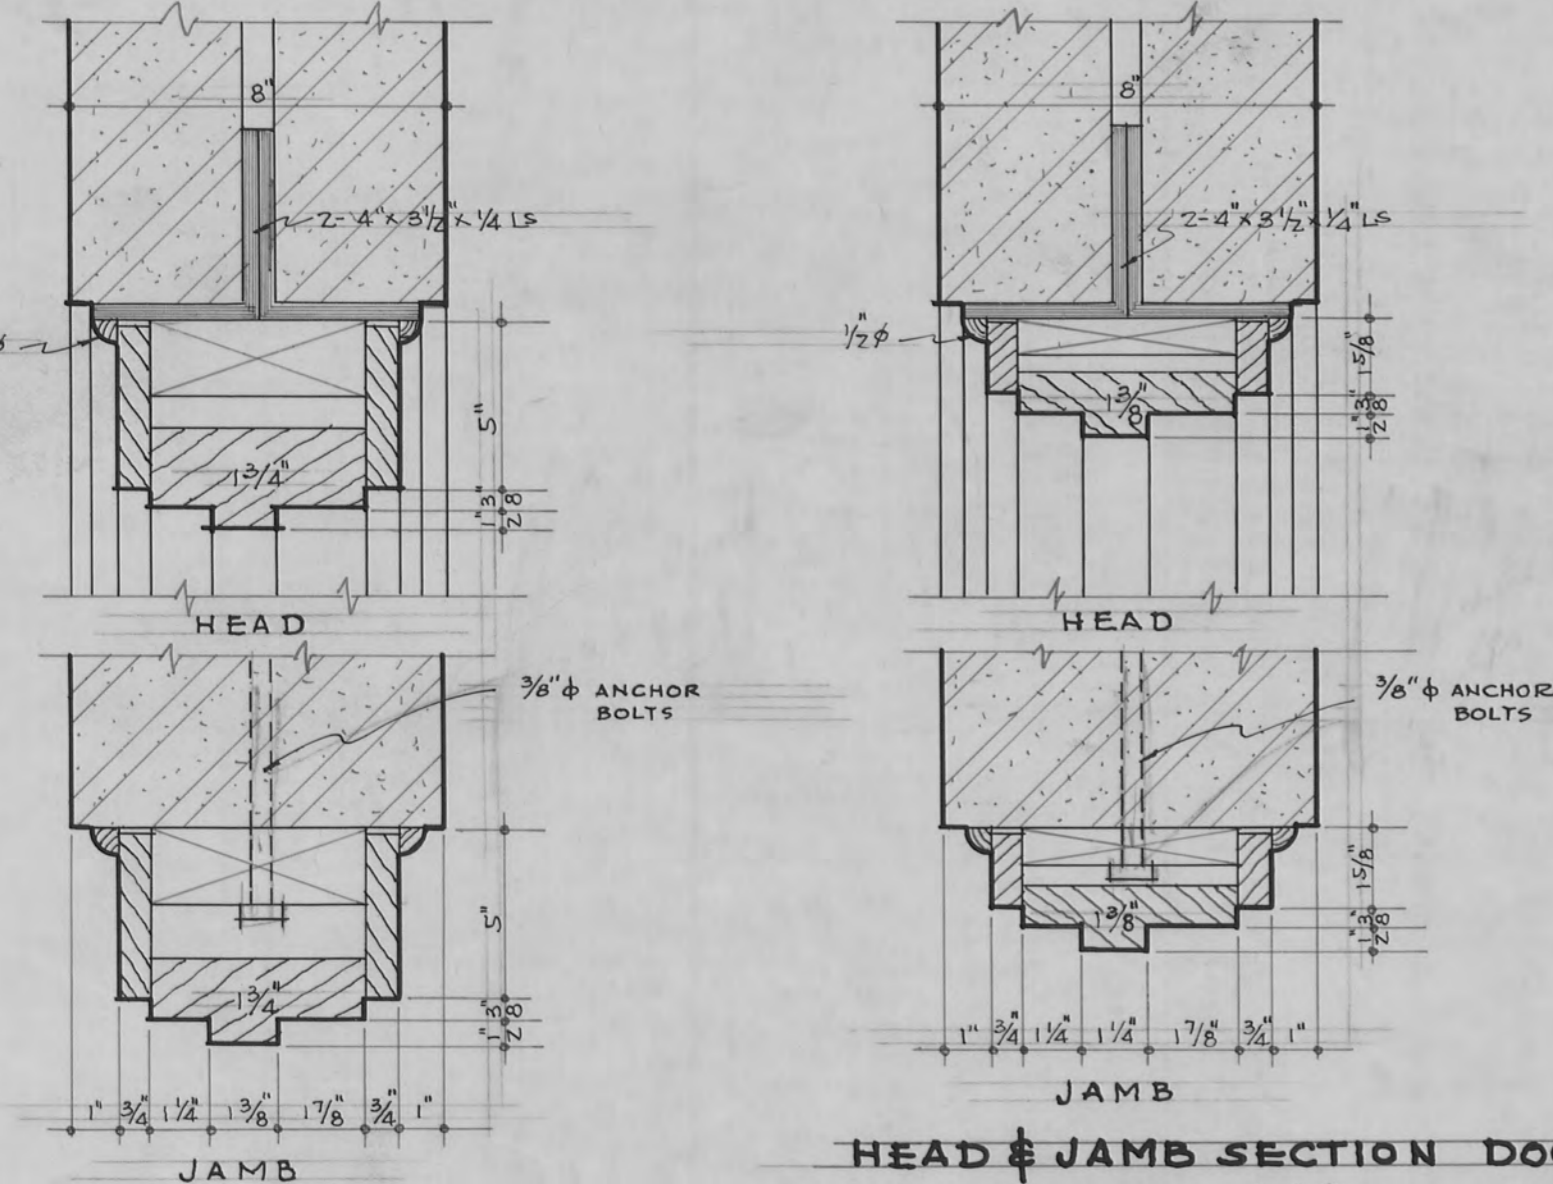

HEAD PANEL & JAMB SECTIONS DOOR #101
SCALE 3" = 1'-0"

HEAD & JAMB SECTION DOORS #103, 104, 105
SCALE 3" = 1'-0"

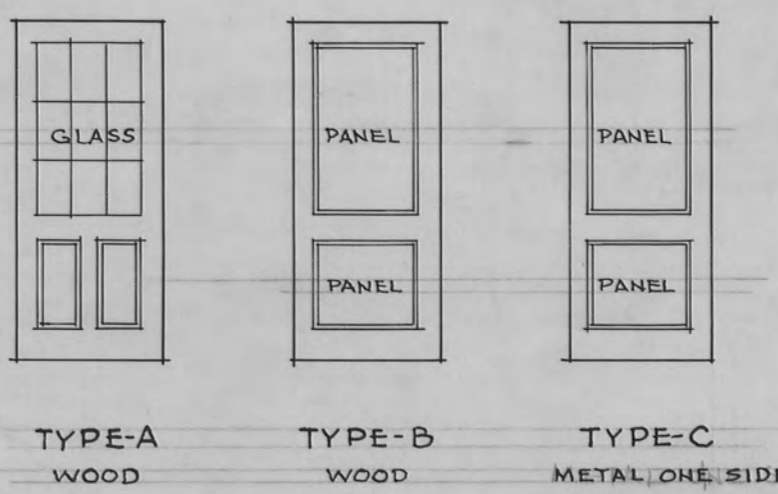

TYPE-A WOOD
TYPE-B WOOD
TYPE-C METAL, ONE SIDE

DRAWING REVISED PER FIELD SURVEY
DATE 6-19-36
CONTRACT NO. DA-11-173-ORD-65
TRYGVE HOFF & ASSOCIATES
REV. BY H.C. CH'D BY F.H.M.
See Gen. Plan 6988-326A

THE JENNINGS-LAWRENCE CO.
ARCHITECT-ENGINEER
COLUMBUS, O. - RAVENNA, O.

CONSTRUCTION DIVISION
OFFICE OF THE QUARTERMASTER GENERAL

PORTAGE ORDNANCE DEPOT
BOLTON BARN AREA
FILLING STATION

SCALE AS NOTED

REVISIONS
A TRACED ORIG. DRAWING WITH CORRS. AS BUILT 3/23/42
B BUILDING PER 1/2/44

REVISION NO. B APPROVED BY -
L. H. EATON, PLANT ENGINEER
C. H. WILLISTON, ASS'T. GENERAL MANAGER
C. W. MELDRUM, LT. COL. ORD. DEPT. COMMANDING

DRAWN BY ELS
CHECKED BY S.N.R.
APPROVED BY R. S. CHAVIN/S
DIRECTION COL. ORD. DEPT.

DATE 10-30-41
PLAN NUMBER 6988-522

BUILDING No. A-6