




WEST ELEVATION

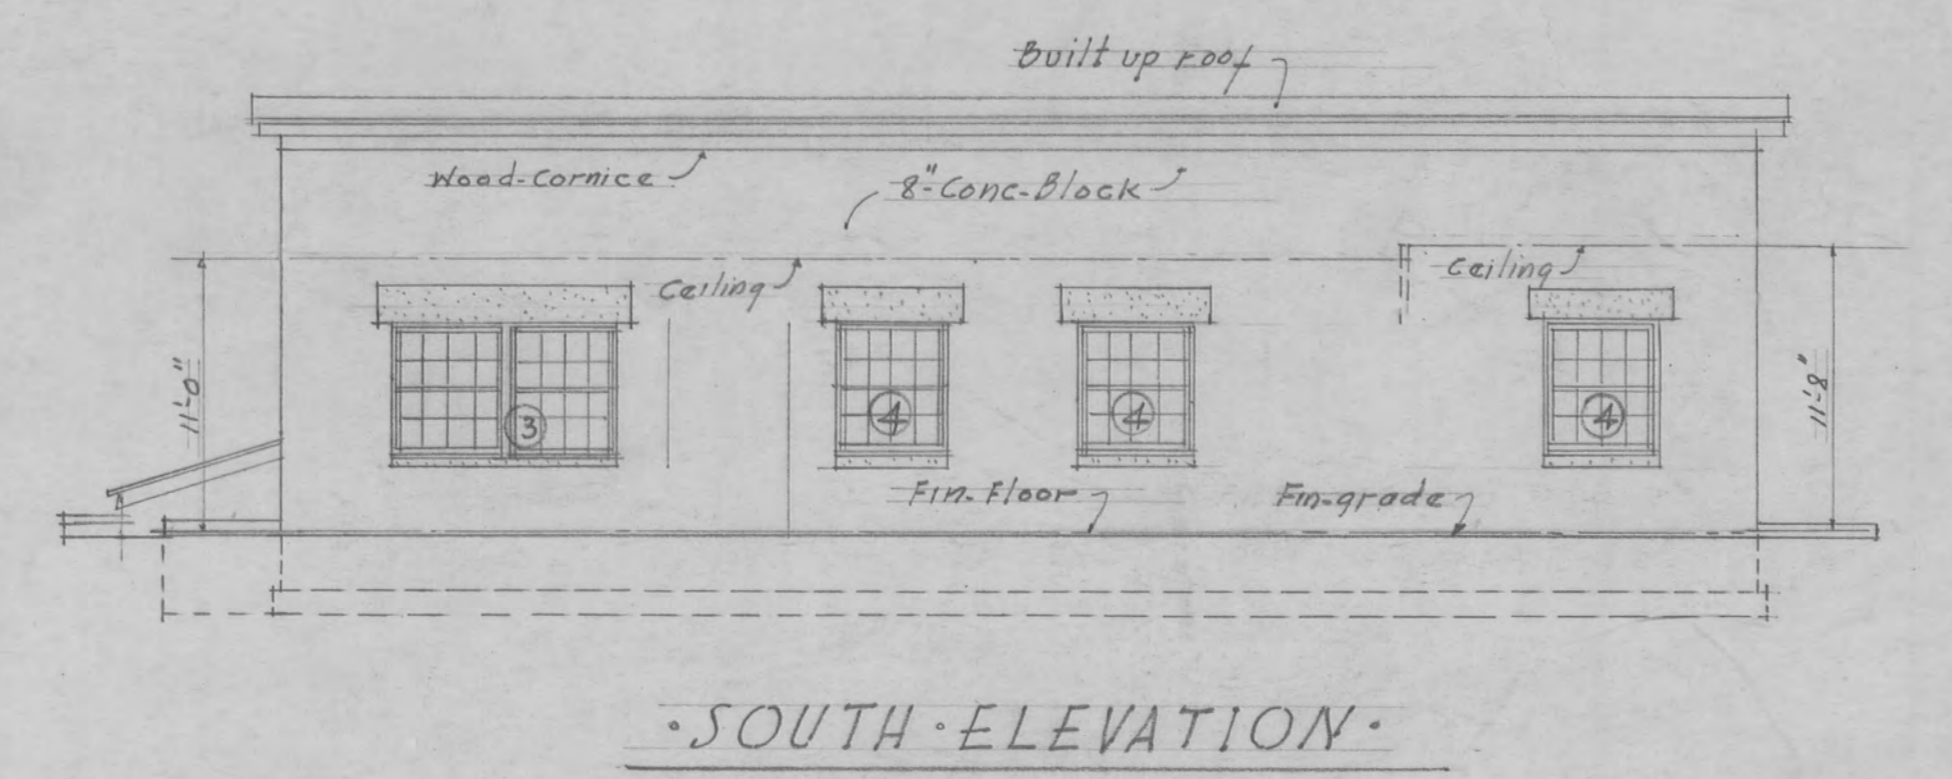

SOUTH ELEVATION

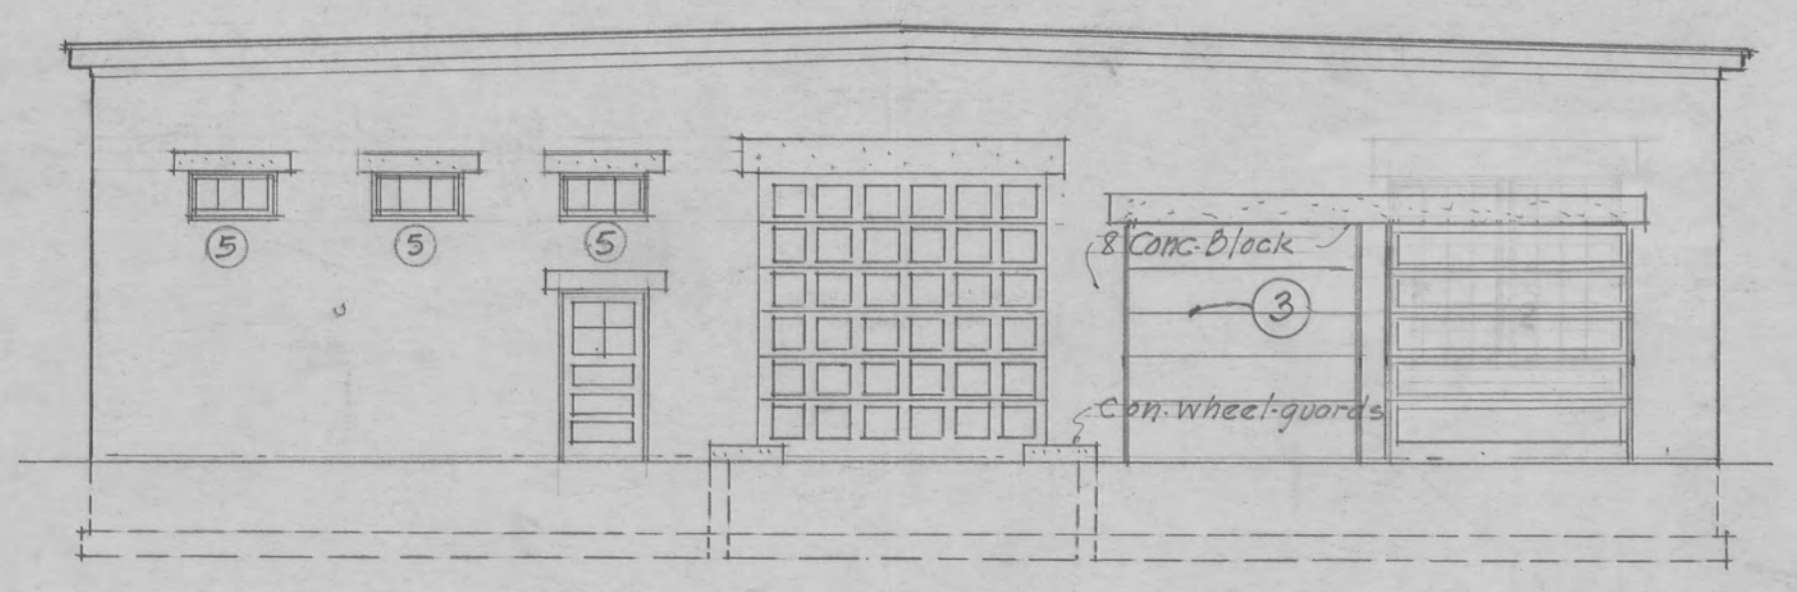


EAST ELEVATION

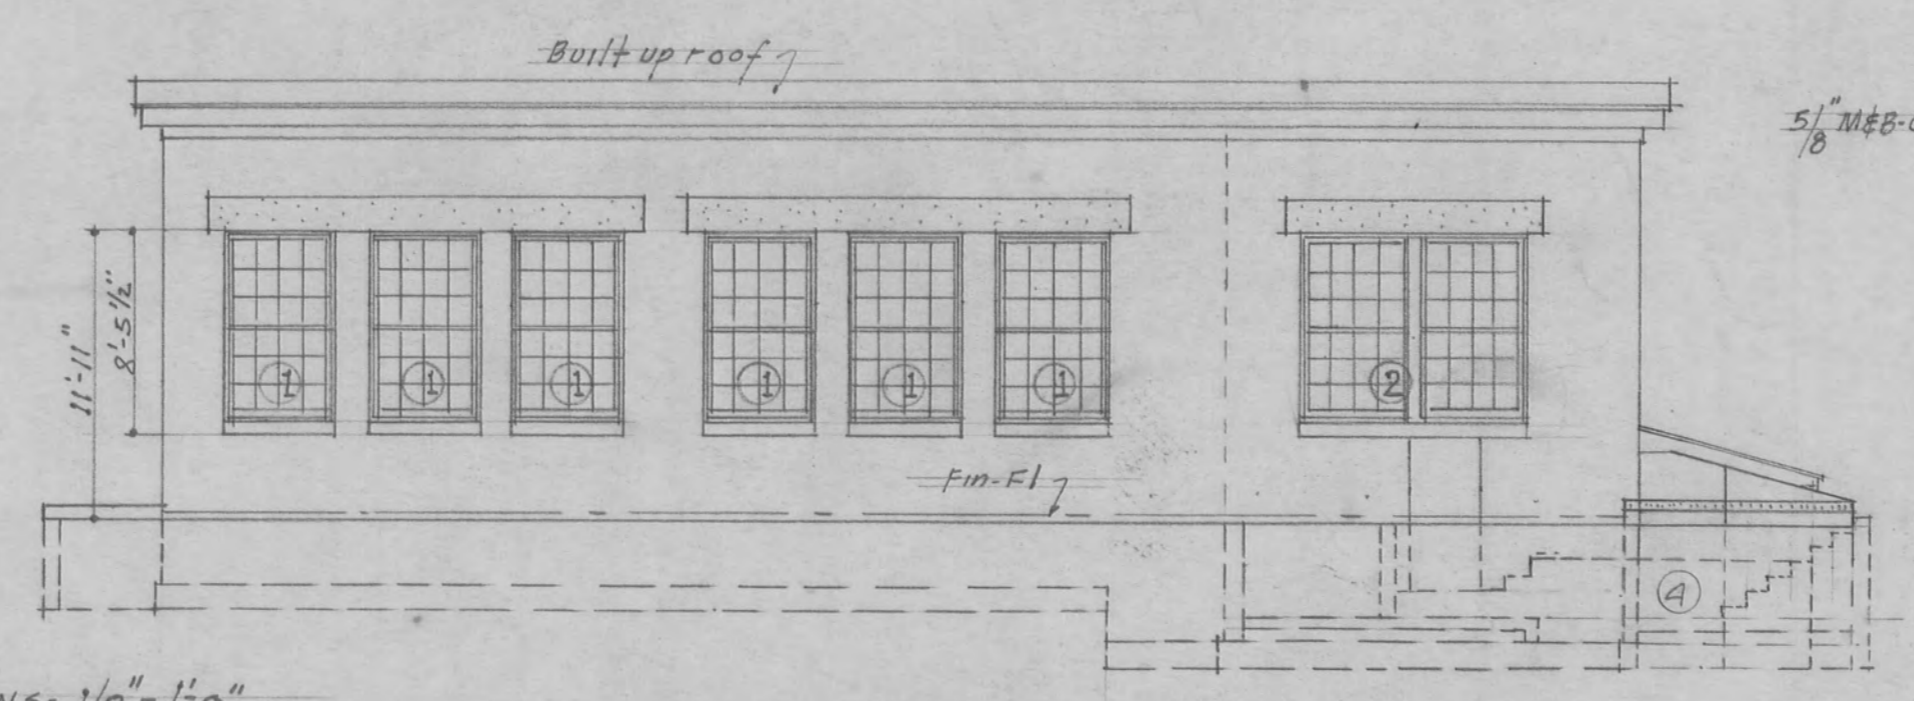

NORTH ELEVATION

Scale of ELEVATIONS - 1/8" = 1'-0"  
See Sheet C-58 for Fin. Elevations.

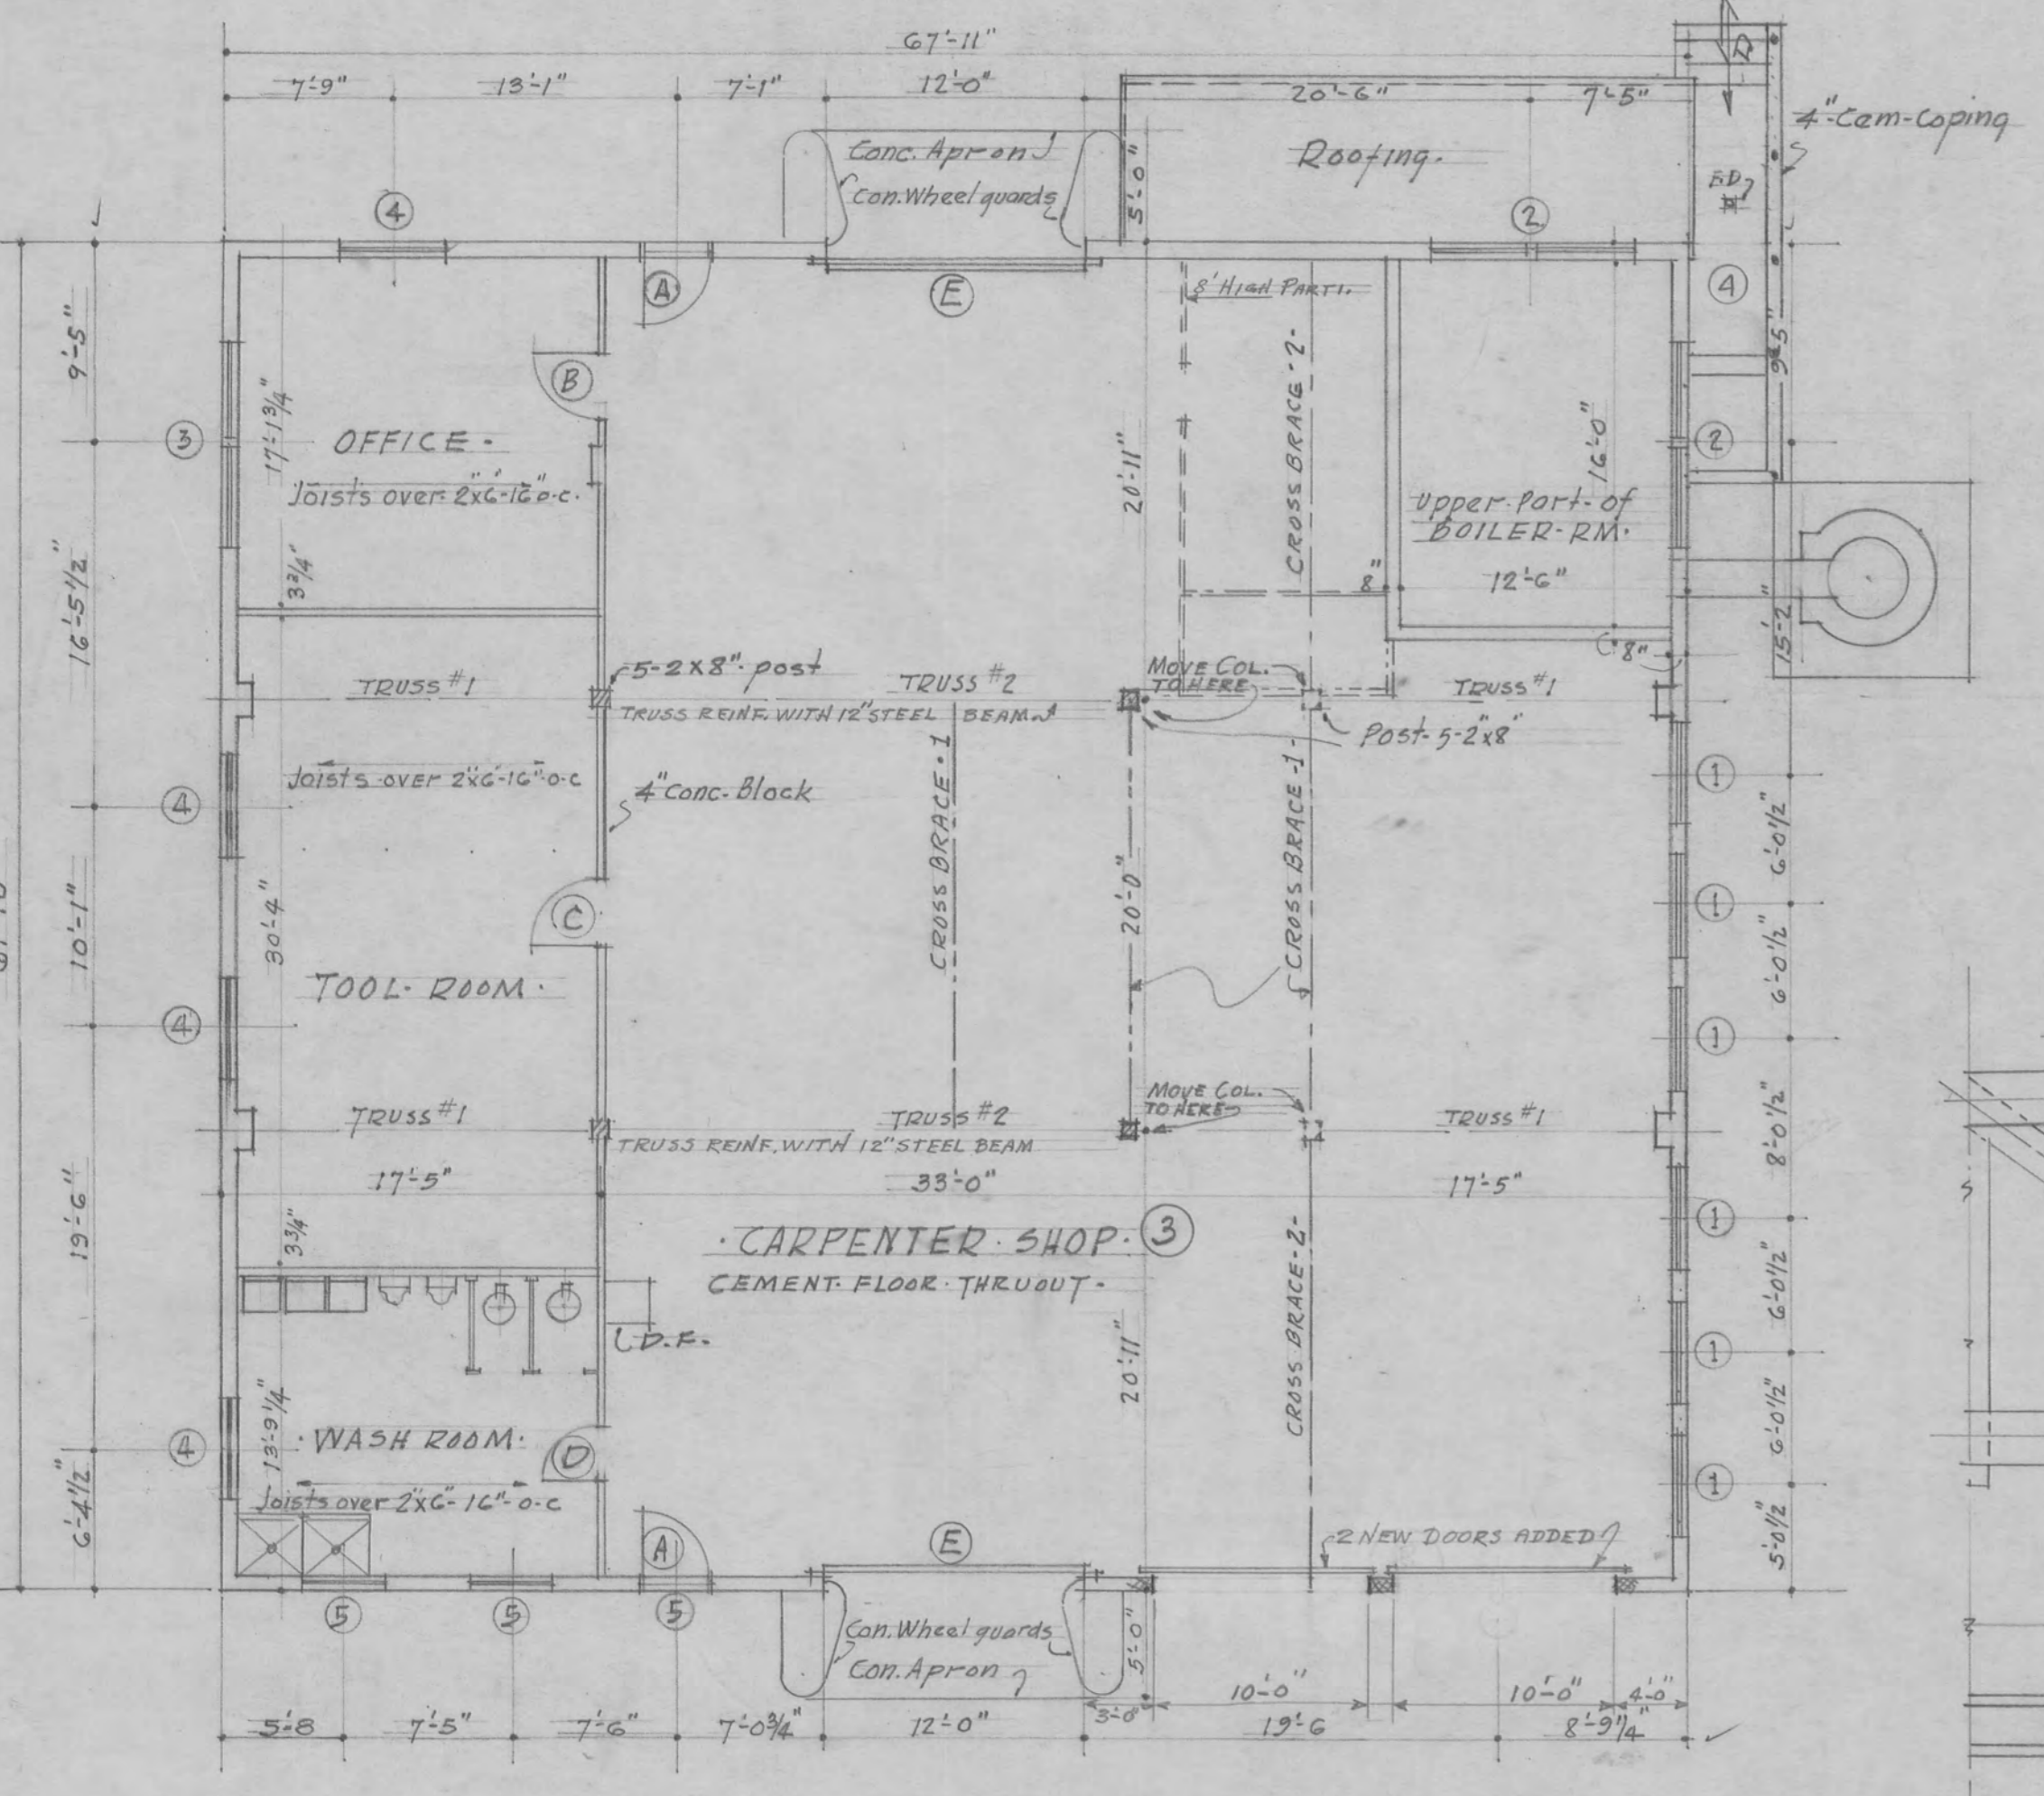

FLOOR PLAN



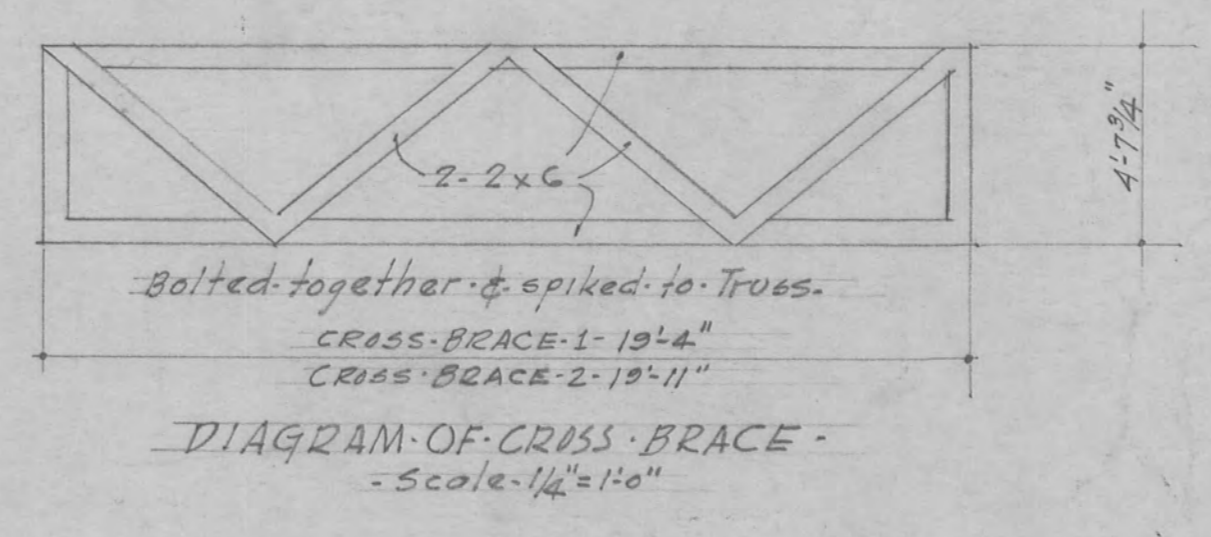


DIAGRAM OF CRUSS BRACE

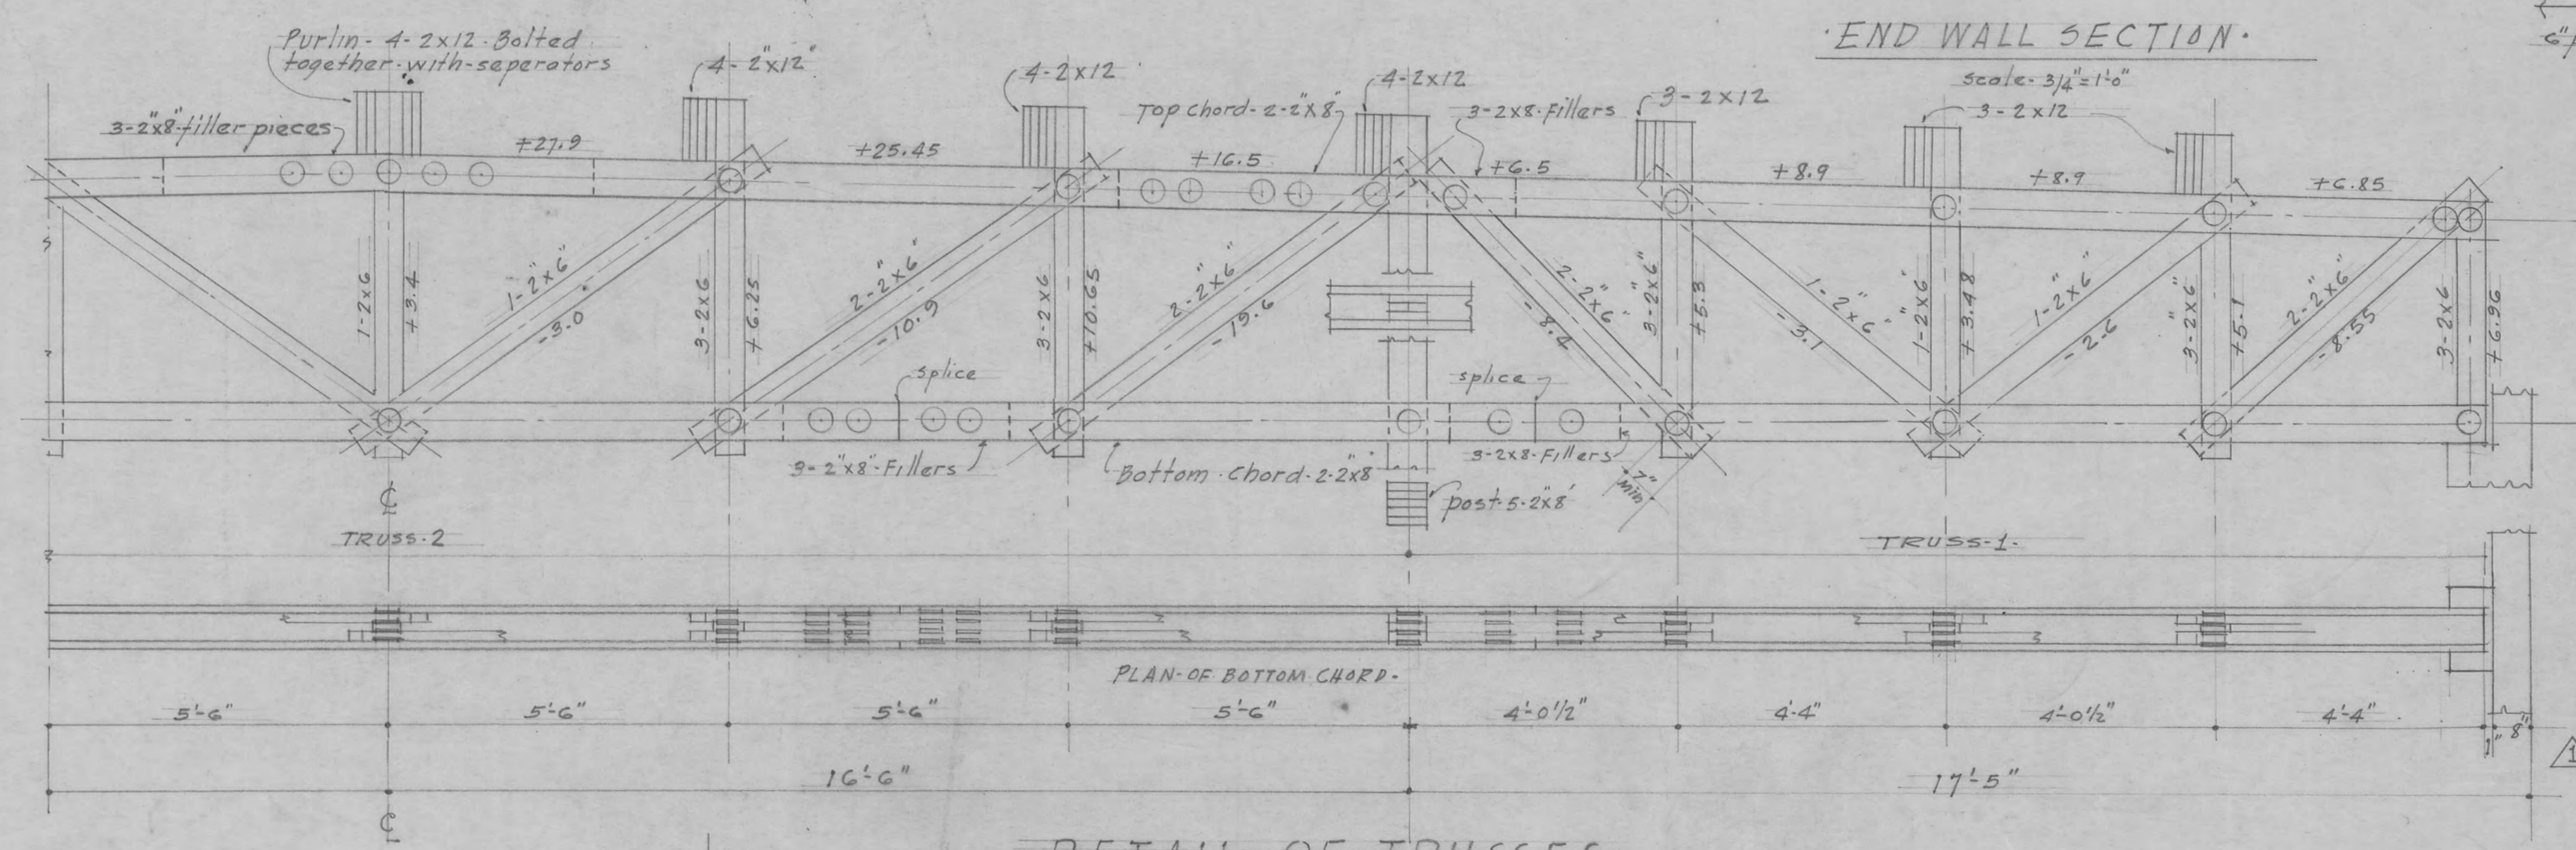

DETAIL OF TRUSSES

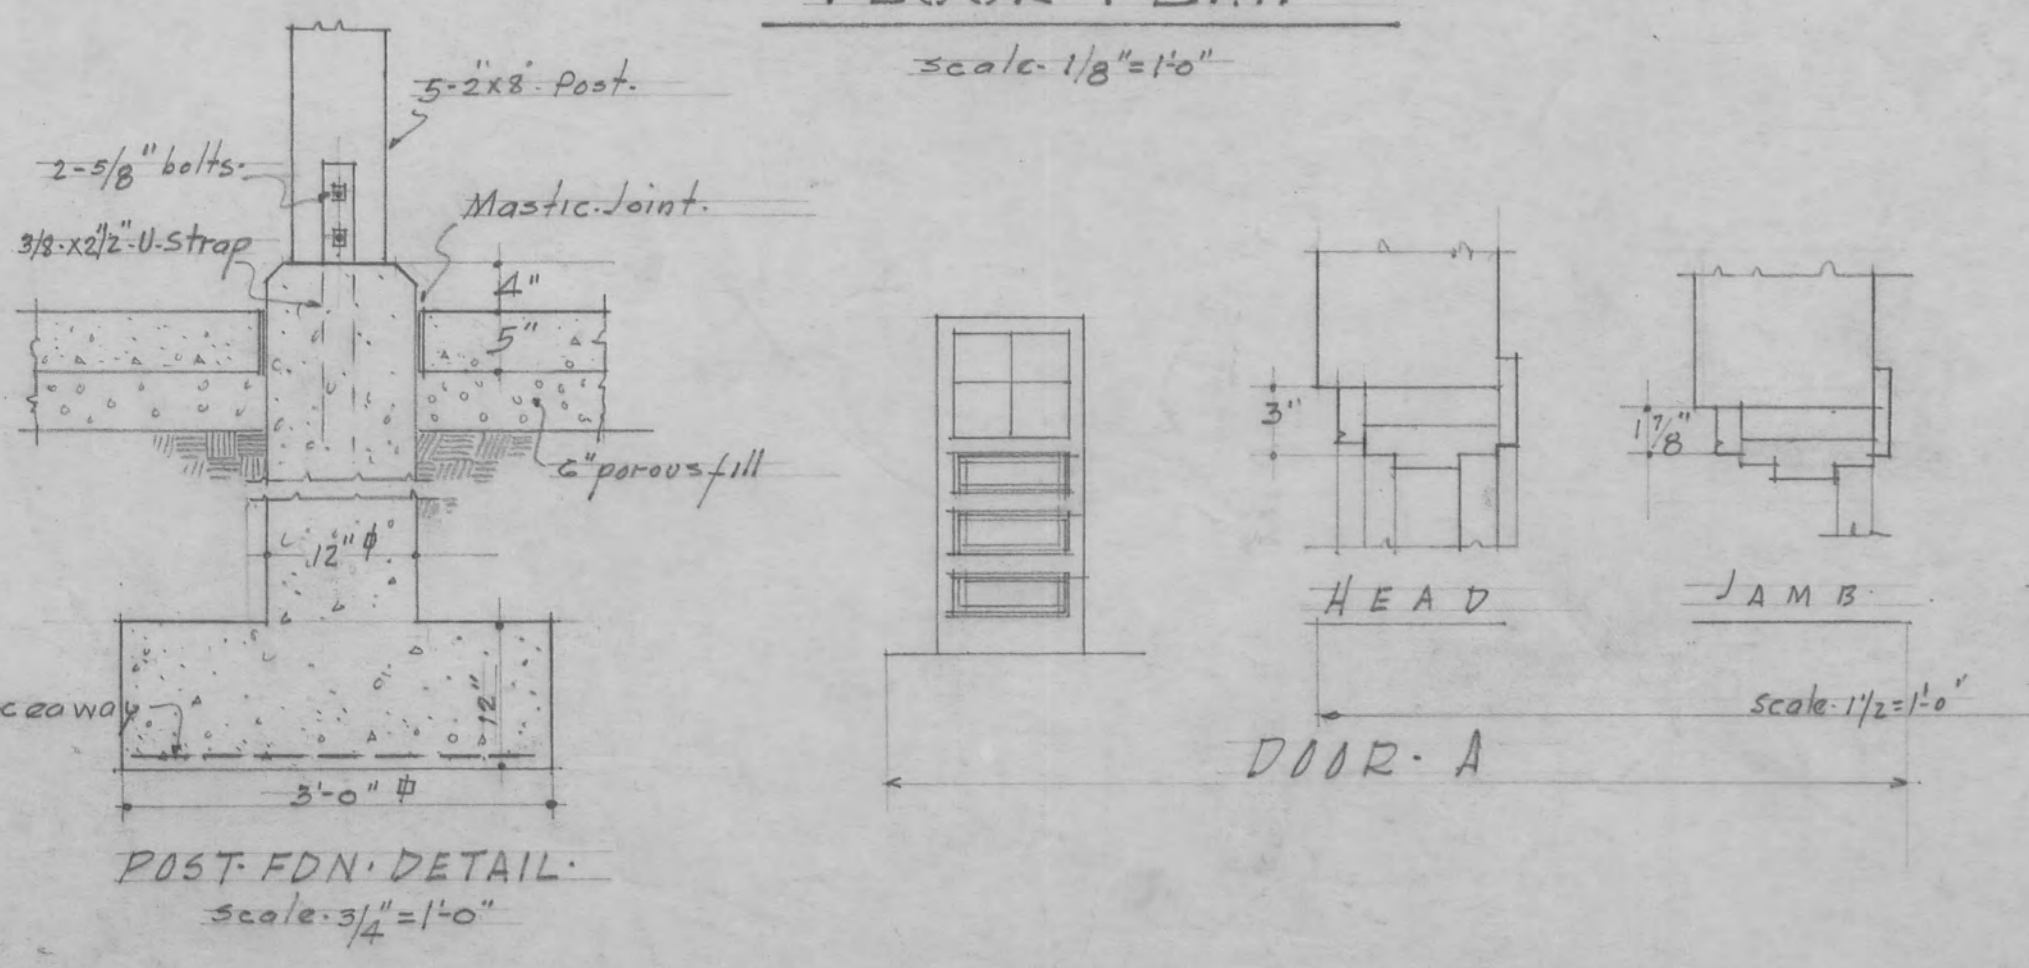

POST-FDN. DETAIL

NOTE: FILE ALB-14 = New No 6988, 610-1  
By T.H. & Assoc. 7-20-56

DOOR SCHEDULE

MK.	SIZE	REMARKS
A	3/8 x 7/8 x 1 3/4	WIRE PL. GLASS PANEL
B	3/8 x 7/8 x 1 3/4	2-PANEL WOOD
C	3/8 x 7/8 x 1 3/4	DUTCH-DOOR
D	2 1/2 x 7/8 x 1 3/4	2-PANEL WOOD
E	12 x 12 x 1 3/4	OVERHEAD-4-WIRE PL. GLASS PANELS


WINDOW SCHEDULE

MK.	SIZE	REMARKS
1	4-5/4 x 7-6 3/4 x 1 3/4	WOOD-WIRE PL. OBS. GL. DOUBLE HUNG
2	9-2 1/4 x 7-6 3/4 x 1 3/4	" TWIN "
3	9-2 1/4 x 5-1 3/4 x 1 3/4	" " "
4	4-5/4 x 6-1 3/4 x 1 3/4	WOOD-WIRE PL. GLASS DOUBLE HUNG
5	3'-4" x 1'-8" x 1 3/4	" SINGLE SASH BOTT. HINGED OPEN IN

TOILET PARTITION DETAILS

END WALL SECTION

SIDE WALL SECTION

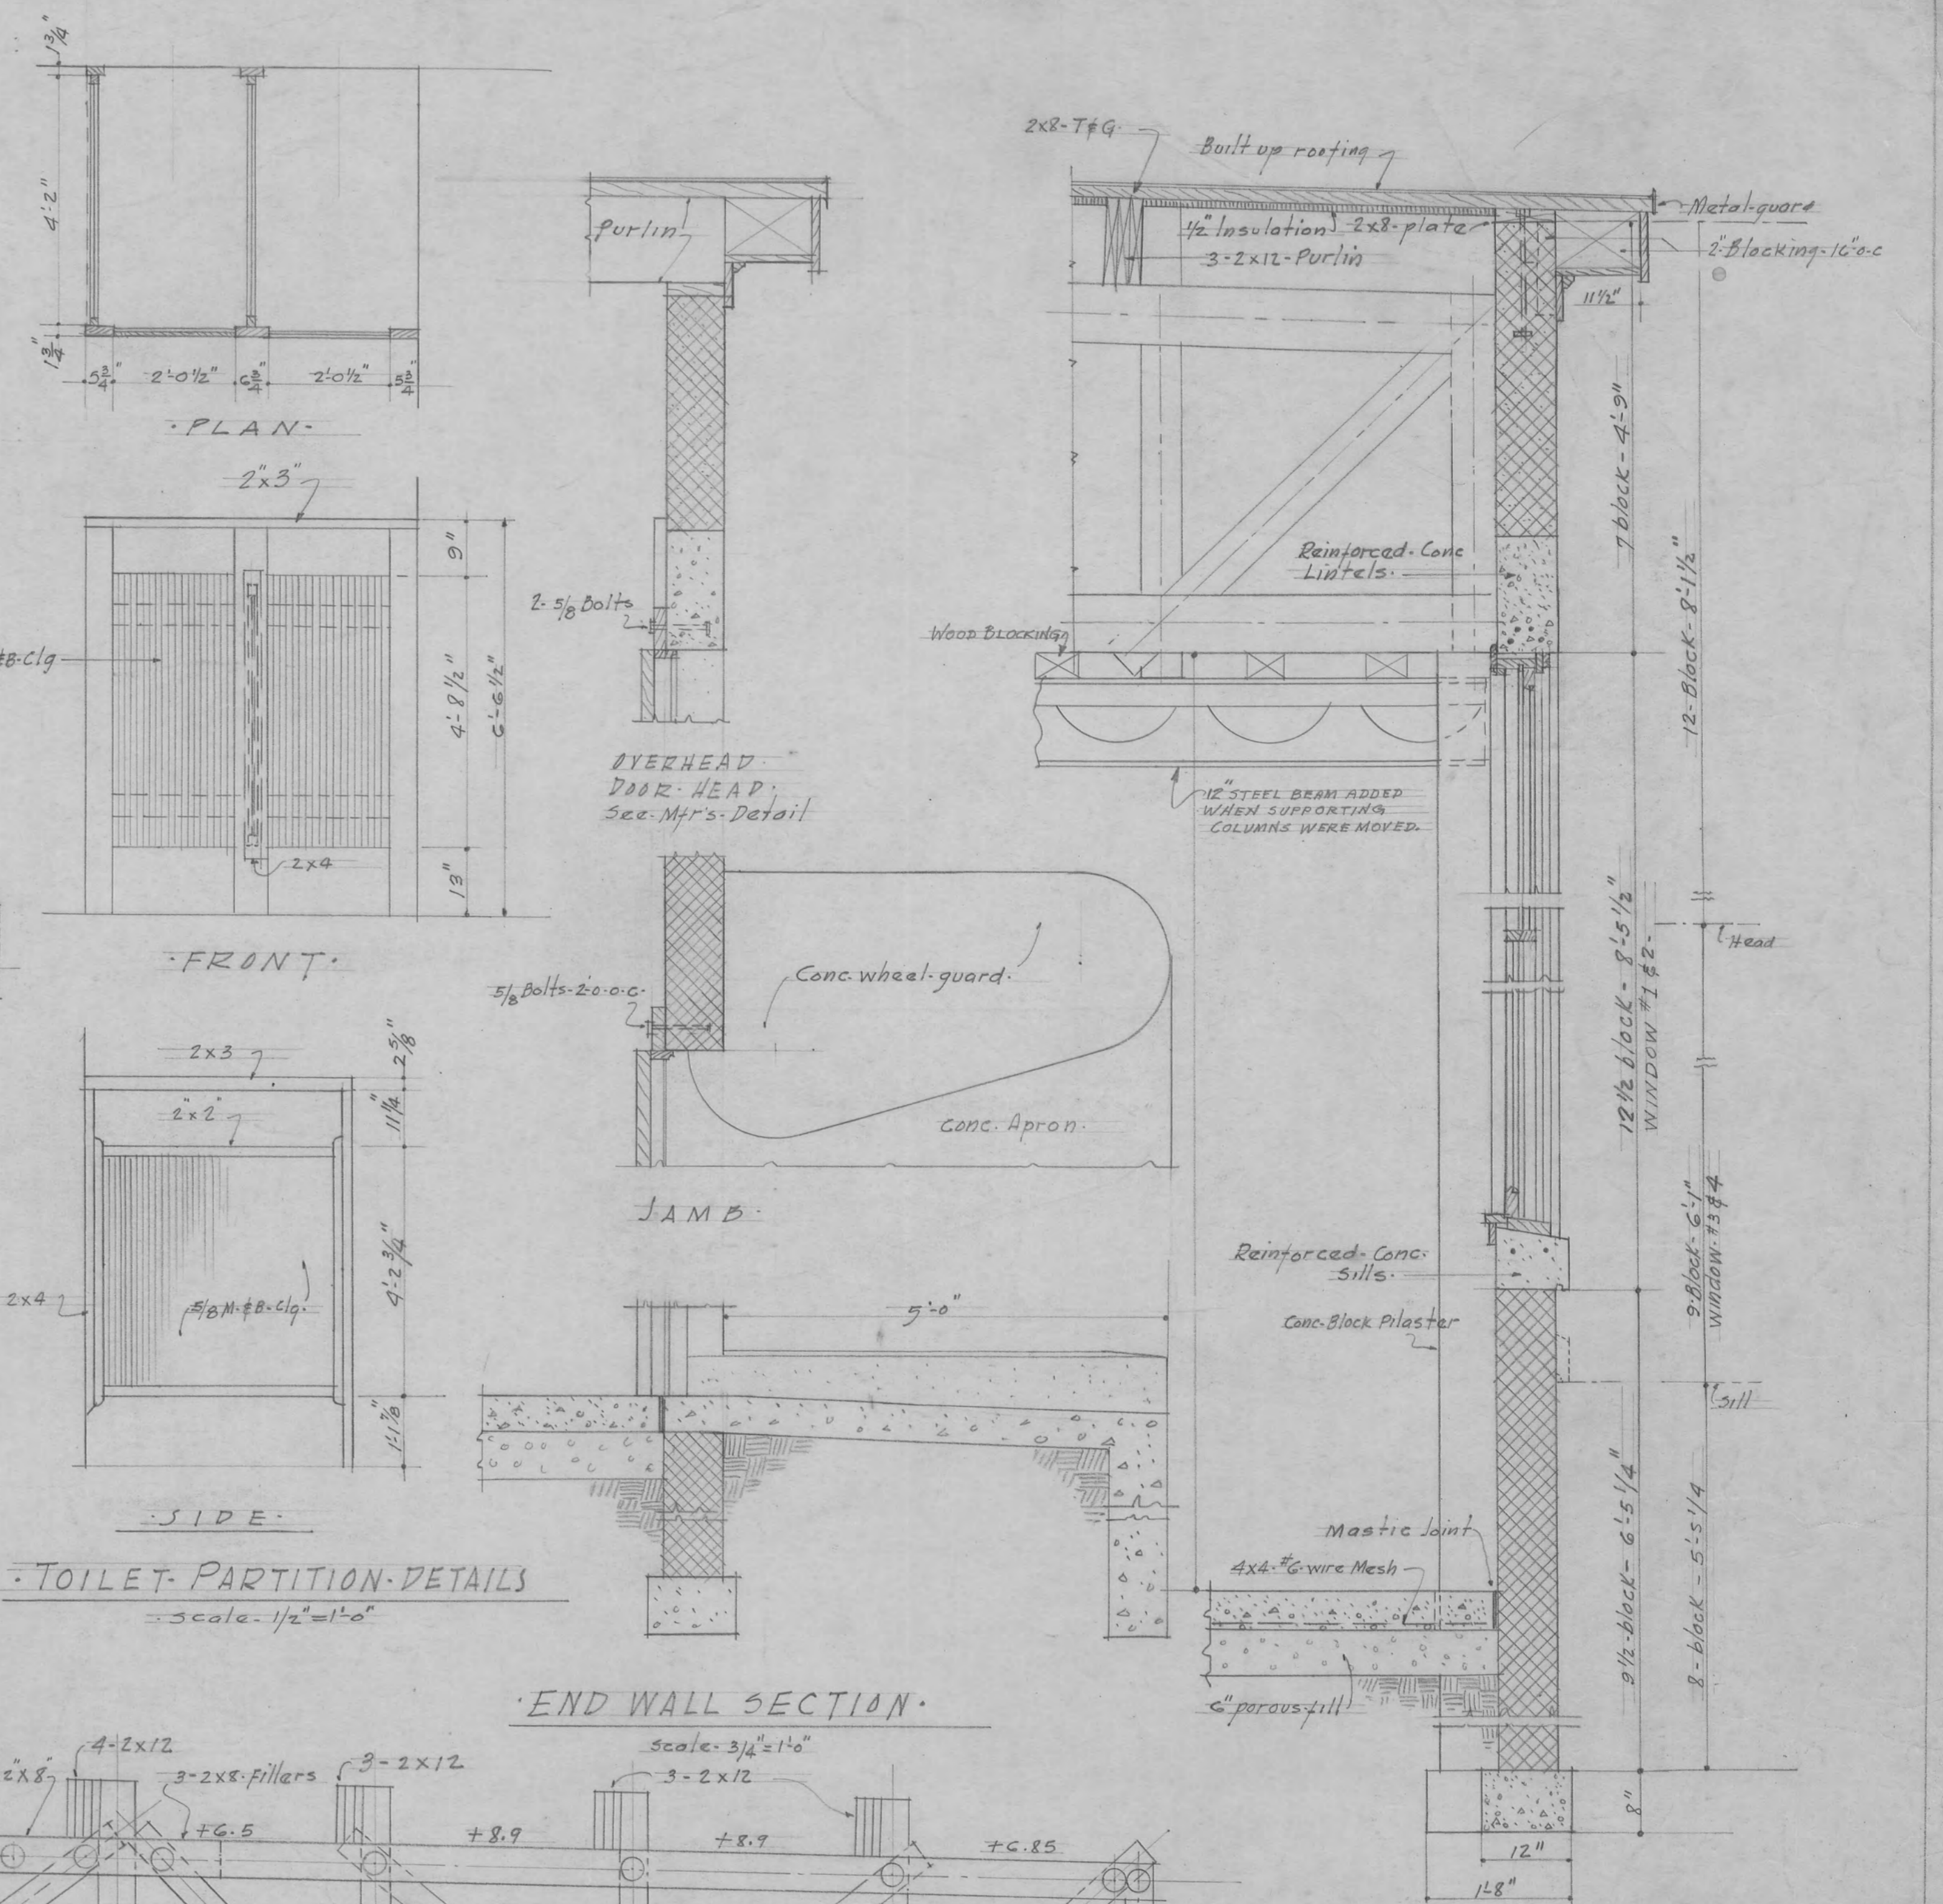

REVISIONS NO. 2 AND 3 APPROVED BY -  
L. H. EATON - PLANT ENGINEER  
C. H. WILLISTON - ASS'T. GEN'L. MGR.  
C. W. MELDRUM - LT. COL. ORD. DEPT. COMMANDING

NOTE: THIS DRAWING SHOWS BUILDING AS BUILT & SUPERCEDES DRAWING ALB-13

THE JENNINGS-LAWRENCE CO.  
ARCHITECT-ENGINEER  
COLUMBUS, OHIO      RAVENNA, OHIO

CONSTRUCTION DIVISION  
OFFICE OF THE CHIEF OF ENGINEERS

PORTAGE ORDNANCE DEPOT  
CARPENTER SHOP  
PLANS ELEVATIONS AND DETAILS

DRAWING REVISED PER FIELD SURVEY  
DATE July 20, 1956  
CONTRACT NO. DA-11-173-ORD-65  
TRYGVE HOFF & ASSOCIATES  
REV. BY K.G. CHK'D BY E.N.M.  
See Gen. Plan 6988-326A

REVISIONS	DATE	BY	APPROVED BY
1	4-9-53	JBW	
2	5-15-53	JBW	
3	7-20-56	JBW	
4			

DRAWN BY: JBW  
CHECKED BY: JBW  
APPROVED BY: F.E. Smith  
DATE: 7-1-57  
PLAN NUMBER: 6988-610  
CAPT. C. OF E. AREA ENGR.