

APPENDIX D
MONITORING WELL INSTALLATION LOGS



**Load Line 1 Phase II RI
Monitoring Well Installation Logs**

LL1-MW-78 D-3
LL1-MW-79 D-9
LL1-MW-80 D-15
LL1-MW-81 D-21
LL1-MW-82 D-27
LL1-MW-83 D-33
LL1-MW-84 D-39
LL1-MW-85 D-45

THIS PAGE INTENTIONALLY LEFT BLANK


Monitoring Well Installation Logs

THIS PAGE INTENTIONALLY LEFT BLANK

60

HTRW DRILLING LOG		DISTRICT Louisville		HOLE NUMBER LL1-MW-78	
1. COMPANY NAME SAIC		2. DRILL SUBCONTRACTOR Miller Drilling Co.		SHEET SHEETS 1 OF 5	
3. PROJECT RVAAP, LLI, Phase II RI			4. LOCATION RVAAP, LLI, Ravenna, Ohio.		
5. NAME OF DRILLER P. Brown			6. MANUFACTURERS DESIGNATION OF DRILL CME-75		
7. SIZES AND TYPES OF DRILLING AND SAMPLING EQUIPMENT 4 1/4" ID HSA, 2" split spurs, 3" Shelby Tube, 6" Tricone roller bit, Sullivan D375Q air compressor w/ oil/air separator		8. HOLE LOCATION See sketch below		9. SURFACE ELEVATION	
12. OVERBURDEN THICKNESS 4.4 BGS		10. DATE STARTED 8/13/02 8/24/02		11. DATE COMPLETED 8/25/02 8/25/02	
13. DEPTH DRILLED INTO ROCK 39.6' (From 4'-4 1/2' BGS)		15. DEPTH GROUNDWATER ENCOUNTERED Wet cutting & water in borehole @ ~34' BGS		16. DEPTH TO WATER AND ELAPSED TIME AFTER DRILLING COMPLETED 31.20' BGS after 15 1/2 hrs.	
14. TOTAL DEPTH OF HOLE 44.0' BGS		17. OTHER WATER LEVEL MEASUREMENTS (SPECIFY)		19. TOTAL NUMBER OF CORE BOXES N/A	
18. GEOTECHNICAL SAMPLES N/A		DISTURBED N/A		UNDISTURBED N/A	
20. SAMPLES FOR CHEMICAL ANALYSIS N/A		VOC N/A		METALS N/A	
22. DISPOSITION OF HOLE set monitoring well		BACKFILLED N/A		MONITORING WELL 2" PVC	
				OTHER (SPECIFY) N/A	
				OTHER (SPECIFY) N/A	
				OTHER (SPECIFY) N/A	
				21. TOTAL CORE RECOVERY N/A	
				23. SIGNATURE OF INSPECTOR Matthew B. Vest	

LOCATION SKETCH/COMMENTS N 564623.871 E 2376275.854 SCALE: NOT TO SCALE

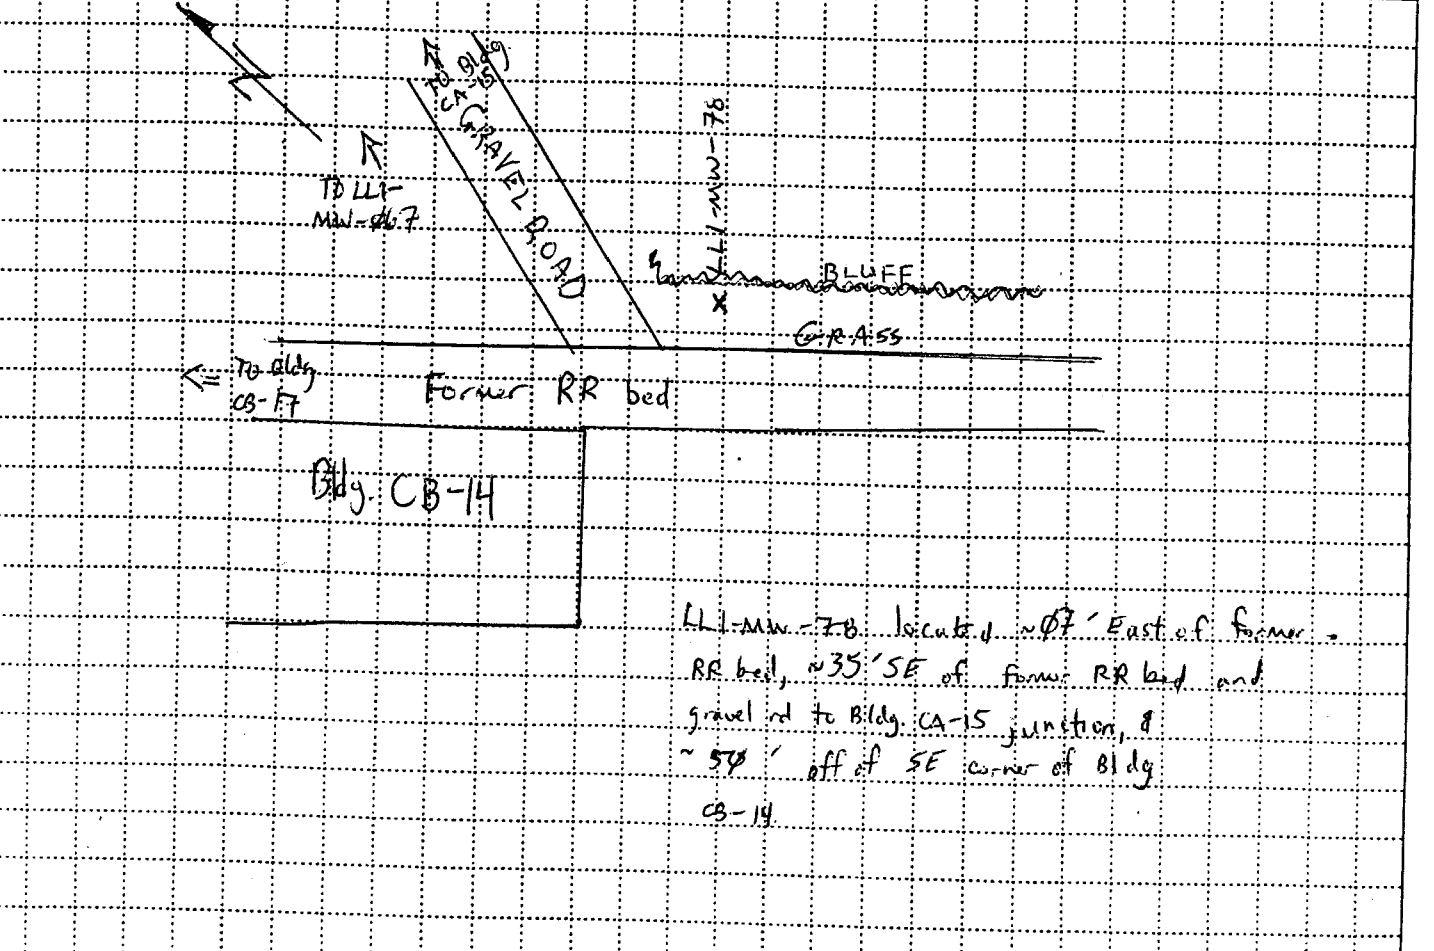

PROJECT RVAAP, LLI, Phase II RI		HOLE NO LL1-MW-78	
------------------------------------	--	----------------------	--

DRILLING LOG

PROJECT: RVAAP LLI, Phase II, RI

INSPECTOR: M. Vest

WELL NUMBER: LLI-MW-78
SHEET: 2 of 5

61

DEPTH (ft)	DESCRIPTION OF MATERIALS (C)	FIELD SCREENING RESULTS (D)	GEOLOGIC SAMPLE OR CORE BOX NO (E)	ANALYTICAL SAMPLE NO (F)	REMARKS (G)
0.0 - 0.4	GRAVEL & Topsoil	φ φ ppm	n/a	n/a	Could not drive/push split spinn/shell by Tube past 0.4' BGS. Auger refusal @ 1.0' BGS.
0.4 - 1.0	Not Sampled				
1.0 - 1.8	Auger Refusal @ 1.0'				
1.8 - 2.4	Sandstone, f-m. gr, 7/8 light gray, dry.				Begin air rotary drilling @ 1.8' BGS
2.4 - 3.0		φ φ ppm	n/a	n/a	Driller says sandstone. Reels weathered when drilling it.
3.0 - 4.0					Rock descriptions logged w/ cuttings from air rotary. Depths are not exact to 1/16 ft due to delay in some cuttings return.
4.0 - 5.0					Air rotary advancing @ 1/2' per 10 minutes.
5.0 - 6.0		φ φ ppm		n/a	until ~ 9.5' BGS.
6.0 - 7.0					Then ~ 1' per 10 min.
7.0 - 8.0		φ φ ppm	n/a	n/a	
8.0 - 9.5	Shale, 4/16 d. greenish gray. v. wea., dense, damp.				
9.5 - 10.0	Sandstone, f-m. gr. 7/8 lt. gray, dry.	φ φ ppm		n/a	

PROJECT: RVAAP, LLI, Phase II RI D-4

WELL NO: LLI-MW-78

DRILLING LOG

PROJECT		INSPECTOR			HOLE NUMBER	
RVAAP, LLI, Phase II, RJ		M. West			LLI-MW-78	
ELEV. (A)	DEPTH (B)	DESCRIPTION OF MATERIALS (C)	FIELD SCREENING RESULTS (D)	GEOCHEM. SAMPLE OR CORE BOX NO. (E)	ANALYTICAL SAMPLE NO. (F)	REMARKS (G)
	11.0	Sandstone, f-m gr., 7 1/2 lt. gray, dry.	φ. φ ppm	N/A	N/A	Air rotary rate still @ ~1" per 10 minutes.
	12.0	12.0'				
	13.0	Sandstone, f-m gr., 2.54 1/2 lt. brownish gray dry.	φ. φ ppm	N/A	N/A	Driller says weathered drilling ceased @ = 12' BGS. Below this drilling feels as if rock is more competent. No change in cuttings.
	14.0					
	15.0		φ. φ ppm	N/A	N/A	
	16.0					
	17.0					
	18.0		φ. φ ppm	N/A	N/A	
	19.0					
	20.0		φ. φ ppm	N/A	N/A	

63

DRILLING LOG

43

PROJECT **LLI, RVAMP, Phase II RI** INSPECTOR **M. Vest** INSTRUMENT **1-MW-78**
 SHEET **4 of 5**

DEPTH (A)	DEPTH (B)	DESCRIPTION OF MATERIALS (C)	FIELD SCREENING RESULTS (D)	GEOLOGIC SAMPLE OR CORE BOX NO (E)	ANALYTICAL SAMPLE NO (F)	REMARKS (G)
		Sandstone, from 577 The next gray, dry, dusts 2.5 ft. brownish gray, dry.	φ. φ ppm	N/A	N/A	Air rotary drilling rate ~ 1 ft/min
21.1						
	22.4					
			φ. φ ppm	N/A	N/A	
23.9						
	24.6					
			φ. φ ppm		N/A	
25.0						
	26.4					
			φ. φ ppm	N/A	N/A	
27.9						
	28.2					
			φ. φ ppm	N/A	N/A	
29.8						
	30.0		φ. φ ppm		N/A	

PROJECT **RVAMP, LLI, Phase II RI**

D-6

HOLE NO **LLI-MW-78**

DRILLING LOG

PROJECT

RVAAP, LLI, Phase II RI

INSPECTOR M. Vest

HOLE NUMBER

LLI-MW-78

SHEET 5 of 5

W

DEPTH (ft)	DEPTH (ft)	DESCRIPTION OF MATERIALS (C)	FIELD SCREENING RESULTS (D)	GEOLOGIC SAMPLE OR CORE BOX NO (E)	ANALYTICAL SAMPLE NO (F)	REMARKS - (G)
	31.9	Sandstone, frags. ^{frag} slight ^{dry} 2.51% lt. brownish gray.	φ. φ ppm	N/A	N/A	Air rotary drilling rate ~ 1ft/1φmin.
	32.9		φ. φ ppm	N/A	N/A	
	33.9					
	34.9	----- 34.9	φ. φ ppm	N/A	N/A	Cutting wet below ~ 34.8' BGS
	35.0	Sandstone, from 5' ^{2' 10'} H. gray, wet, 2.51% lt. brownish gray				After 15 1/2 hrs. w.l. @ 31.2 φ' BGS.
	36.0		φ. φ ppm	N/A	N/A	
	37.0					
	38.0		φ. φ ppm	N/A	N/A	
	39.0					
	40.0		φ. φ ppm	N/A	N/A	
	40.0	End drilling (air rotary) @ 40 φ' BGS.				End drilling. N 564023.871 E 2376725.854

D-7

PROJECT

LLI, Phase II, RVAAP, RI

HOLE NO

LLI-MW-78

MONITORING WELL

PROJECT NAME: Load Line 1 Phase I RI

DELIVERY ORDER NO: 003

WELL NUMBER: LLI-MW-078


BEGIN: 08/25/99

END: 08/26/99

COORDINATES: N: 564623.871
E: 2376275.854

REFERENCE POINT: TOL

ELEVATION: 995.84 MSL FT

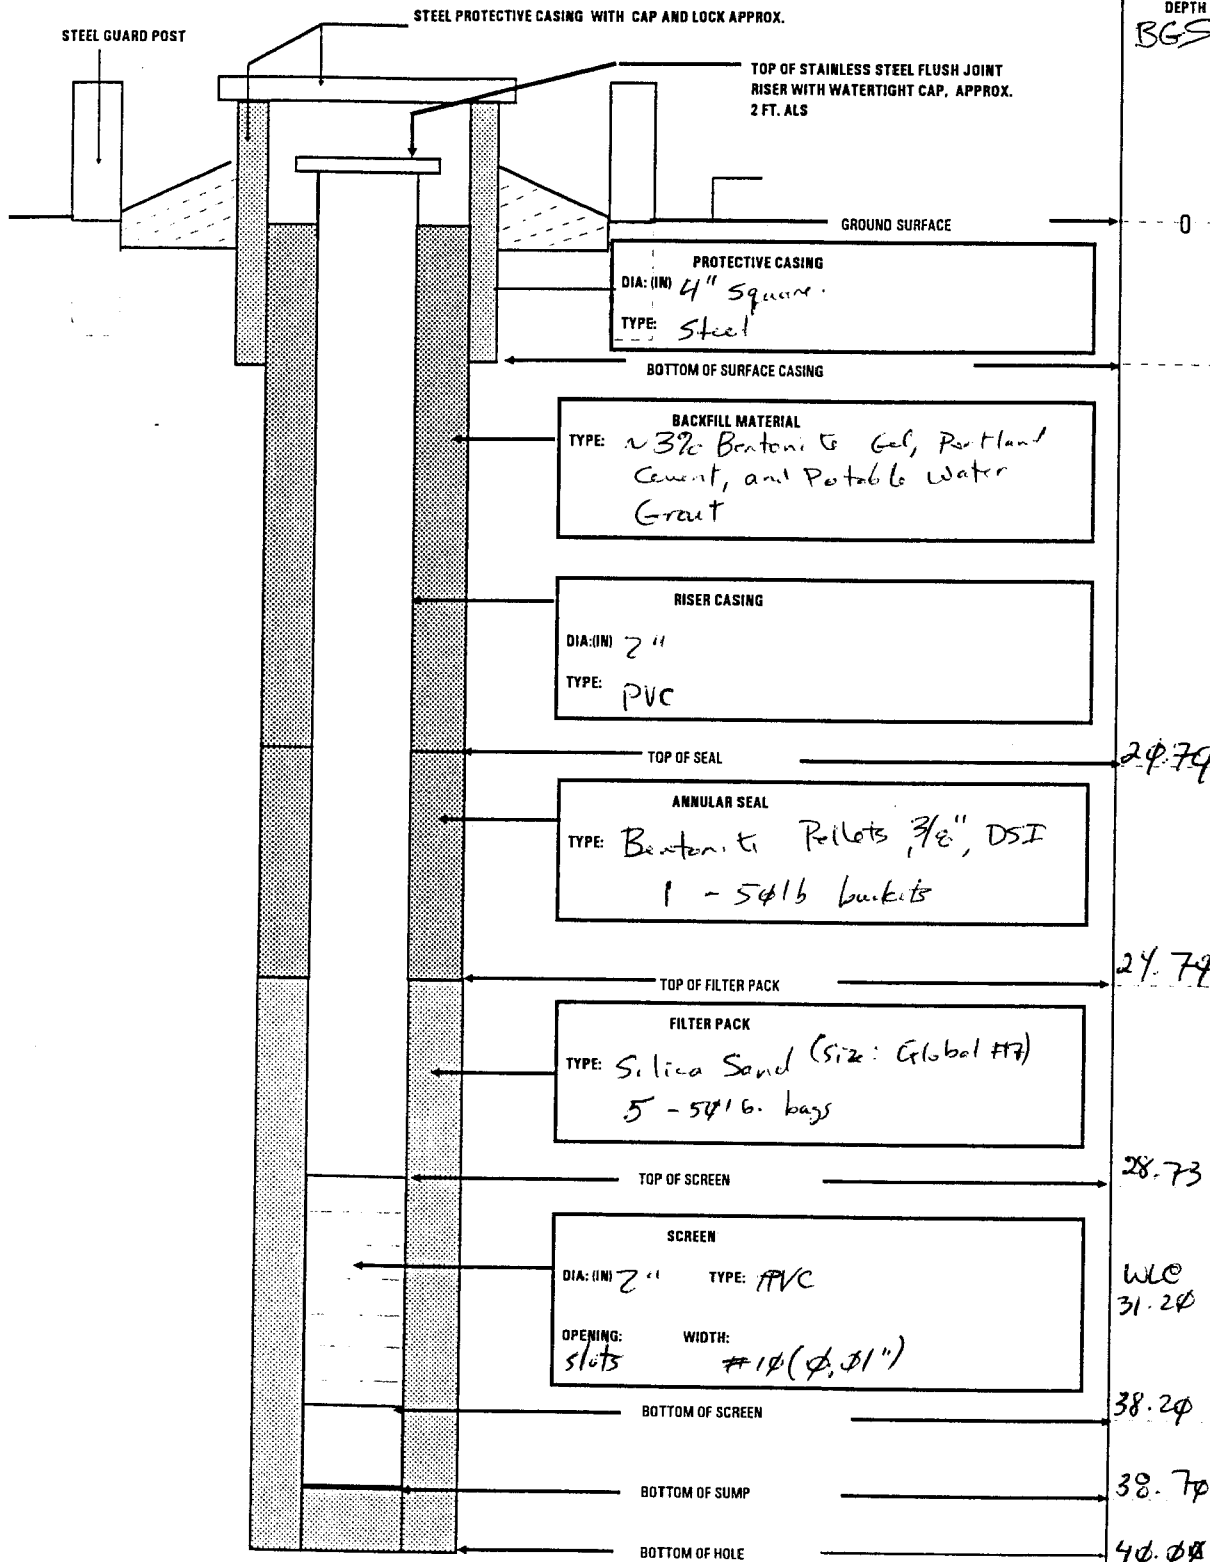

DEPTH	ELEV
BGS	
0	
24.74	
28.73	
38.24	
38.74	
40.44	


HOLE DIA: (IN) 7" D-8

WLC
31.24

HTRW DRILLING LOG		DISTRICT Louisville		HOLE NUMBER LL1-MW-79	
1 COMPANY NAME SAIC		2 DRILL SUBCONTRACTOR Miller Drilling Co.		SHEET SHEETS 1 OF 45	
3 PROJECT RVAAP, LL1, Phase II RI			4 LOCATION RVAAP, LL1, Ravenna, Ohio		
5 NAME OF DRILLER P. Brown			6 MANUFACTURERS DESIGNATION OF DRILL CUE-75		
7 SIZES AND TYPES OF DRILLING AND SAMPLING EQUIPMENT 6 1/4" ID HSA, 3" thin walled Shelby Tube, 6" tricone roller bit, NQ wireline core barrel & bit, D375Q John Deere (Sullivan) air compressor w/ oil/air separator		8 HOLE LOCATION See Sketch Below			
12 OVERBURDEN THICKNESS 1.1' BGS over bedrock / ~3.4' BGS competent bedrock		10 DATE STARTED 08/19/99			
13 DEPTH DRILLED INTO ROCK HS Cored to 40.4', drilled to 39.5' BGS		11 DATE COMPLETED 08/29/99			
14 TOTAL DEPTH OF HOLE 40.4' BGS		15 DEPTH GROUNDWATER ENCOUNTERED Using H2O to core, could not identify where groundwater first encountered.			
18 GEOTECHNICAL SAMPLES 23 At top of Core / Shelby Tubes		DISTURBED N/A		UNDISTURBED N/A	
20 SAMPLES FOR CHEMICAL ANALYSIS None		VOC N/A		METALS N/A	
22 DISPOSITION OF HOLE monitoring well set		BACKFILLED N/A		MONITORING WELL 2" PVC	
19 TOTAL NUMBER OF CORE BOXES #8		OTHER (SPECIFY) N/A		OTHER (SPECIFY) N/A	
21 TOTAL CORE RECOVERY 90%		23. SIGNATURE OF INSPECTOR Matthew P. Lee			

LOCATION SKETCH/COMMENTS N 563739.63
E 2376228.312

SCALE: NET TO SCALE

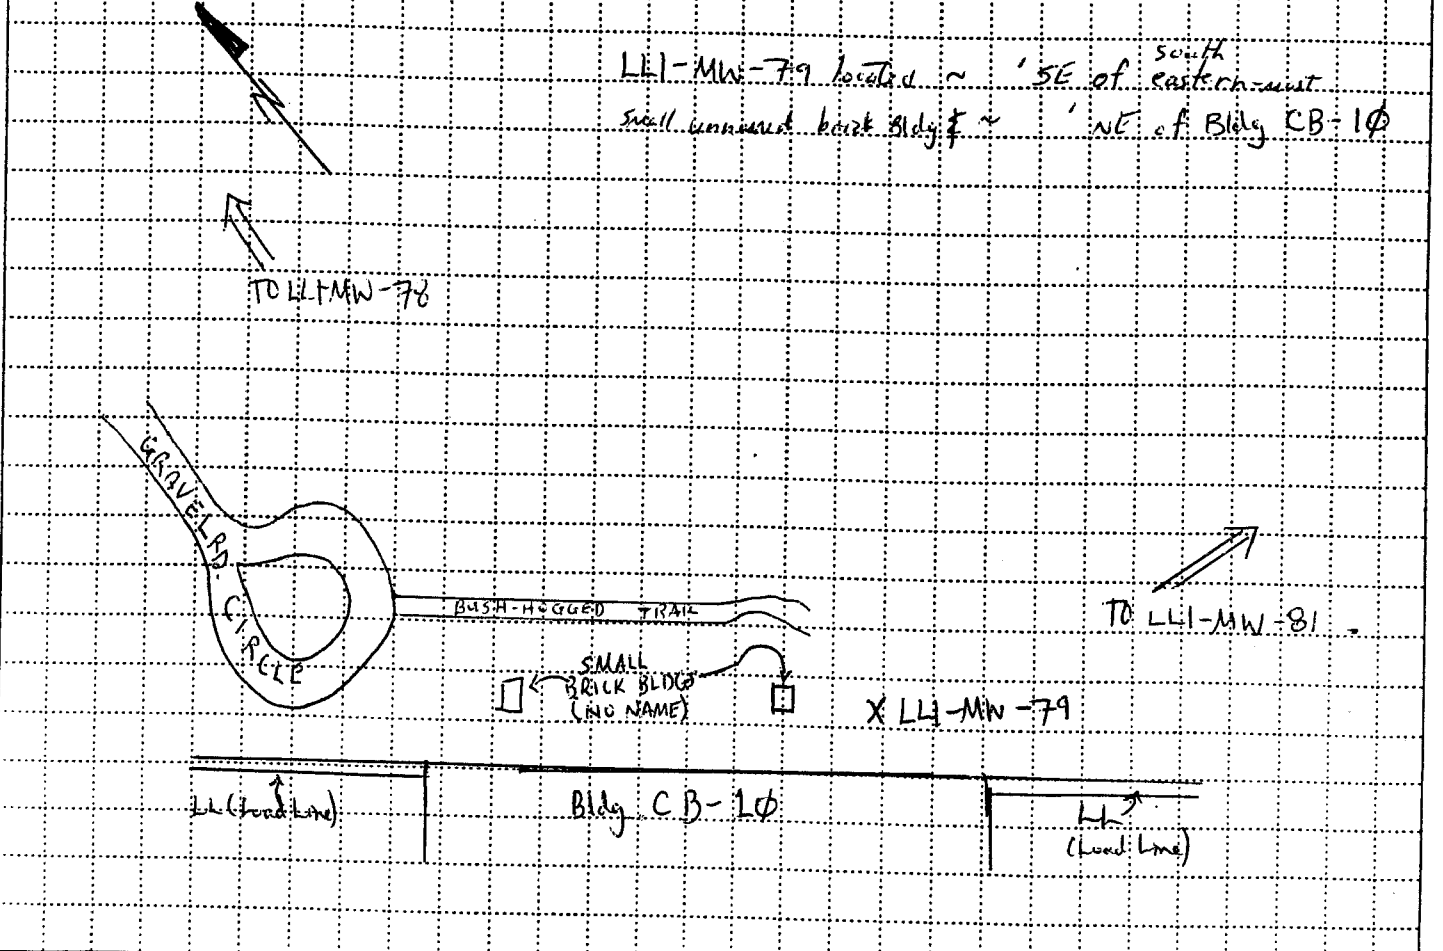

PROJECT RVAAP, LL1, Phase II RI	HOLE NO LL1-MW-79
------------------------------------	----------------------

DRILLING LOG

47

PROJECT		DRILLING LOG			HOLE NUMBER	
RVAAP, LLI, Phase II		INSPECTOR M. Vest			LLI-MW-79	
FEET (A)	DEPTH (B)	DESCRIPTION OF MATERIALS (C)	FIELD SCREENING RESULTS (D)	GEOCHEM SAMPLE OR CORE BOX NO (E)	ANALYTICAL SAMPLE NO (F)	REMARKS (G)
		Not sampled. Drill cutting show Ø.Ø' to 3.Ø' BGS to consist of v. wea. f-m gr. sandstone & silt to f. gr. sand.	Ø.Ø ppm	N/A	N/A	Could not push Shelby Tube or drive spoon (split) to achieve any recovery. Overburden consists of v. weathered bedrock.
1.0		TOP OF WEAR. BEDROCK. 1.1				
2.0			Ø.Ø ppm		N/A	Top of weathered bedrock @ 1.1' BGS
3.0		BEGIN CORING 3.0		3.0		Begin coring @ 3.Ø' BGS
4.0		SANDSTONE, thin bedded, 7/8" lt. gray, hard, mod. cemented, med. gr., MD ⁺ from horiz. bedding, highly fractured (breaks Ø.2'-Ø.4'), highly weathered, shale partings common < Ø.ØØ1' thick	Ø.Ø ppm	Box 1 of 8		Cored (3.Ø'-6.Ø') 3.Ø' Rec 2.5' Loss Ø.5'
5.0					N/A	Ø.5' Loss likely cumulative for entire 3Ø'-run as rubble zones/ breaks are common in the core recovered
6.0		(Gradational contact) 6.Ø	Ø.Ø ppm		N/A	Great circulation. Nearly 1ØØ% return. RQD = Ø
7.0		SANDSTONE, thin bedded, 7/8" lt. gray, hard to medium, mod. cemented, med. gr., MD ⁺ from horiz. bedding, highly fractured (breaks Ø.Ø'-Ø.4'), highly weathered, shale partings common < Ø.ØØ1' thick	Ø.Ø ppm			Cored (6.Ø'-11.Ø') 5.Ø' Rec 5.Ø' Loss Ø.Ø'
8.0			Ø.Ø ppm	Box 2 of 8	N/A	RQD = Ø
9.0						
10.0						

DRILLING LOG

PROJECT		INSPECTOR			HOLE NUMBER	SHEET	REMARKS
RVAAP, LLI, Phase II RI		M Vest			LLI-MW-79	3 of 45	vjb 11/29/97
ELEV (A)	DEPTH (B)	DESCRIPTION OF MATERIALS (C)	FIELD SCREENING RESULTS (D)	GEOCHEM SAMPLE OR CORE BOX NO (E)	ANALYTICAL SAMPLE NO (F)		
	11.0	Same as above, but iron (red) staining increasing w/depth.	ppm ϕ ppm	Box 2 of 8 (cont.)	NA	Corel (6.0' - 11.0') 5.0' Rec 4.0' 4.0' Loss 0.0 0.2' $RQD = \frac{.4}{4.8} = .08$	
	12.0		ϕ ppm		NA		
	13.0			13.0 Box 3 of 8			
	14.0		ϕ ppm		NA		
	15.0						
	15.8	Loss due to washout				15.8' - 16.0' B.S. loss was likely a shale, i.e. weathered	
	16.0	SANDSTONE, thin-bedded, 7/8" lt. gray, hard to med., mod. cemented, med. grain, $\approx 10^\circ$ from horiz. bedding, highly fractured, (breaks every $\phi 1'$ to $\phi 4'$) highly wea. (red staining throughout), shale partings common $\langle \phi \phi 1'$ thick	ϕ ppm		NA	Corel (6.0' - 21.0') 5.0' Rec 5.0' Loss ϕ 0.0' $RQD = \frac{.9}{5.0} = .18$	
	17.0		ϕ ppm		NA		
	18.0			18.0 Box 4 of 8			
	19.0						
	20.0						

DRILLING LOG

HOLE NUMBER **LL1-MW-79**

49

PROJECT **RVAAP, LL1, Phase II RI**

INSPECTOR **M. West / H. Smith**

SHEET **4 of 5**

DATE **11/29/11**

DEPTH (ft)	DESCRIPTION OF MATERIALS (C)	FIELD SCREENING RESULTS (D)	GEOLOGIC SAMPLE OR CORE BOX NO (E)	ANALYTICAL SAMPLE NO (F)	REMARKS (G)
	Same as above.	0.0 ppm		N/A	
21.0	20.6'-21.0' zone of rubble/v. weath. rock.				Cored (21.0'-26.0') 5.0' Rec 3.5 Loss 1.5 RQD = 0
22.0		0.0 ppm		N/A	
23.0			23.0 Box 598		
24.0		0.0 ppm		N/A	
25.0	Loss of 24.5' to 26.0' BGS, likely due to washout of v. weathered material and 0.5' left in borehole which cannot be retrieved.	0.0 ppm		N/A	
26.0			26.0		
26.5	Ran short run - Retrieved .5' from earlier run & .4' from this run - (SAME MATERIAL) AS ABOVE Run 5'		Box # 6 of 8		End coring @ 26.0' BGS. WL in borehole after pumping out casing water & waiting 35 min is 2390' BGS - After 2 days water is down
27.0					Run # 6 Run 0.5 Rec 0.9 .5' from earlier core is over drilled RQD = 0
28.0	Sandstone, thin bedded, 7/8" lt. grey hard to medium, moderately cemented med. grained - 10" from horizontal bedding. highly fractured (breaks every 0.1-0.5')	0.0 ppm		N/A	
29.0	Moderate weathering shale interbeds common v. 0.1' thick, brownish red iron staining found from 29-30.5 fairly heavy - lt staining on rest of the core.	2.0 ppm			Run # 7 Run 5' Rec 5' Loss: 0 RQD: $\frac{1.46}{3.0} = .292$

PROJECT **RVAAP, LL1, Phase II RI**

HOLE NO **LL1-MW-79**

DRILLING LOG

HOLE NUMBER
261mw079
SHEET
5 of 5

50

PROJECT
RVAAP, LLI, Phase 2 R.F

INSPECTOR
Kathleen Smith

DEPTH (A)	DEPTH (B)	DESCRIPTION OF MATERIALS (C)	FIELD SCREENING RESULTS (D)	GEOLOGIC SAMPLE OR CORE BOX NO (E)	ANALYTICAL SAMPLE NO (F)	REMARKS (G)
				Box # 7		
31.0				of 8		
		Run (SAME AS ABOVE)				
32.0		Sandstone, thin bedded 7/8 Lt. grey, hard to medium, moderately cemented, medium grained, ~10° from horizontal bedding.				RUN # 8 RUN: 5.0 REC: 5.0 LOSS: 0 RQD: $\frac{1.35}{5.0} = .270$
33.0		Highly fractured; however some pieces are getting larger between breaks. Moderate weathering				
34.0		Shale interbeds common ~0.01' thick, light iron staining is decreasing w/ depth Iron staining is gone at ~35' BGS.				
35.0				Box # 8		
36.0				of 8		
		Run Same material as above.				
37.0		except fractures are now predominantly .6' apart. Starting from ~36.5' BGS.				RUN # 9 RUN 4.0' REC 3.9 LOSS 0.1 RQD = .785
38.0						N 563739.63 E 2376228.312
39.0						Air-Rot to 39.7 B.O.B. 40.4' BGS

PROJECT
RVAAP, LLI, Phase 2 R.F

HOLE NO
261mw079

D-13

MONITORING WELL

PROJECT NAME: Load Line 1 Phase II RI

DELIVERY ORDER NO: 003

WELL NUMBER: LL/mw 079


BEGIN: 08/23/99

END: 8/28/99

COORDINATES: N: 563739.63
E: 2376228.312

REFERENCE POINT: TOL

ELEVATION: 791.87 MSL FT

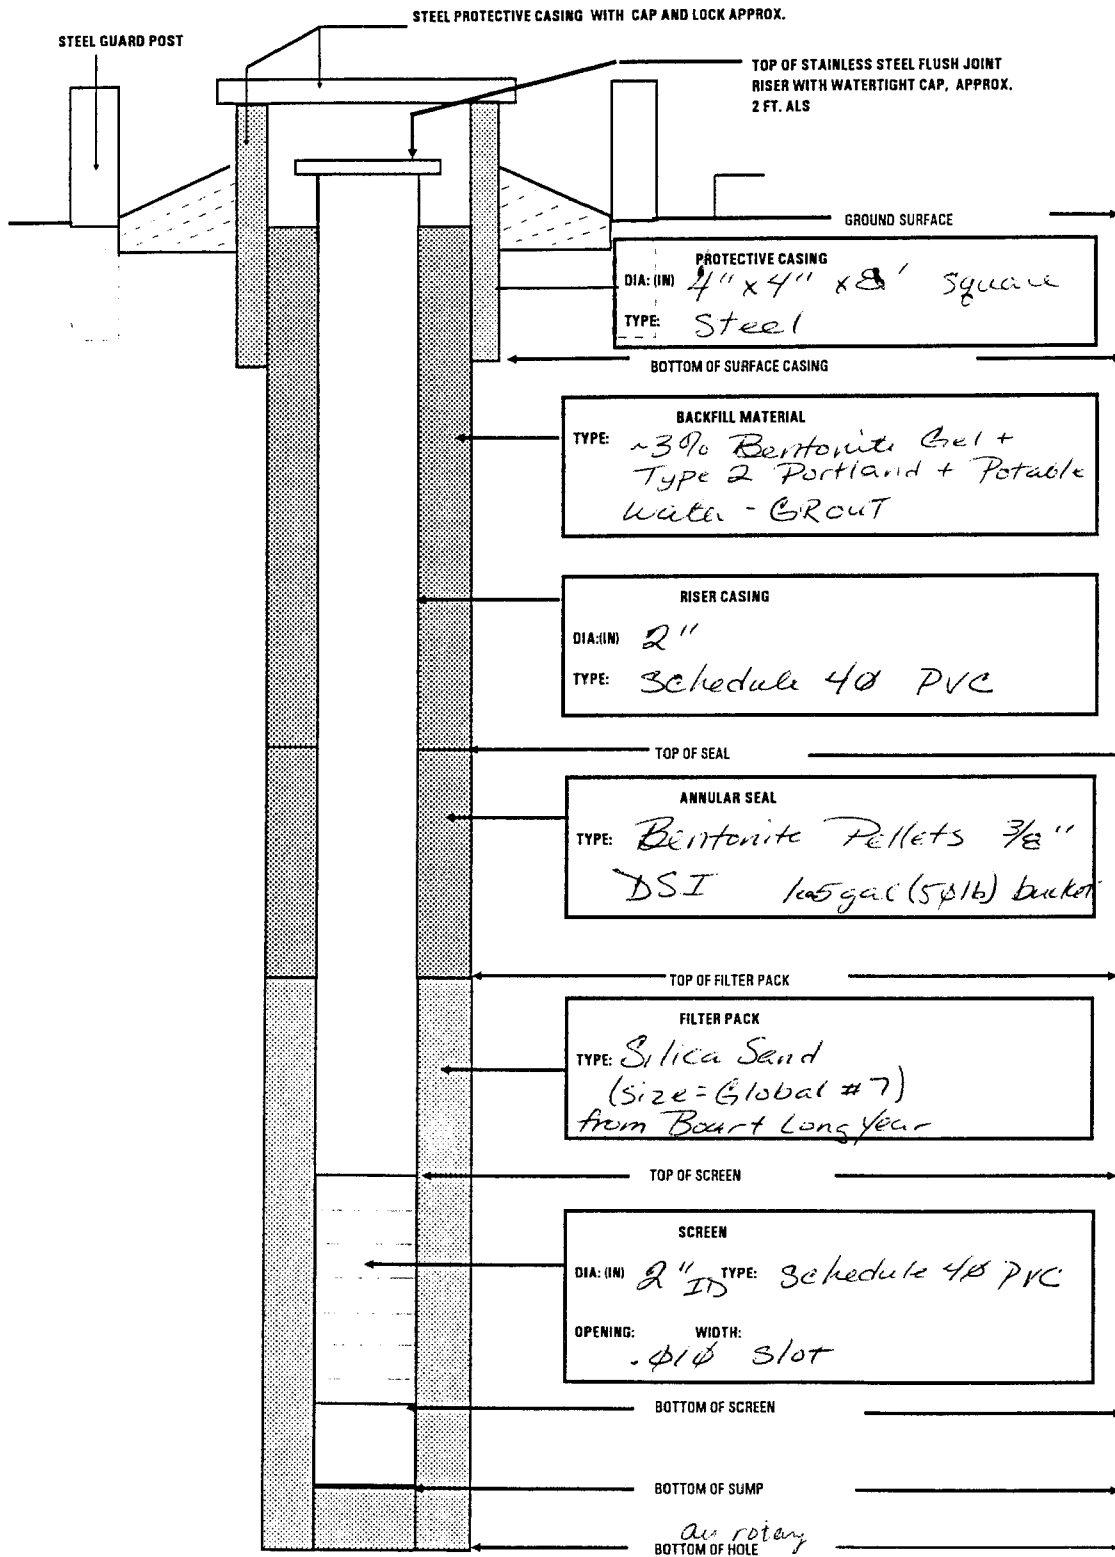

DEPTH	ELEV
0	
5' BGS	
20.10	
23.99	
29.53	
32.10	32.10 after 1 hr.
38.93	
39.46	
39.70'	

18

HTRW DRILLING LOG

DISTRICT: Louisville
 COMPANY NAME: SAIC
 DRILL SUBCONTRACTOR: Miller Drilling Co.
 HOLE NUMBER: LLI-MW-88
 SHEET 1 OF 4 SHEETS

PROJECT: RVAAP, LLI, Phase II RI
 LOCATION: RVAAP, LLI, Phase II, Ravenna, Ohio

NAME OF DRILLER: P. Brown
 MANUFACTURERS DESIGNATION OF DRILL: ME-75

SIZES AND TYPES OF DRILLING AND SAMPLING EQUIPMENT: 2" split pipe 4 1/4" ID HSA, 6" PVC casing, HQ wireline core barrel & bit, 6" tricone roller bit, D3 75Q John Deere (Sullivan) air compressor w/ oil/air separator.
 HOLE LOCATION: See Sketch Below

DATE STARTED: 08/18/99
 DATE COMPLETED: 08/22/99

OVERBURDEN THICKNESS: 0.0' (No overburden)
 DEPTH GROUNDWATER ENCOUNTERED: Using water to core, could not identify where groundwater first encountered

DEPTH DRILLED INTO ROCK: 24.5'
 DEPTH TO WATER AND ELAPSED TIME AFTER DRILLING COMPLETED: 12.6' BGS after 20 hrs from casing completion


TOTAL DEPTH OF HOLE: 25.0' (24.5' BGS)
 OTHER WATER LEVEL MEASUREMENTS (SPECIFY):

GEOTECHNICAL SAMPLES: 16.3 ft of core @ Shelby Tubes
 DISTURBED: None
 UNDISTURBED: N/A
 TOTAL NUMBER OF CORE BOXES: 3

SAMPLES FOR CHEMICAL ANALYSIS: None
 VOC: N/A
 METALS: N/A
 OTHER (SPECIFY): N/A
 OTHER (SPECIFY): N/A
 OTHER (SPECIFY): N/A
 TOTAL CORE RECOVERY: 87%

DISPOSITION OF HOLE: installed well
 BACKFILLED: N/A
 MONITORING WELL: 2" PVC
 OTHER (SPECIFY): N/A
 SIGNATURE OF INSPECTOR: Matthew B. Vest

LOCATION SKETCH/COMMENTS: N 562479.728
 E 2376845.072
 SCALE: NO T TO SCALE

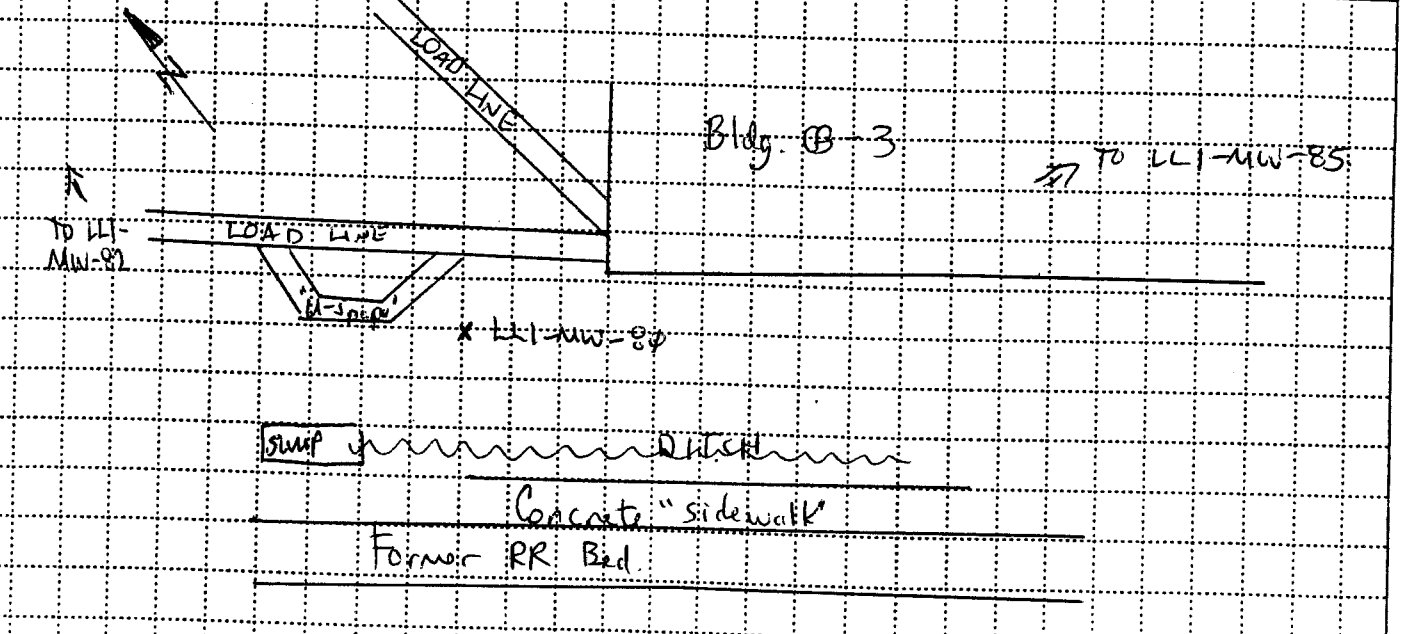

LLI-MW-88 is located ~ 1' SE of the W-shape of the load line, ~ 1' NE of the Ditch, ~ 1' NE of the former RR bed, & ~ 1' E of the Sump / Pumping Area.

PROJECT: RVAAP, LLI, Phase II RI
 HOLE NO: LLI-MW-88

DRILLING LOG

PROJECT RVAAP, LLI, Phase II RI		INSPECTOR M. Vest			HOLE NUMBER LLI-MW-80	
DEPTH (A)	DEPTH (B)	DESCRIPTION OF MATERIALS (C)	FIELD SCREENING RESULTS (D)	GEOCHEM. SAMPLE OR CORE BOX NO. (E)	ANALYTICAL SAMPLE NO. (F)	REMARKS (G)
1.0		Not sampled w/ split spoon. Rock @ surface (φ.φ' BGS) Cutting show rock to be a med. gr. sandstone.	φ.φ ppm	N/A	N/A	Rock @ surface (φ.φ' BGS) No Shelby Tube could be taken (no overburden). Augered (w/out sampling) to 5.0' BGS in order to get the top of the casing coming back in borehole. (Rig stroke only 7')
2.0			φ.φ ppm		N/A	
3.0						
4.0			φ.φ ppm		N/A	
5.0		5.0		5.0		Begin casing @ 5.0' BGS.
6.0		SANDSTONE, thin bedded, 7/16 light gray, hard, med. cemented, m. gr., bedding ~1' from horizontal, sh. wea., breaks common, shale partings common < φ.φ1' thick.	φ.φ ppm	Box 1 of 3		Run 5.3 Ree 4.95 Core (5.0' - 10.3') 5.3' Loss φ.35' Using ~200 gal. of water to cure 5.0' to 10.3' BGS.
7.0		5.2 No Recovery 5.4			N/A	Core has many breaks throughout and is stained red throughout. (Breaks every ~0.1 - 0.4').
8.0		(Gradational Contact) 7.9	φ.φ ppm		N/A	Circulation @ ~25% from ~5'-8' BGS. Loss of all circulation below 8.0' BGS.
9.0		SANDSTONE, thin bedded, 7/16 light gray, hard, med. cemented, f.-m. gr., bedding ~1' from horiz., highly to moderately weathered (decreasing w/ depth), breaks common, shale partings common < φ.φ1' thick.				$RQD = \frac{3.1}{4.95} = .63$
10.0				9.95		

A

DRILLING LOG

20

PROJECT: RVAAP, Phase II, LLI RI		INSPECTOR: M. Vest	HOLE NUMBER: LLI-MW-8φ			
DEPTH (ft)	DEPTH (m)	DESCRIPTION OF MATERIALS (C)	FIELD SCREENING RESULTS (D)	GEOCHEM SAMPLE OR CORE BOX NO (E)	ANALYTICAL SAMPLE NO (F)	REMARKS (G)
		Same As Above	φ. φ ppm	Box 2 of 3 (cont)	N/A	Core 5.0' (14.3-15.3' BGS) Rec 5.0' Loss φ. φ $RQD = \frac{4.1}{5.0} = .82$
11.0						
12.0			φ. φ ppm		N/A	-
13.0		13.1				Wh. & air rotary reaming wet cutting blown out of borehole @ N 12.5' BGS. No red staining present below 14.0' BGS - 1 most staining absent below 13.1' BGS.
14.0		SANDSTONE, thin bedded, 7/16" H. gray, hard, med. cemented, f-m. gr., bedding 1φ" from horiz. unweathered, breaks common, shale partings common < φ 1/8" thick.	φ. φ ppm		N/A	
15.0				14.95 Box 3 of 3		Core 1.0' (15.3-16.3' BGS) Rec 1.0' Loss φ. φ (Cured only) 1.0' run so that driller could get his rods on the same length of run as the rig stroke. $RQD = \frac{.65}{1} = .65$
16.0			φ. φ ppm		N/A	Core 5.0' (16.3-21.3' BGS) Rec 3.5 Loss 1.5 (Bottom ~1.5' BGS is falling out of core barrel & cannot retrieve it. $RQD = \frac{2.3}{3.5} = .657$
17.0						
18.0			φ. φ ppm		N/A	
19.0						
20.0		19.8				
24.0		No Recovery	φ. φ ppm		N/A	

PROJECT: RVAAP, LLI, Phase II RI

D-17

HOLE NO: LLI-MW-8φ

DRILLING LOG

21

PROJECT		INSPECTOR		HOLE NUMBER	
RVAAP, LL1, Phase II RI		M. Vest		LL1-MW-80	
DEPTH (ft)	DESCRIPTION OF MATERIALS (C)	FIELD SCREENING RESULTS (D)	GEOTECH SAMPLE OR CORE BOX NO (E)	ANALYTICAL SAMPLE NO (F)	REMARKS (G)
21.0	(Same as above (presumed)) No recovery 19.8'-21.3' BGS.	0.7 ppm	Box 3 of 3 (cont.)	N/A	End coring @ 21.3' BGS
21.3	End coring.		21.3		
21.3	Sandstone, thin lt. gray, f. m. s., wet.	0.8 ppm	N/A	N/A	WL - not able to be determined prior to running due to fall-in.
21.3					Begin air rotary drilling @ 13.1' BGS to reach 21.3' 21.3' BGS.
23.0					
24.0		0.4 ppm		N/A	
24.5					
24.5	End drilling @ 25.0' 24.5' BGS.	24.5		25.0	
25.0					End air rotary drilling @ 25.0' BGS.
26.0					
27.0					
28.0					
29.0					
30.0					

PROJECT RVAAP, LL1, Phase II RI D-18

HOLE NO LL1-MW-80

DRILLING LOG

22

PROJECT		INSPECTOR				HOLE NUMBER	
RVAAP, LLI, Phase I RE		M. Vest				LLI-mw-8φ	
DEPTH (ft)	DESCRIPTION OF MATERIALS (C)	FIELD SCREENING RESULTS (D)	GEOCHEM SAMPLE OR CORE BOX NO. (E)	ANALYTICAL SAMPLE NO. (F)	REMARKS (G)		
21.4	(Same as above, presumed) No Recovery 19.8' - 21.3' BGS	0.0 ppm	Box 3 of 3 (cont.)	N/A	End casing @ 21.3' BGS		
22.4	End casing @ 21.3 Sandstone, 7/8", lt. gray, f.m. gr., wet.	0.0 ppm	N/A	N/A	W.L. not able to be measured after casing, but prior to recovering core to fill in/blockage. Begin air rotary @ 13.1' BGS. Run to 21.3' BGS. Cont. air rotary to 24.5' BGS to reach adequate depth for setting well. Air rotary advancing @ ~1" per 10 min. in upward rock.		
24.9		0.0 ppm		N/A			
25.4	End drilling @ 24.5' BGS				End air rotary drilling @ 24.5' BGS. Total water used (~710 gal) for casing/drilling. N 562479.728 E 2376845.072		

PROJECT RVAAP, LLI, Phase II, RE

D-19

HOLE NO LLI-mw-8φ

MONITORING WELL

PROJECT NAME: Load Line 1 Phase II RI

DELIVERY ORDER NO: 003

WELL NUMBER: LL1-MW-084


BEGIN: 08/23/99

END: 08/24/99

COORDINATES: N: 562479.728
E: 2376845.072

REFERENCE POINT: TOL

ELEVATION: 996.37 MSLF

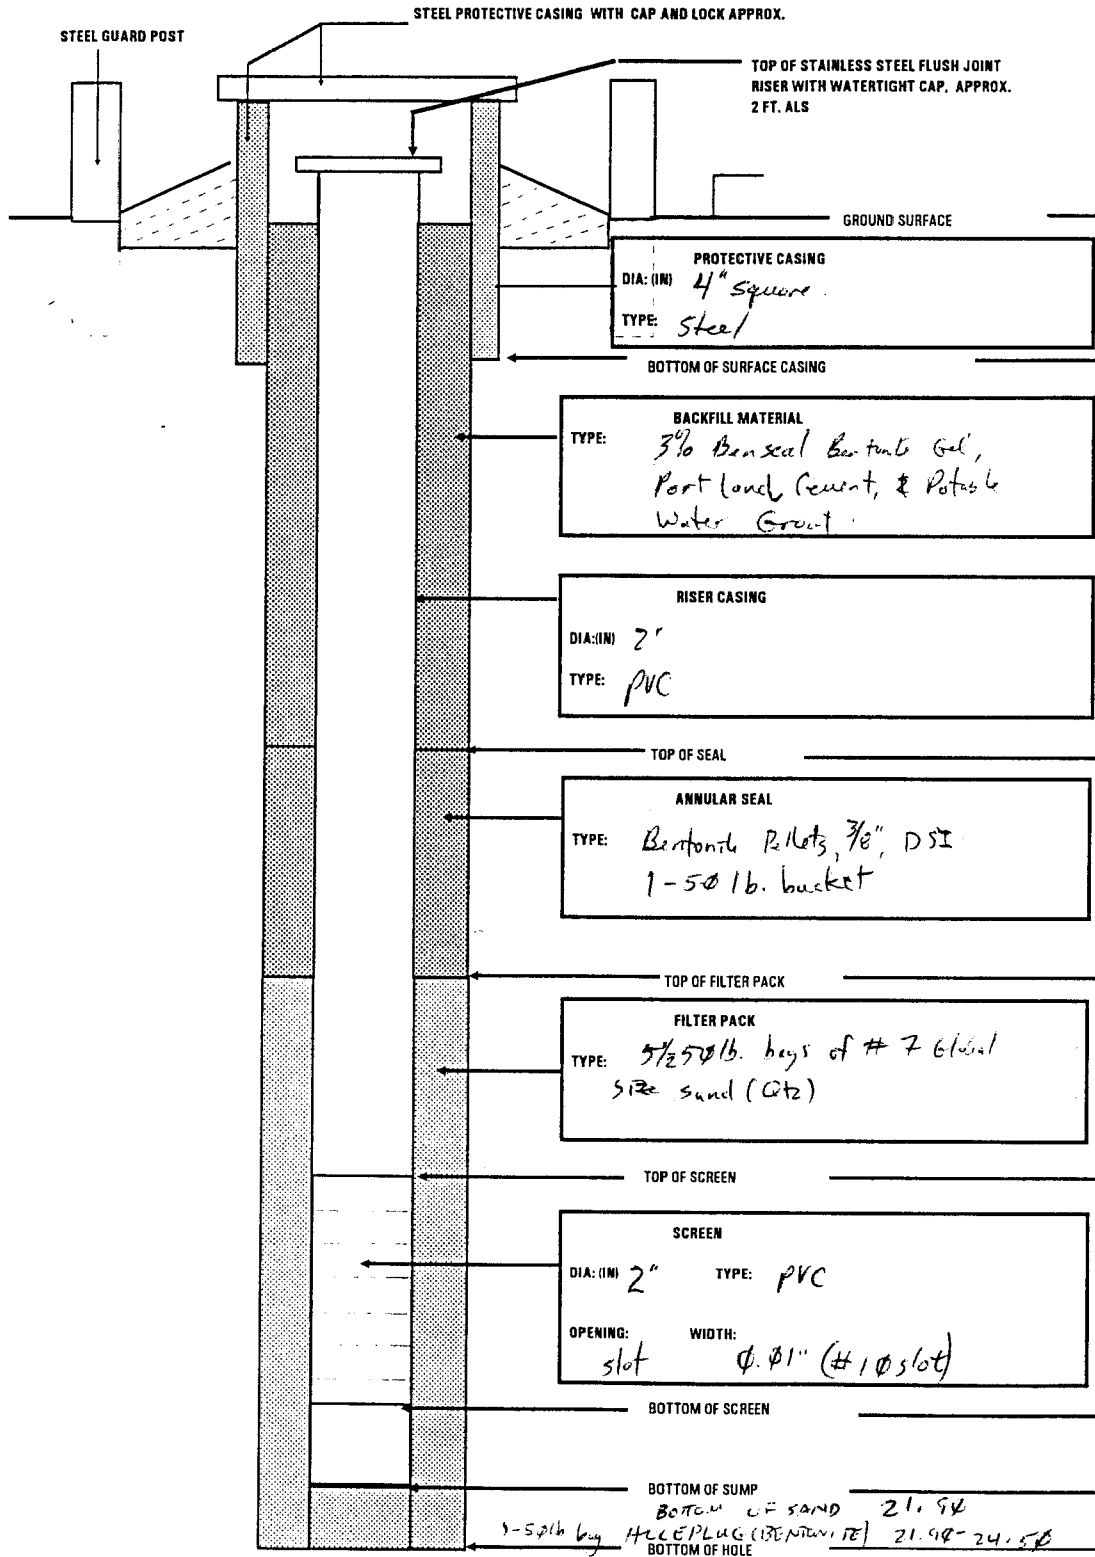

DEPTH BGS	ELEV
0	
4.0' BGS	
5.00	
5.00	MV
7.50	
7.50	MV
9.50	
9.50	MV
12.1	WL
18.97	
18.97	MV
19.47	
19.47	MV
21.94	
21.94 - 24.50	
24.50	


HOLE DIA: (IN)

7"

D-20

HTRW DRILLING LOG		DISTRICT Louisville		HOLE NUMBER LL1mw081	
1. COMPANY NAME SAIC		2. DRILL SUBCONTRACTOR Miller Drilling Company		SHEET 1 OF 5	
3. PROJECT RVAAP, Phase II Remedial Investigation of LL1			4. LOCATION RVAAP, LL1, near bldg # CB-4, Ravenswood Ohio		
5. NAME OF DRILLER Pete Brown			6. MANUFACTURERS DESIGNATION OF DRILL CME-75		
7. SIZES AND TYPES OF DRILLING AND SAMPLING EQUIPMENT		8. HOLE LOCATION See sketch below.			
6" PVC casing		9. SURFACE ELEVATION			
HQ Wireline Core Barrel		10. DATE STARTED 08/19/99			
6" tricone roller bit		11. DATE COMPLETED 08/24/99			
4 1/4" I.D. hollow stem auger		12. OVERBURDEN THICKNESS 2.1'			
13. DEPTH DRILLED INTO ROCK to 40.4' BGS		15. DEPTH GROUNDWATER ENCOUNTERED 37.6' BGS = Depth where we 1st blew water air during cor.			
14. TOTAL DEPTH OF HOLE 40.4' BGS		16. DEPTH TO WATER AND ELAPSED TIME AFTER DRILLING COMPLETED 31.69' BGS after ~80 min.			
18. GEOTECHNICAL SAMPLES Shelby tube		DISTURBED —		19. TOTAL NUMBER OF CORE BOXES 7	
20. SAMPLES FOR CHEMICAL ANALYSIS none taken while drilling		VOC —		METALS —	
22. DISPOSITION OF HOLE —		BACKFILLED —		MONITORING WELL 2"	
		OTHER (SPECIFY) —		OTHER (SPECIFY) —	
		OTHER (SPECIFY) —		OTHER (SPECIFY) —	
		OTHER (SPECIFY) —		21. TOTAL CORE RECOVERY 94.3%	
		OTHER (SPECIFY) —		23. SIGNATURE OF INSPECTOR <i>Kathy Smith</i>	

LOCATION SKETCH/COMMENTS **N 543462.725**
E 2376672.655 SCALE: **None**

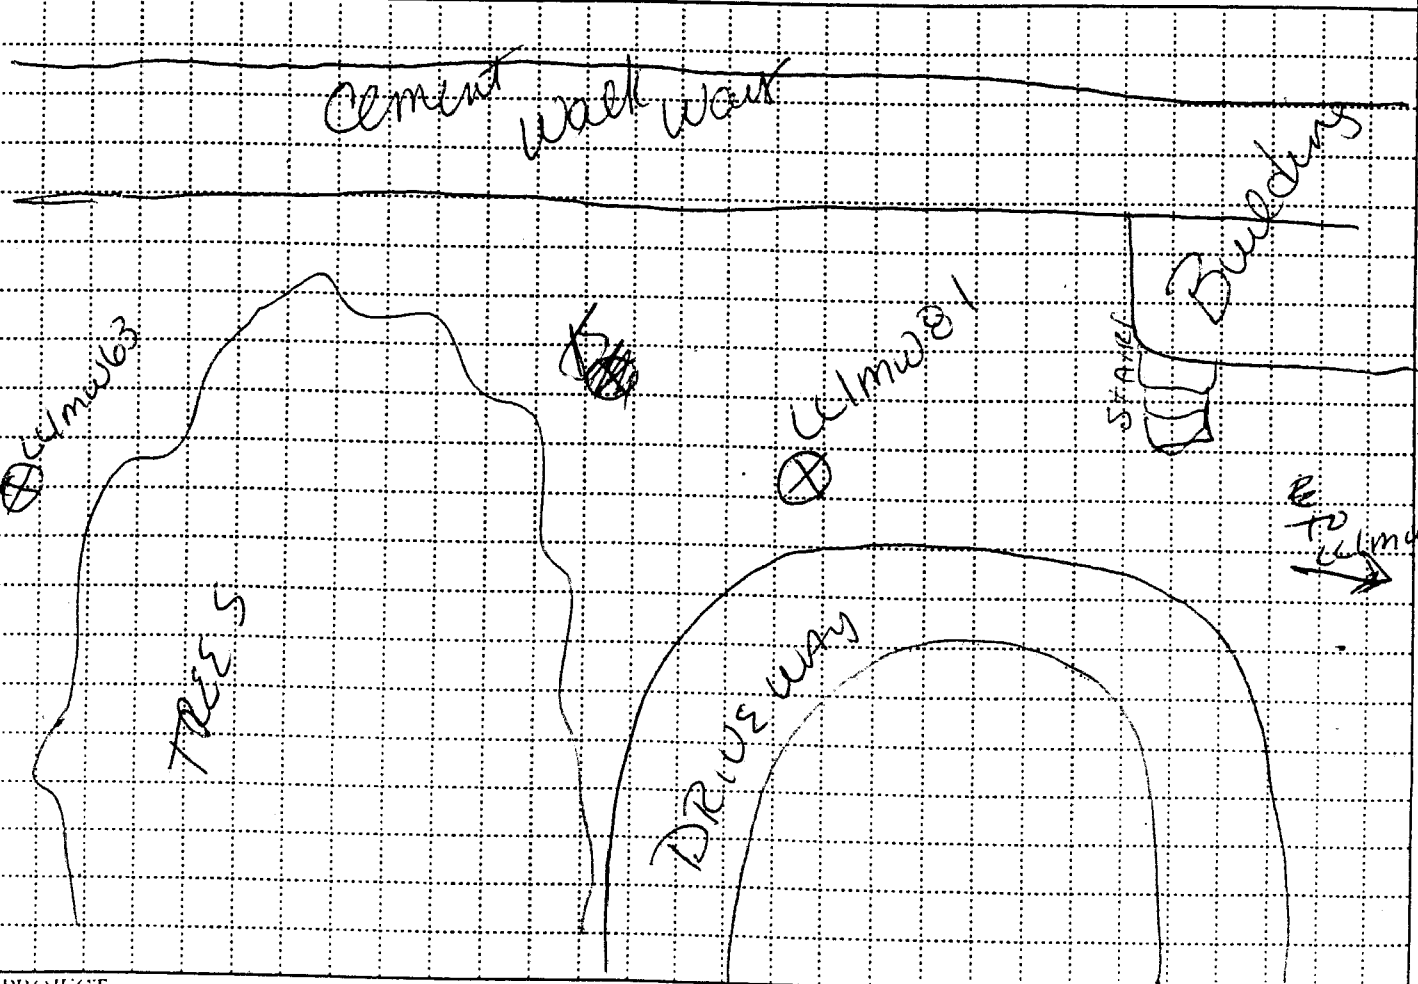

PROJECT RVAAP, Phase II RI of LL1	HOLE NO LL1mw081
---	----------------------------

DRILLING LOG

PROJECT		INSPECTOR			HOLE NUMBER	
RVAAP, Phase II RI of LLI		Heather Smith			LL1mw081	
DEPTH (ft)	DEPTH (m)	DESCRIPTION OF MATERIALS (C)	FIELD SCREENING RESULTS (M)	GEOCHEMICAL SAMPLE OR CORE INDEX NO (S)	ANALYTICAL SAMPLE NO (N)	REMARKS (R)
0.5		TOP SOIL / roots	0 ppm			Augered through top soil & roots to 1' to run geotechnical sample in soil.
1.0		Shelby tube - Geotechnical Sample	0 ppm	1.0'		Took geotechnical sample from 1.0' to top of rock at 2.1' BGS
1.5				Shelby Tube sample		
2.0		Rock cuttings indicate rock is med. gr. Sandstone	0 ppm	2.1'		Augered (w/cut sampling) from 2.1-3.0' BGS to set 6" casing.
2.5						
3.0		Sandstone - thin bedded, 7N light grey, hard, moderately cemented medium grained, bedding is 5-15° off horizontal, moderately to highly weathered, highly fractured, Breaks extend 0.5' → 0.2' along the core. Breaks show staining. Some staining on intact core sections as well.	0 ppm	Start core Box #1 of 7	ΦEi- ΦΦI- ST vjb 12-7-19	RUN : 3.0'
3.5						RECOVER : 2.9½
4.0						LOSS : 0.1'
4.5						TIME START 1205
5.0						TIME FINISH 1220
5.5						R.Q.D = 0
6.0		LOSS				RUN : 5.0'
6.5		Same as above				RECOVER : 4.4'
7.0			0 ppm			LOSS : 0.6'
7.5			20.6% O ₂			TIME START 1225
8.0						TIME FINISH 1240
8.5				CORE BOX # 2 OF 7		R.Q.D = 0
9.0						
9.5						

33

10.0

DRILLING LOG

PROJECT RVAAP, Phase II RI of LL1 INSPECTOR Heather Smith HOLE NUMBER LL1mw081 SHEET 3 of 5

DEPTH (ft)	DESCRIPTION OF MATERIALS (C)	FIELD SCREENING RESULTS (D)	GEOCHEM SAMPLE OR CORE BOX NO (E)	ANALYTICAL SAMPLE NO (F)	REMARKS (G)
11.0	(SAME AS ABOVE)	Ø ppm	CORE BOX #2 cont		
12.0	Sandstone - thin bedded 7N Light grey, hard, moderately cemented medium grained, bedding is 5-15° off horizontal, moderately to highly weathered, highly fractured	Ø ppm			RUN : 5.5' RECOVER : 4.9' LOSS : 0.6' ST. TIME : 1250 FINISH TIME : 1305 R.Q.D = Ø =
13.0	Shows red staining ~90% of the time. Red staining found on core body as well (on intact sections)		CORE BOX #3 of 7		
14.0					
15.0		Ø ppm			
16.0	(SAME AS ABOVE)	20.7% O ₂			
17.0	Sandstone - thin bedded 7N Light Grey, hard, moderately cemented, medium grained, bedding is 5-15° off horizontal	Ø ppm			RUN : 5.4' RECOVER : 4.5' LOSS : 0.5' START : 1310 FINISH : 1330
18.0	some moderately to highly weathered, highly fractured.		CORE BOX #4 of 7		R.Q.D = $\frac{1.0}{4.5} = .222$
19.0	Red staining darkens & is over entire 1.5' section of core (on breaks & on body of core)	20.7% O ₂			

PROJECT RVAAP, Phase II RI of LL1

HOLE NO LL1mw081

34

20.0

DRILLING LOG

HOLE NUMBER LLmw081

35

PROJECT RVAAP Phase II RI of LL1

INSPECTOR Heather Smith

SHEET 4 of 5

DEPTH (A)	DEPTH (B)	DESCRIPTION OF MATERIALS (C)	FIELD SCREENING RESULTS (D)	GLITCH SAMPLE OR CORE BOX NO (E)	ANALYTICAL SAMPLE NO (F)	REMARKS (G)
	20.5'	Dk. red staining returns to red staining as seen on the rest of this core previously	Ø ppm	CORE BOX #47		
	21.0'					
	21.5'	LOSS (SAME AS ABOVE)				
	22.0'		Ø ppm			
	22.5'	Red staining is decreasing w/ depth	20.6% O2			
	23.0'					
	23.5'	Red staining nearly gone		CORE BOX #57		
	24.0'	Sandstone - thin bedded 7N Light Grey, hard, moderately cemented	Ø ppm			
	24.5'	medium grained, bedding is 5-15° off horizontal				
	25.0'	Moderately weathered, fractured now ev. 0.2 → 0.5' intravels. No staining				
	25.5'	fractures along bedding planes.				
	26.0'		Ø ppm			
	26.5'	LOSS 0.1' (Bottom of Coreing)				
	27.0'	Sandstone - thin bedded 7N Light Grey, hard, moderately cemented, medium grained, bedding is 5-15° off horizontal	20.6% O2	CORE BOX #67		
	27.5'	Moderately weathered, fractured every 0.2-0.5' intravel. Red staining almost entirely gone.	Ø ppm			
	28.0'	Some cross bedding seen.				
	29.0'	(SAME AS ABOVE - RUNS)				

RUN : 5.0'
 RECOVER : 4.9'
 LOSS : ~~0.3~~ 0.1'
 START : 1400
 FINISH : 1415
 RQD = $\frac{2.9}{4.9} = .644$

Bottom of Coreing 26.5'
 *Resume Coreing 0.22-5.4'
 RUN : 5.2
 RECOVER : 5.2
 LOSS : 0
 START : 1425
 FINISH : 1440
 RQD = $\frac{1.6}{5.2} = .308$
 * We returned to continue coreing to depth.

DRILLING LOG

WELL NUMBER LL1mwφ81

PROJECT Phase II RI on LL1

INSPECTOR Heather L Smith

SHEET 5 of 5

DEPTH (ft)	DESCRIPTION OF MATERIALS (c)	FIELD SCREENING RESULTS (b)	GEOCHEM SAMPLE OR CORE BOX NO (d)	ANALYTICAL SAMPLE NO (e)	REMARKS (f)
30.5 - 31.0	Same as above	φ ppm			
31.0 - 32.0	Same as above	20.6% O ₂	CORE BOX # 7 of 7		W.T. @ 31.69' BOR RUN : 4.7 RECOVER : 4.7 LOSS : 0.0 START : 1450 FINISH : 1510 RQD = $\frac{1.7}{4.7} = 36\%$ RQD = .362
32.0 - 33.0	Same as above				
33.0 - 34.0	(1st) Complete unfractured section of sandstone (the rest of the core is fractured av. 0.2-0.5' as above)	φ ppm			
34.0 - 36.0	end of 2nd coring	20.6% O ₂			
36.0 - 37.0	Cuttings indicate Sandstone - fine to med. grained. wet grey	φ ppm	NA	NA	end of 2nd Coring Air Rotary to T.D. of 40.40' BGS. No core taken.
37.0 - 38.0		20.6% O ₂			N 563462.725 E 2376672.655
38.0 - 39.0					
39.0 - 40.0	BOB 40.40' BGS				B.O.B. 40.40' BGS

MONITORING WELL

PROJECT NAME: Load Line 1 Phase II RI

DELIVERY ORDER NO: 003

WELL NUMBER: LL1mw081


BEGIN: 08-22-99

END: 08-23-99

COORDINATES: N: 563462.725
E: 2376672.655

REFERENCE POINT: TDC

ELEVATION: 998.92 MSL ft

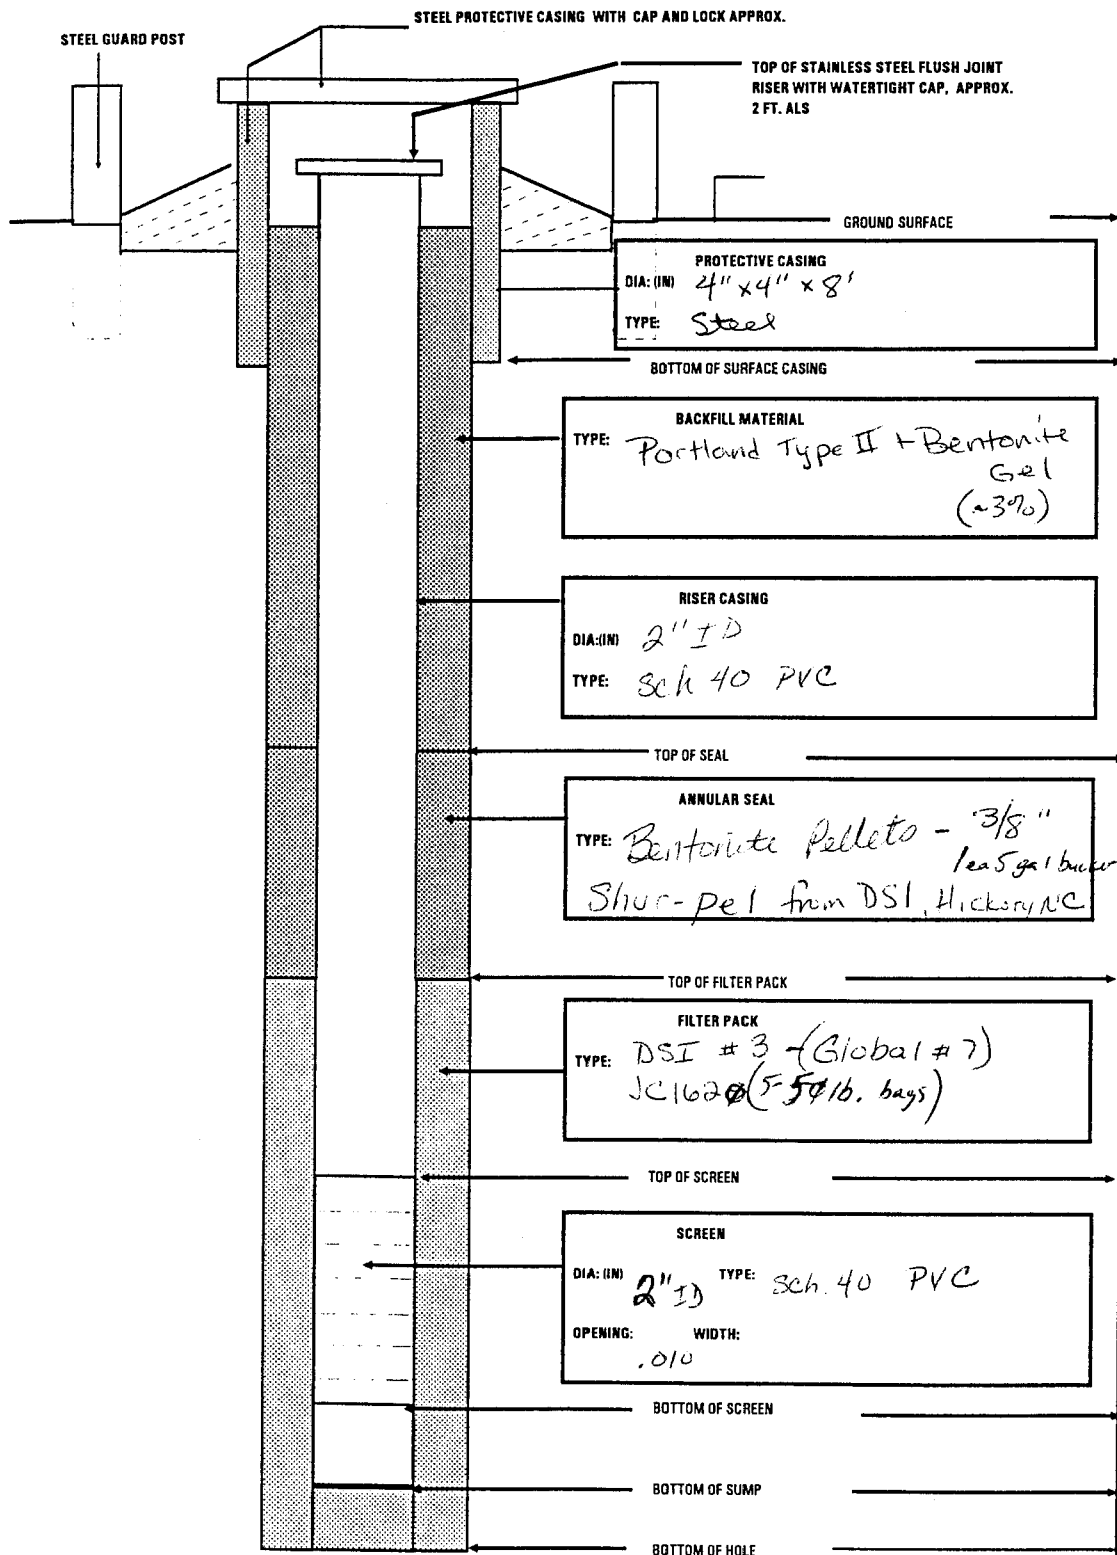

DEPTH	ELEV
BGS	
0	
5' BGS	
20.85	
24.85	
29.38	
28.85 / 28.85	8-22-99
31.69	W.L
38.85	
39.35	
40.40	

HOLE DIA: (IN)

8-22-99
16.25"
7.0"


D-26

HTRW DRILLING LOG		DISTRICT: Louisville		HOLE NUMBER: LLmw082	
1. COMPANY NAME: SAIC		2. DRILL SUBCONTRACTOR: Miller Drilling Company		SHEET 1 OF 5 SHEETS	
3. PROJECT: RUAAP, LLI, Phase 2 RI			4. LOCATION: LL11 near bldg CB-4A		
5. NAME OF DRILLER: Pete Brown			6. MANUFACTURERS DESIGNATION OF DRILL: CME-75		
7. SIZES AND TYPES OF DRILLING AND SAMPLING EQUIPMENT:		8. HOLE LOCATION: see map			
• 6" Tricone roller bit		9. SURFACE ELEVATION:			
• D375Q Air Compressor - w/ oil/air separator		10. DATE STARTED: 08-27-99		11. DATE COMPLETED: 08-28-99	
12. OVERBURDEN THICKNESS: 1.8'		13. DEPTH GROUNDWATER ENCOUNTERED: ~30.5' BGS			
13. DEPTH (DRILLED) INTO ROCK: to 39.5' BGS		14. DEPTH TO WATER AND ELAPSED TIME AFTER DRILLING COMPLETED:			
14. TOTAL DEPTH OF HOLE: 39.5' BGS		15. OTHER WATER LEVEL MEASUREMENTS (SPECIFY):			
18. GEOTECHNICAL SAMPLES: Shelby tube		DISTURBED: —		UNDISTURBED: X	
19. TOTAL NUMBER OF CORE BOXES: N2		20. SAMPLES FOR CHEMICAL ANALYSIS:		21. TOTAL CORE RECOVERY: NA	
VOC: —		METALS: —		OTHER (SPECIFY): —	
22. DISPOSITION OF HOLE: BACKFILLED		MONITORING WELL: 2"		23. SIGNATURE OF INSPECTOR: Heath Smith	

LOCATION SKETCH/COMMENTS

N 562956.86
E 2376977.379

SCALE: NONE

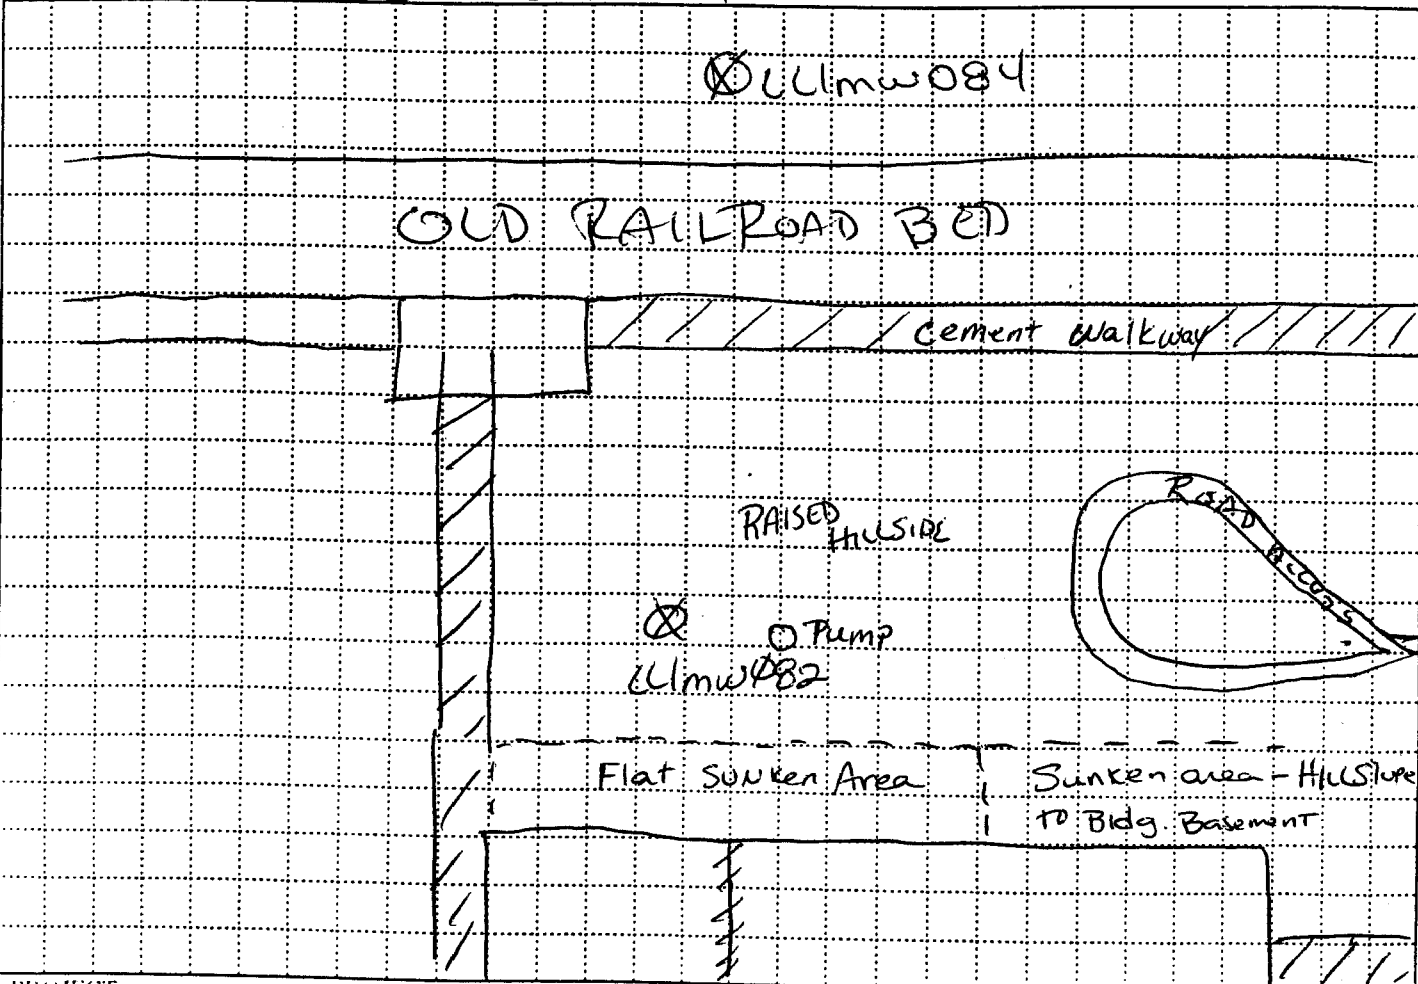

PROJECT: RUAAP, LLI, Phase 2 RI

HOLE NO: LLmw082

DRILLING LOG

WELL NUMBER
LL1mw082
SHEET
2 of 5

103

PROJECT
RVAAP, LL1, Phase 2 RI

INSPECTOR
Heather Smith

DEPTH (A)	DEPTH (B)	DESCRIPTION OF MATERIALS (C)	FIELD SCREENING RESULTS (D)	GEOLOGIC SAMPLE OR CORE BOX NO. (E)	ANALYTICAL SAMPLE NO. (F)	REMARKS (G)
	0.5	Shelby Tube taken		Shelby tube sampled	LL1-MW-082-φφφ1-ST	
	1.0	Sampled φ-1.8	φppm		vjb	
	1.5		2φ.6% _{O2}			12-7-99
	2.0	1.8 Resistance @ 1.8' BGS		108		
	2.5	Cuttings indicate alternating layers of med. → fine gr. sandstone dry 2.5γ/2				Begin Air Rotary drilling at 1.8' BGS. I will log this hole using cuttings, but there is a delay in the time they are cut & the time they are blown out the top of the hole. Measurements are not exact.
	3.0					
	3.5	1/3 Silty Sand 2/3 weathered stained sandstone med → fine gr. dry.	φppm			
	4.0	(layer ~ .5' thick ea)	2φ.6% _{O2}			
	4.5					
	5.0					
	5.5	Sandstone med → fine grained dry 2.5γ/2 Lt				
	6.0	brownish grey w/ some iron staining on cuttings				
	6.5					
	7.0		φppm			
	7.5		2φ.6% _{O2}			
	8.0					
	8.5					
	9.0					
	9.5					

PROJECT

D-28

WELL NO

10.4

DRILLING LOG

HOLE NO. 241mw082

104

PROJECT RVAAP, LLI, Phase 2 RI

INSPECTOR Heather Smith

SHEET 3 of 5

ELEV (A)	DEPTH (B)	DESCRIPTION OF MATERIALS (C)	FIELD SCREENING RESULTS (D)	GEOCHEM SAMPLE OR CORE BOX NO. (E)	ANALYTICAL SAMPLE NO. (F)	REMARKS (G)
		Same as above	Φ ppm 20.6% O ₂	NA	NA	description from Air Rotary cuttings only
11.0						
12.0						
13.0			Φ 20.6% O ₂			
14.0				NA	NA	
15.0						
16.0			Φ ppm 20.6% O ₂			
17.0						
18.0				NA	NA	
19.0			Φ ppm 20.6% O ₂			
20.0						

PROJECT RVAAP, LLI, Phase 2 RI

HOLE NO 241mw082

D-29

DRILLING LOG

WELL NUMBER LL1mw082

105

PROJECT RVAAP, LL1, Phase 2 RI

INSPECTOR Heather Smith

SHEET 4 of 5

DEPTH (A)	DEPTH (B)	DESCRIPTION OF MATERIALS (C)	FIELD SCREENING RESULTS (D)	GEOCHEM SAMPLE OR CORE BOX NO (E)	ANALYTICAL SAMPLE NO (F)	REMARKS (G)
		Same as above				Air Rotary Drilling
	21.0		0 ppm 20.6%	NA	NA	
	22.0					
	23.0					
	24.0		0 ppm 20.6%	NA	NA	
	25.0					
	26.0					
	27.0		0 ppm 20.6%	NA	NA	
	28.0					
	29.0					

20.0
21.0
22.0
23.0
24.0
25.0
26.0
27.0
28.0
29.0
30.0

PROJECT

RVAAP, LL1, Phase 2 RI

D-30

HOLE NO

LL1mw082

DRILLING LOG

HOLE NUMBER *U1mw082*

106

PROJECT *RVAAP, Phase 2 RI@LL1*

INSPECTOR *Kathryn Smith*

SHEET *5 of 5*

ELEV (A)	DEPTH (B)	DESCRIPTION OF MATERIALS (C)	FIELD SCREENING RESULTS (D)	GEOCHEM SAMPLE OR CORE BOX NO (E)	ANALYTICAL SAMPLE NO (F)	REMARKS (G)
31.0		<i>Same as above</i> <i>W630.5' BGS</i>	<i>Φ ppm</i> <i>20.6%</i>	<i>NA</i>	<i>NA</i>	<i>On Rot. Drilling</i>
32.0						
33.0						
34.0						
35.0		<i>Same as above</i> <i>(only wet)</i>	<i>Φ ppm</i> <i>20.6%</i>	<i>NA</i>	<i>NA</i>	
36.0						
37.0						
38.0			<i>Φ ppm</i> <i>20.6</i>	<i>NA</i>	<i>NA</i>	
39.0						<i>N 562956.86</i> <i>E 2376977.379</i>
						<i>B.O.B 39.5</i>

30.0

▽

≡

31.0

32.0

33.0

34.0

35.0

36.0

37.0

38.0

39.0

40.0

PROJECT

RVAAP, Phase 2 RI@LL1

D-31

HOLE NO


U1mw082

MONITORING WELL

PROJECT NAME: Load Line 1 Phase I/RI

DELIVERY ORDER NO: 003

WELL NUMBER: LLmw 082	BEGIN: 08-27-99	END: 08-28-99
COORDINATES: N: 562956.86 E: 2376977.379	REFERENCE POINT: TOL	ELEVATION: 1006.45MSL FT.

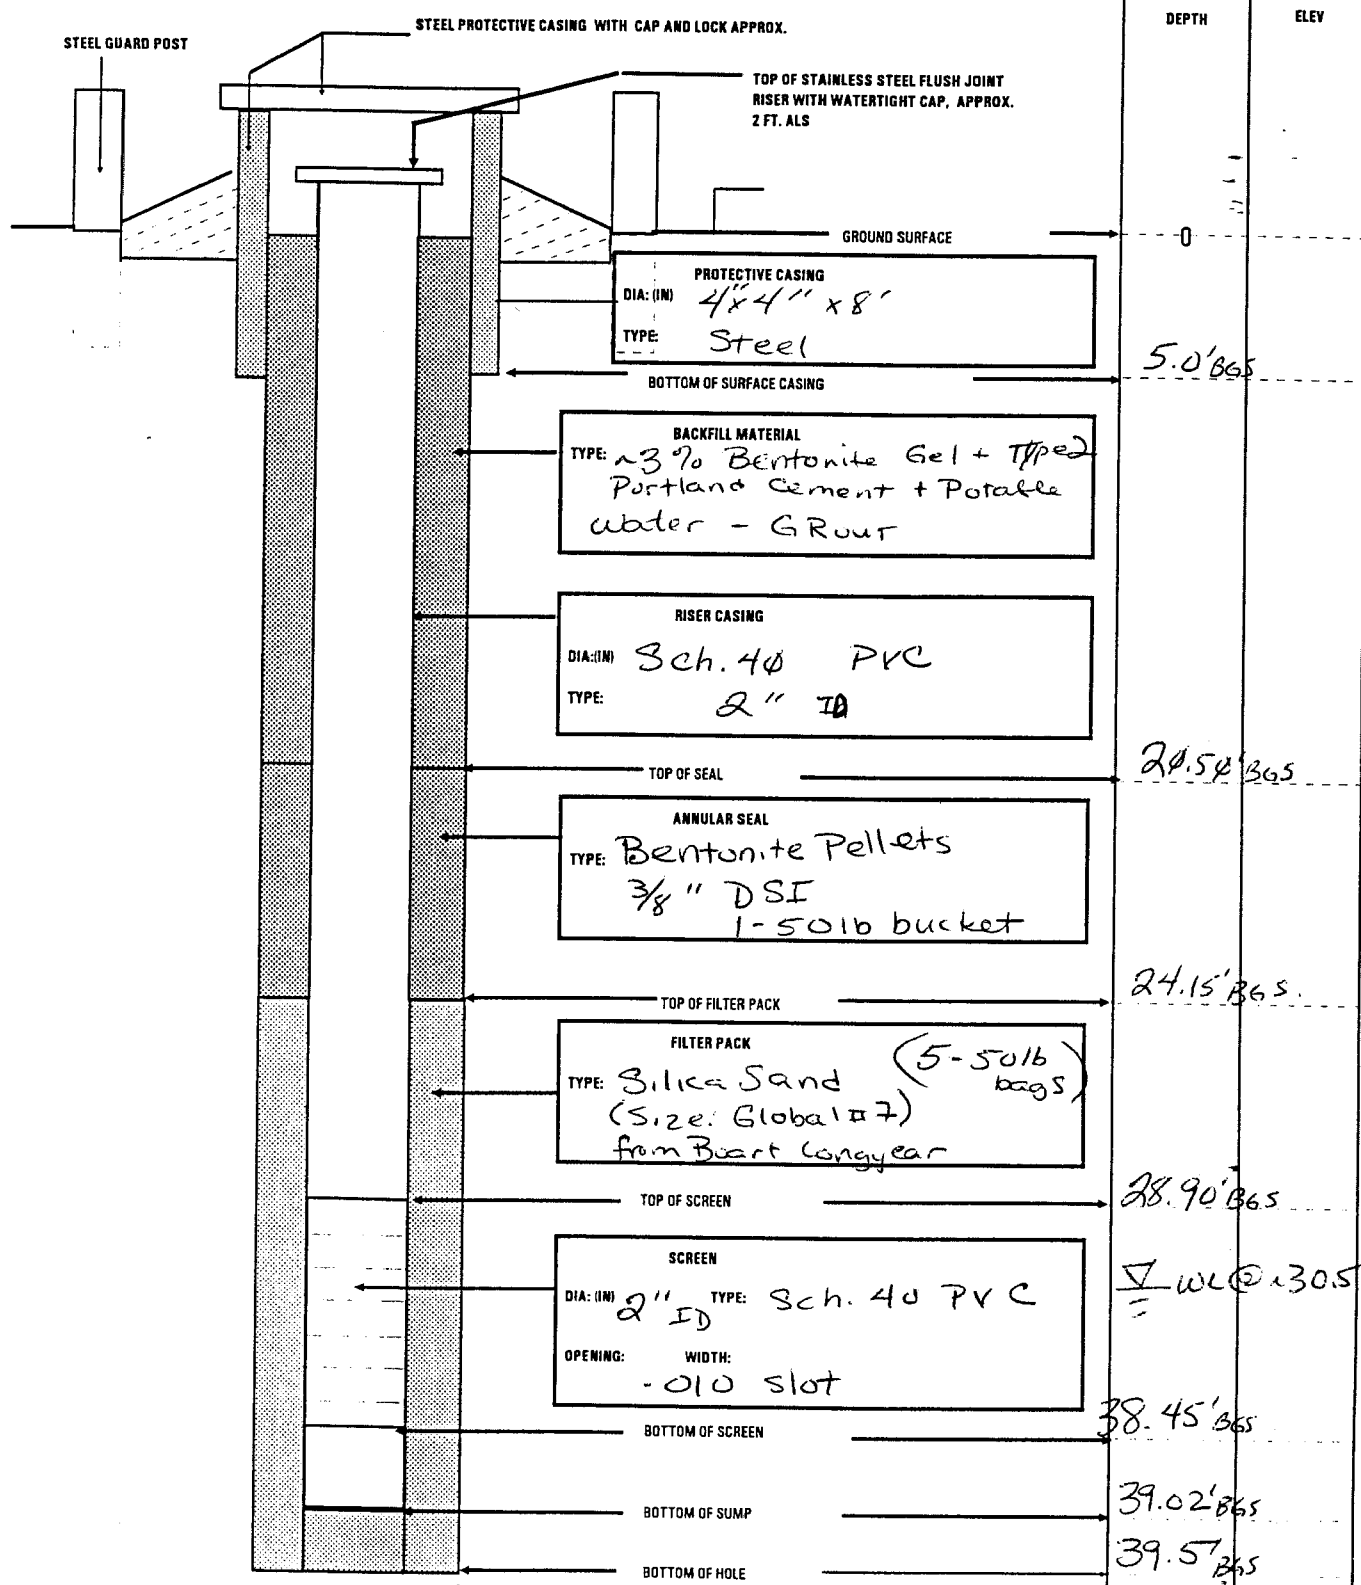

PROTECTIVE CASING
DIA: (IN) 4x4" x 8'
TYPE: Steel

BACKFILL MATERIAL
TYPE: ~3% Bentonite Gel + Type 2 Portland Cement + Potable water - GRout

RISER CASING
DIA: (IN) Sch. 40 PVC
TYPE: 2" ID


ANNULAR SEAL
TYPE: Bentonite Pellets
3/8" DSI
1-50lb bucket

FILTER PACK
TYPE: Silica Sand (5-50lb bags)
(Size: Global #7)
from Burt Longyear

SCREEN
DIA: (IN) 2" ID TYPE: Sch. 40 PVC
OPENING: -010 slot

HOLE DIA: (IN) → 7" ←

HTRW DRILLING LOG		DISTRICT <i>Louisville</i>		HOLE NUMBER <i>LL1-MW-83</i>	
1. COMPANY NAME <i>SALC</i>		2. DRILL SUBCONTRACTOR <i>Miller Drilling Co.</i>		SHEET <i>1</i> OF SHEETS <i>5</i>	
3. PROJECT <i>RVAAP, LL1, Phase II RI</i>			4. LOCATION <i>RVAAP, LL1, Ravenna, Ohio</i>		
5. NAME OF DRILLER <i>P. Brown</i>			6. MANUFACTURERS DESIGNATION OF DRILL <i>CME-75</i>		
7. SIZES AND TYPES OF DRILLING AND SAMPLING EQUIPMENT <i>2" Split spoon, 6" tri-cone roller bit, 0375 Q John Deere (Sullivan) Air Compressor w/ oil/air separator</i>		8. HOLE LOCATION <i>See Sketch Below</i>		9. SURFACE ELEVATION	
12. OVERBURDEN THICKNESS <i>0.2' 1.5'</i>		10. DATE STARTED <i>08/25/99</i>		11. DATE COMPLETED <i>08/26/99</i>	
13. DEPTH DRILLED INTO ROCK <i>39.5' BGS</i>		15. DEPTH GROUNDWATER ENCOUNTERED <i>1st hit water btwn 27-28' BGS HS</i>		16. DEPTH TO WATER AND ELAPSED TIME AFTER DRILLING COMPLETED <i>WL @ 32.16 after ~2 hours HS</i>	
14. TOTAL DEPTH OF HOLE <i>to 39.5' BGS HS</i>		17. OTHER WATER LEVEL MEASUREMENTS (SPECIFY) <i>WL @ 32.5' after ~2 hrs. HS</i>		19. TOTAL NUMBER OF CORE BOXES <i>N/A</i>	
18. GEOTECHNICAL SAMPLES <i>None</i>		DISTURBED <i>N/A</i>		UNDISTURBED <i>N/A</i>	
20. SAMPLES FOR CHEMICAL ANALYSIS <i>None</i>		VOC <i>N/A</i>		METALS <i>N/A</i>	
22. DISPOSITION OF HOLE <i>set monitoring well</i>		BACK-FILLED <i>N/A</i>		MONITORING WELL <i>2" PVC</i>	
LOCATION SKETCH/COMMENTS <i>N 563612.754 E 2377074.8</i>		OTHER (SPECIFY) <i>N/A</i>		OTHER (SPECIFY) <i>N/A</i>	

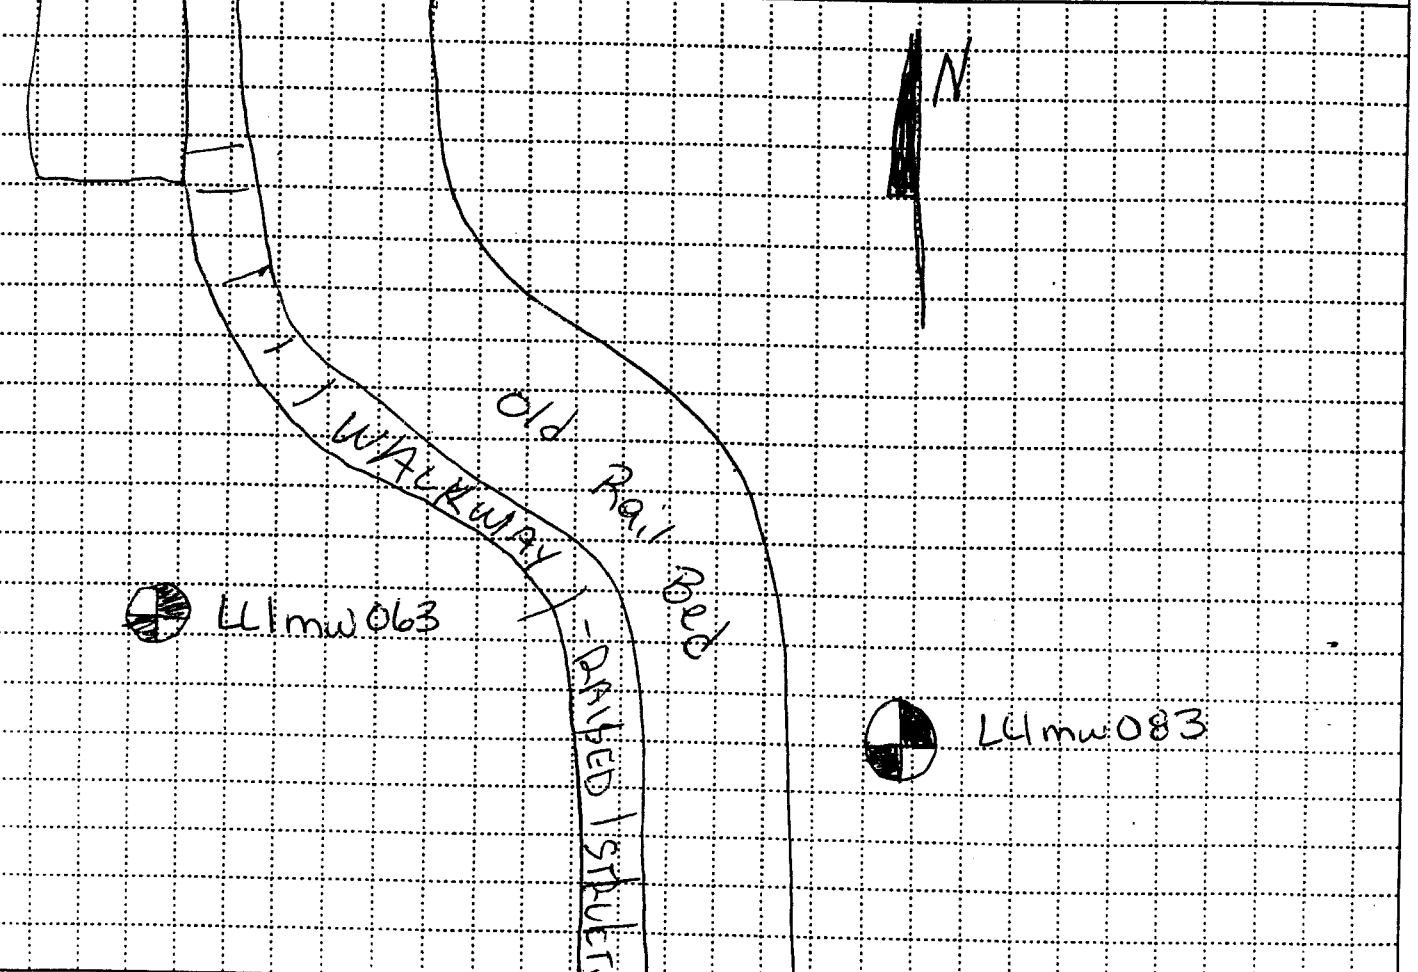

PROJECT <i>RVAAP, LL1, Phase II</i>	HOLE NO. <i>LL1-MW-83</i>
--	------------------------------

DRILLING LOG

PROJECT		DRILLING LOG			HOLE NUMBER
RVAAP, LLI Phase II		INSPECTOR M. Vest			LLI-MW-83
DEPTH (ft)	DESCRIPTION OF MATERIALS (C)	FIELD SCREENING RESULTS (D)	GEOLOGIC SAMPLE OR CORE BOX NO (E)	ANALYTICAL SAMPLE NO (F)	REMARKS (G)
0.0	Topsoil & Gravel	φ. φ ppm	N/A	N/A	Split spinn Refusal @ φ. 2'
1.0	Sandstone, fine gr., thin gray, dry.				
2.0		φ. φ ppm	N/A	N/A	Spinn refusal @ φ. 2' BGS on well bedrock. Begin Air Pottery drilling @ φ. 2' BGS
3.0					Drill advancement rate was @ 1 1/2 ft / 10 min ^{was} 1 1/2 ft / 10 min in well material @ ~ 23' per 10 min, but slows to ~ 1/2' per 10 min @ 3 1/2' BGS and below.
4.0	Sandstone, fine gr., 2.5' 1/2 lt. brownish gray, dry.				Likely v. weathered bedrock φ. 2' - 3.5' BGS, more competent bedrock below 3.5' BGS.
5.0		φ. φ ppm	N/A	N/A	Rock descriptions logged w/ cuttings from air rotary. Depths are not exact to 1/16 ft due to delay in some cuttings return
6.0					
7.0					
8.0					
9.0					
10.0					

DRILLING LOG

74

PROJECT		INSPECTOR			HOLE NUMBER		
RVAAP LLI, Phase II, RI		M. Vest			LLI-MW-83		
ELEV (A)	DEPTH (B)	DESCRIPTION OF MATERIALS (C)	FIELD SCREENING RESULTS (D)	GEOCHEMICAL SAMPLE OR COKE BOX NO (E)	ANALYTICAL SAMPLE NO (F)	REMARKS (G)	
	11.4	Sandstone, fine grained, 2.5 1/2 ft. brownish gray, dry.	φ. P ppm	N/A	N/A	Drill rate still @ ~ 1'-2' per minutes	
	12.4		φ. P ppm	N/A	N/A		
	13.4						
	14.4						
	15.4		φ. P ppm	N/A	N/A		
	16.4						
	17.4						
	18.4		φ. P ppm	N/A	N/A		
	19.4						
	20.4		φ. P ppm	N/A	N/A		


PROJECT RVAAP, LLI, Phase II, RI

D-35

HOLE NO LLI-MW-083

DRILLING LOG

77

PROJECT RVAAP, LW, Phase II		INSPECTOR M. Vest			HOLE NUMBER LL1-MW-83	
DEPTH (A)	DEPTH (B)	DESCRIPTION OF MATERIALS (C)	FIELD SCREENING RESULTS (D)	GEOCHEM SAMPLE OR CORE BOX NO. (E)	ANALYTICAL SAMPLE NO. (F)	REMARKS (G)
	21.7	Sandstone, f-m gr; 2.5 Y 1/2 H. brownish gray, dry.	φ. φ ppm	N/A	N/A	Drill rate @ ~ 1/2' per 1φ minutes.
	22.0					
	23.0					
	24.0					
	25.0					
	26.0					
	27.0	Sandstone, f-m gr; 2.5 Y 1/2 H. brownish gray, wet.			#8 	Cutting begin to be wet below 27-φ' BGS.
	28.0					
	29.0					
	30.0					

PROJECT RVAAP, LL1, Phase II RJ

D-36

HOLE NO
LL1 - MW - 83

DRILLING LOG

PROJECT: PVAAP, LLI, Phase II RI INSPECTOR: M. Vent / H. Smith HOLE NUMBER: LLI-MW-83
 SHEET: 5 of 5

DEPTH (A)	DEPTH (B)	DESCRIPTION OF MATERIALS (C)	FIELD SCREENING RESULTS (D)	GEOLOG. SAMPLE OR CONC. (BOX NO) (E)	ANALYTICAL SAMPLE NO (F)	REMARKS (G)
	31.4	Sandstone, fine gr., 2.5Y 4/2 lt. brownish gray, dry wet.	φ φ ppm	n/a	n/a	Drill rate @ ~ 1' per 16 min.
	32.4		φ φ ppm	n/a	n/a	
	33.4	Sandstone, fine - medium grained 2.3Y 6/2 lt. brownish gray, wet (from cuttings)	φ φ ppm	n/a	n/a	Cuttings wet (water) @ ~27' BGS (but water table stabilized @ 32.5' BGS)
	34.4		φ φ ppm	n/a	n/a	
	35.4		φ φ ppm	n/a	n/a	
	36.4		φ φ ppm	NA	NA	
	37.4					
	38.4					N 563612.754 E 2377074.0
	39.4					
	39.5					B.O.B 39.5φ
	40.4					

78

PROJECT: PVAAP, LLI, Phase II, RI

HOLE NO: LLI-MW-83

D-37

MONITORING WELL

PROJECT NAME: Load Line 1 Phase II RI

DELIVERY ORDER NO: 003

WELL NUMBER: LL1mw083


BEGIN: 08-26-99

END: 08-27-99

COORDINATES:
N: 563612.754
E: 2377074.8

REFERENCE POINT: TDC

ELEVATION: 495.2 MSL FT

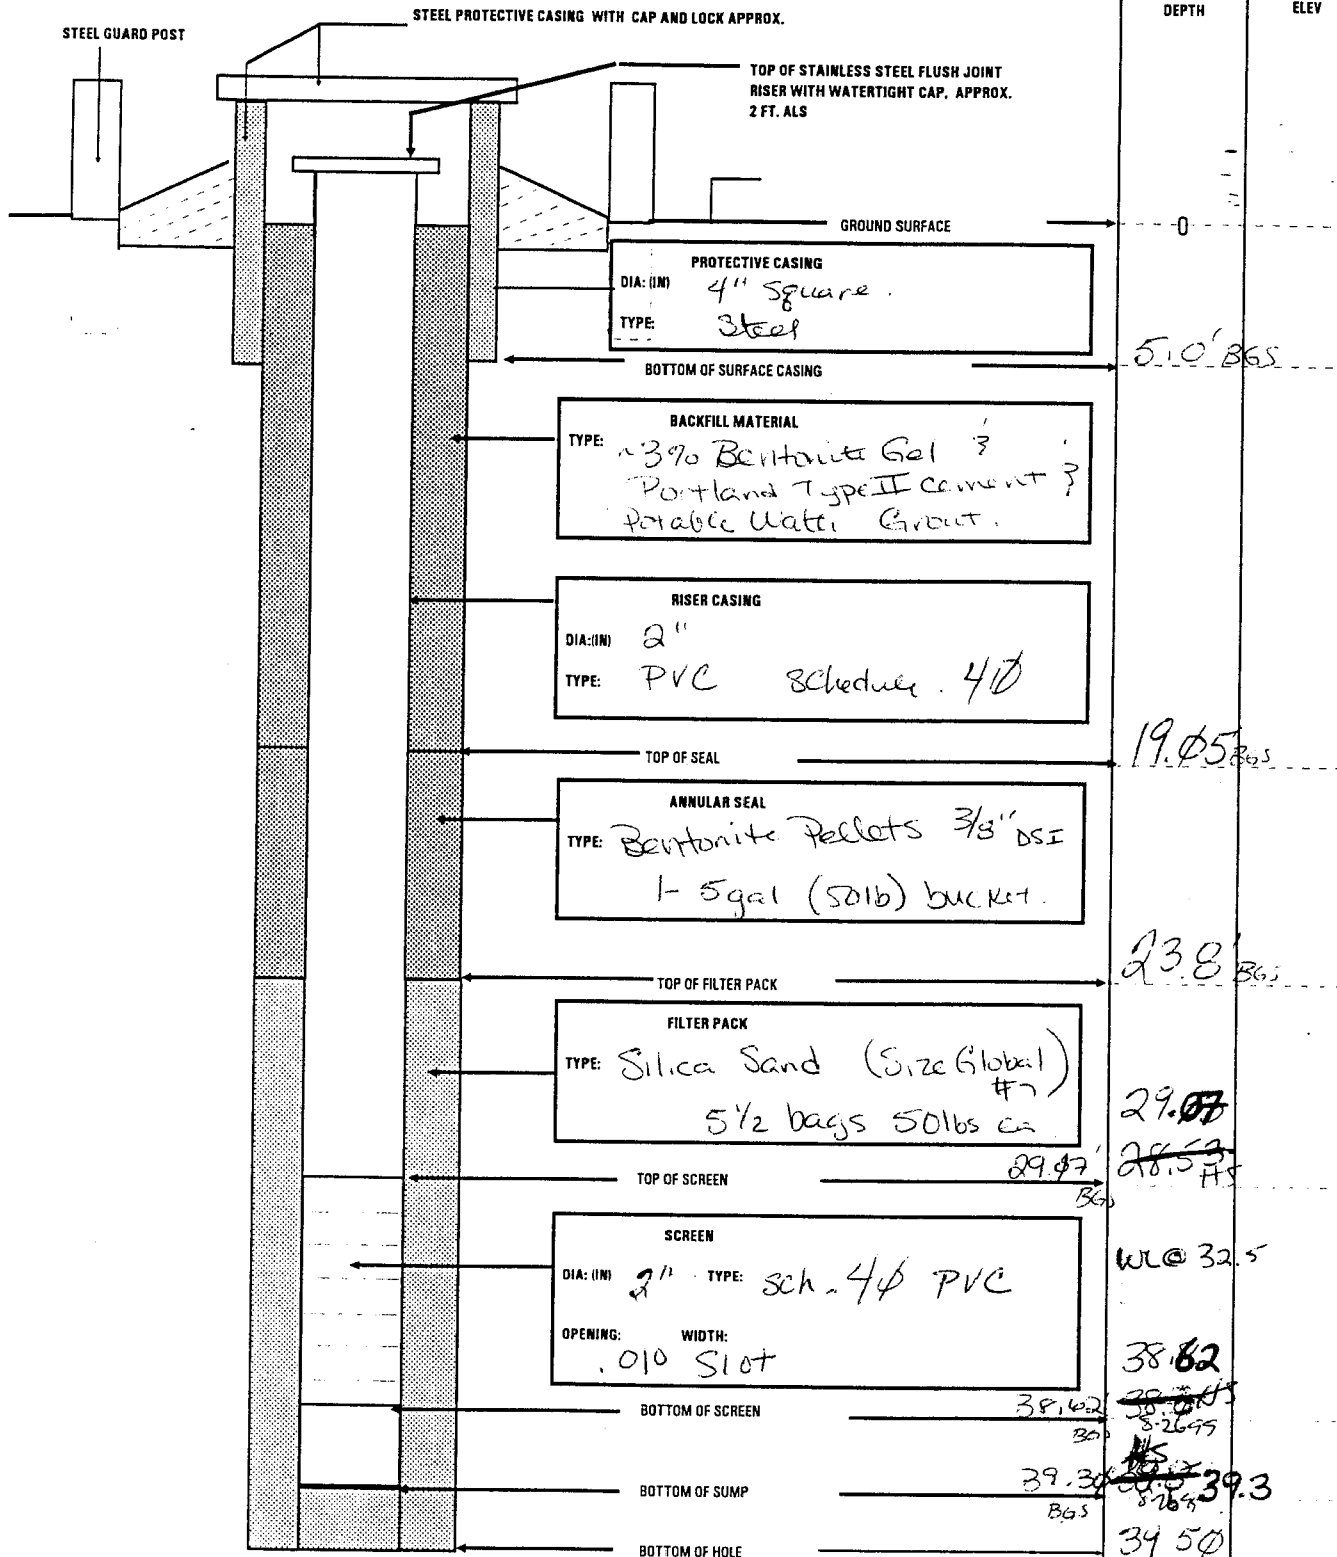

DEPTH ELEV

0

5.10' BGS

19.05' BGS

23.8' BGS

29.07

29.53' HS

WL @ 32.5

38.62

38.62
8-26-99

39.3
8-26-99

34.50


HOLE DIA: (IN)

7"

D-38

HTRW DRILLING LOG		DISTRICT Louisville		HOLE NUMBER LLmw084	
1. COMPANY NAME SAIC		2. DRILL SUBCONTRACTOR Miller Drilling Company		SHEET SHEETS 1 OF 5	
3. PROJECT RVAAP, Lead Line 1, Phase 2 RI		4. LOCATION Load Line 1, RVAAP			
5. NAME OF DRILLER Pete Brown		6. MANUFACTURERS DESIGNATION OF DRILL CME-75			
7. SIZES AND TYPES OF DRILLING AND SAMPLING EQUIPMENT 2" Split Spoon 6" tri cone roller bit 0375 ^a Air Compressor w/ air/oil separator. 1 support truck		8. HOLE LOCATION See map		9. SURFACE ELEVATION	
12. OVERBURDEN THICKNESS 2'		10. DATE STARTED 08-26-99		11. DATE COMPLETED 08-27-99	
13. DEPTH DRILLED INTO ROCK to 37.2' BGS		15. DEPTH GROUNDWATER ENCOUNTERED evidence there is some water at 27-28' BGS			
14. TOTAL DEPTH OF HOLE 37.2' BGS		16. DEPTH TO WATER AND ELAPSED TIME AFTER DRILLING COMPLETED 32.3' BGS after ~2 hrs.			
18. GEOTECHNICAL SAMPLES Not taken		19. TOTAL NUMBER OF CORE BOXES NA		17. OTHER WATER LEVEL MEASUREMENTS (SPECIFY) 29.10' BGS after ~16 hrs.	
20. SAMPLES FOR CHEMICAL ANALYSIS		DISTURBED		UNDISTURBED	
21. TOTAL CORE RECOVERY NA		VOC		OTHER (SPECIFY)	
22. DISPOSITION OF HOLE		METALS		OTHER (SPECIFY)	
BACKFILLED		MONITORING WELL		OTHER (SPECIFY)	
23. SIGNATURE OF INSPECTOR Heather J. Smith		2"		-	

LOCATION SKETCH/COMMENTS N 563160.442 E 2377316.02 SCALE: NONE

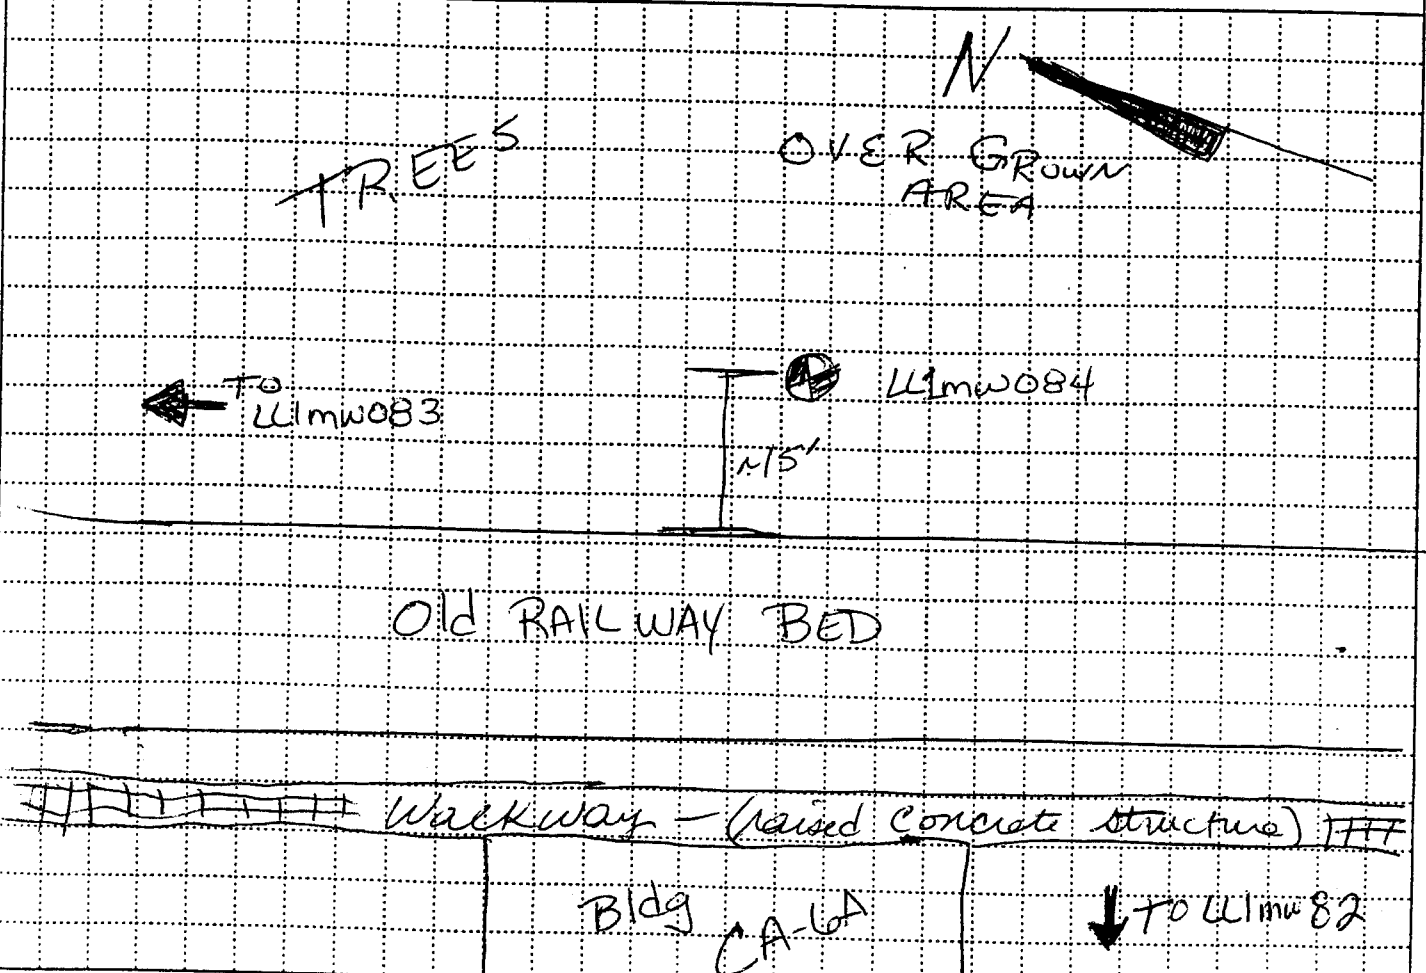

PROJECT RVAAP, Lead Line 1, Phase 2 RI	HOLE NO. LLmw084.
---	----------------------

DRILLING LOG

PROJECT		INSPECTOR			HOLE NUMBER	
RVAAP LI Phase 2 RI		Heather Smith			LL1mw 084	
DEPTH (ft)	DESCRIPTION OF MATERIALS (C1)	FIELD SCREENING RESULTS (C2)	GEOLOGIC SAMPLE OR CORE BOX NO (C3)	ANALYTICAL SAMPLE NO (C4)	REMARKS (C5)	
1.0	TOP Soil / Rocks Silt w/ sand DRY, hard. Sandy Silt	2Φ.6% 02			Split Spoon ran to 2.0' BGS. TOP of Rock at 2.1'. AT. Top of Rock - began air rotary Split Spoon: RW 2.Φ Rec. 2.Φ	
2.0	TOP of Rock Sandstone Med-fine grained 2.5y 6/2 lt. brownish gray dry	2Φ.6% 02	N2	N2	Descriptions are of Cuttings during Air Rotary drilling. Depths are approx. due to time laps between actual drilling at depth & blowing cuttings out of the top of the hole	
7.0	Sand stone fine to med. grained 2.5y 6/2 lt brownish gray dry	2Φ.6% 02	N2	N2	Running @ 1' / Per 10 minutes.	

89

DRILLING LOG

90

PROJECT: RUAAP, Load Line 1, Phase 2 RI OPERATOR: Heather Smith HOLE NUMBER: LL1mw 84 SHEET: 3 of 5

DEPTH (A)	DEPTH (B)	DESCRIPTION OF MATERIALS (C)	FIELD SCREENING RESULTS (D)	GEOCHEM SAMPLE OR CORE BOX NO (E)	ANALYTICAL SAMPLE NO (F)	REMARKS (G)
	11.0	Sandstone fine-med. grained 2.5-6.12 H. brownish dry grey	φ	N2	N2	Air Rotary Drilling looking @ cuttings
	12.0		φ			
	13.0		φ	NA	NA	
	14.0		φ			
	15.0		φ	NA	NA	
	16.0	Same as above	φ	NA	NA	
	17.0		φ			
	18.0		φ	NA	NA	
	19.0		φ			
			φ			

PROJECT: RUAAP, LL1, Phase 2 RI

HOLE NO: LL1mw 84

D-41

DRILLING LOG

91

PROJECT RVAAP, LLI @ Phase 2 RI SUPERVISOR Kathy L. Smith HOLE NUMBER LLimw084 SHEET 4 of 5

DEPTH (ft)	DESCRIPTION OF MATERIALS (C)	FIELD SCREENING RESULTS (D)	GEOCHEM SAMPLE OR CORE BOX NO (E)	ANALYTICAL SAMPLE NO (F)	REMARKS (G)
21.0	Same as above	φ	NA	NA	Air rotary drilling toolings @ cuttings
22.0		φ			
23.0			NA	NA	
24.0		φ			
25.0			NA	NA	
26.0	Same as above w/ slightly less staining on rock	φ			
27.0		φ	NA	NA	Cuttings get moist some water evident between 27.0' & 28.0' BGS
28.0		φ			
29.0			NA	Σ	Color turned to grey not as much brownish staining water level @ 29.10' BGS after standing 12+ hrs.
30.0		φ			

PROJECT

D-42

HOLE NO

RVAAP, Phase 2 RI @ LLI

LLimw 084

DRILLING LOG

PROJECT RVAAP, Phase 2, RI@LLI

INSPECTOR H. Smith

HOLE NUMBER LLI mw 084

99

SHEET 5 of 5

ELEV (A)	DEPTH (B)	DESCRIPTION OF MATERIALS (C)	FIELD SCREENING RESULTS (D)	GEOCHEM SAMPLE OR CORE BOX NO (E)	ANALYTICAL SAMPLE NO (F)	REMARKS (G)
30.4		Same as above	∅	NA	NA	
31.4						
32.4			∅	NA	NA	
33.4						* Water table recharge to 32.3 after ~ 2 hrs. - Recharged to 29.10' after 12+ hrs.
34.4			∅	NA	NA	
35.4						
36.4			∅	NA	NA	
37.4						B.O.B. 37.2
38.4						N 563160.442 E 2377316.02
39.4						
40.4						

PROJECT RVAAP, Phase II RI@LLI

D-43


HOLE NO LLI mw 084

MONITORING WELL

PROJECT NAME: Load Line 1 Phase II RI

DELIVERY ORDER NO: 003

WELL NUMBER: LL1mw084	BEGIN: 08 27-99	END: 03 27-99
COORDINATES: N: 563160.442 E: 2377316.02	REFERENCE POINT: TDC	ELEVATION: 198.73 MSL FT.

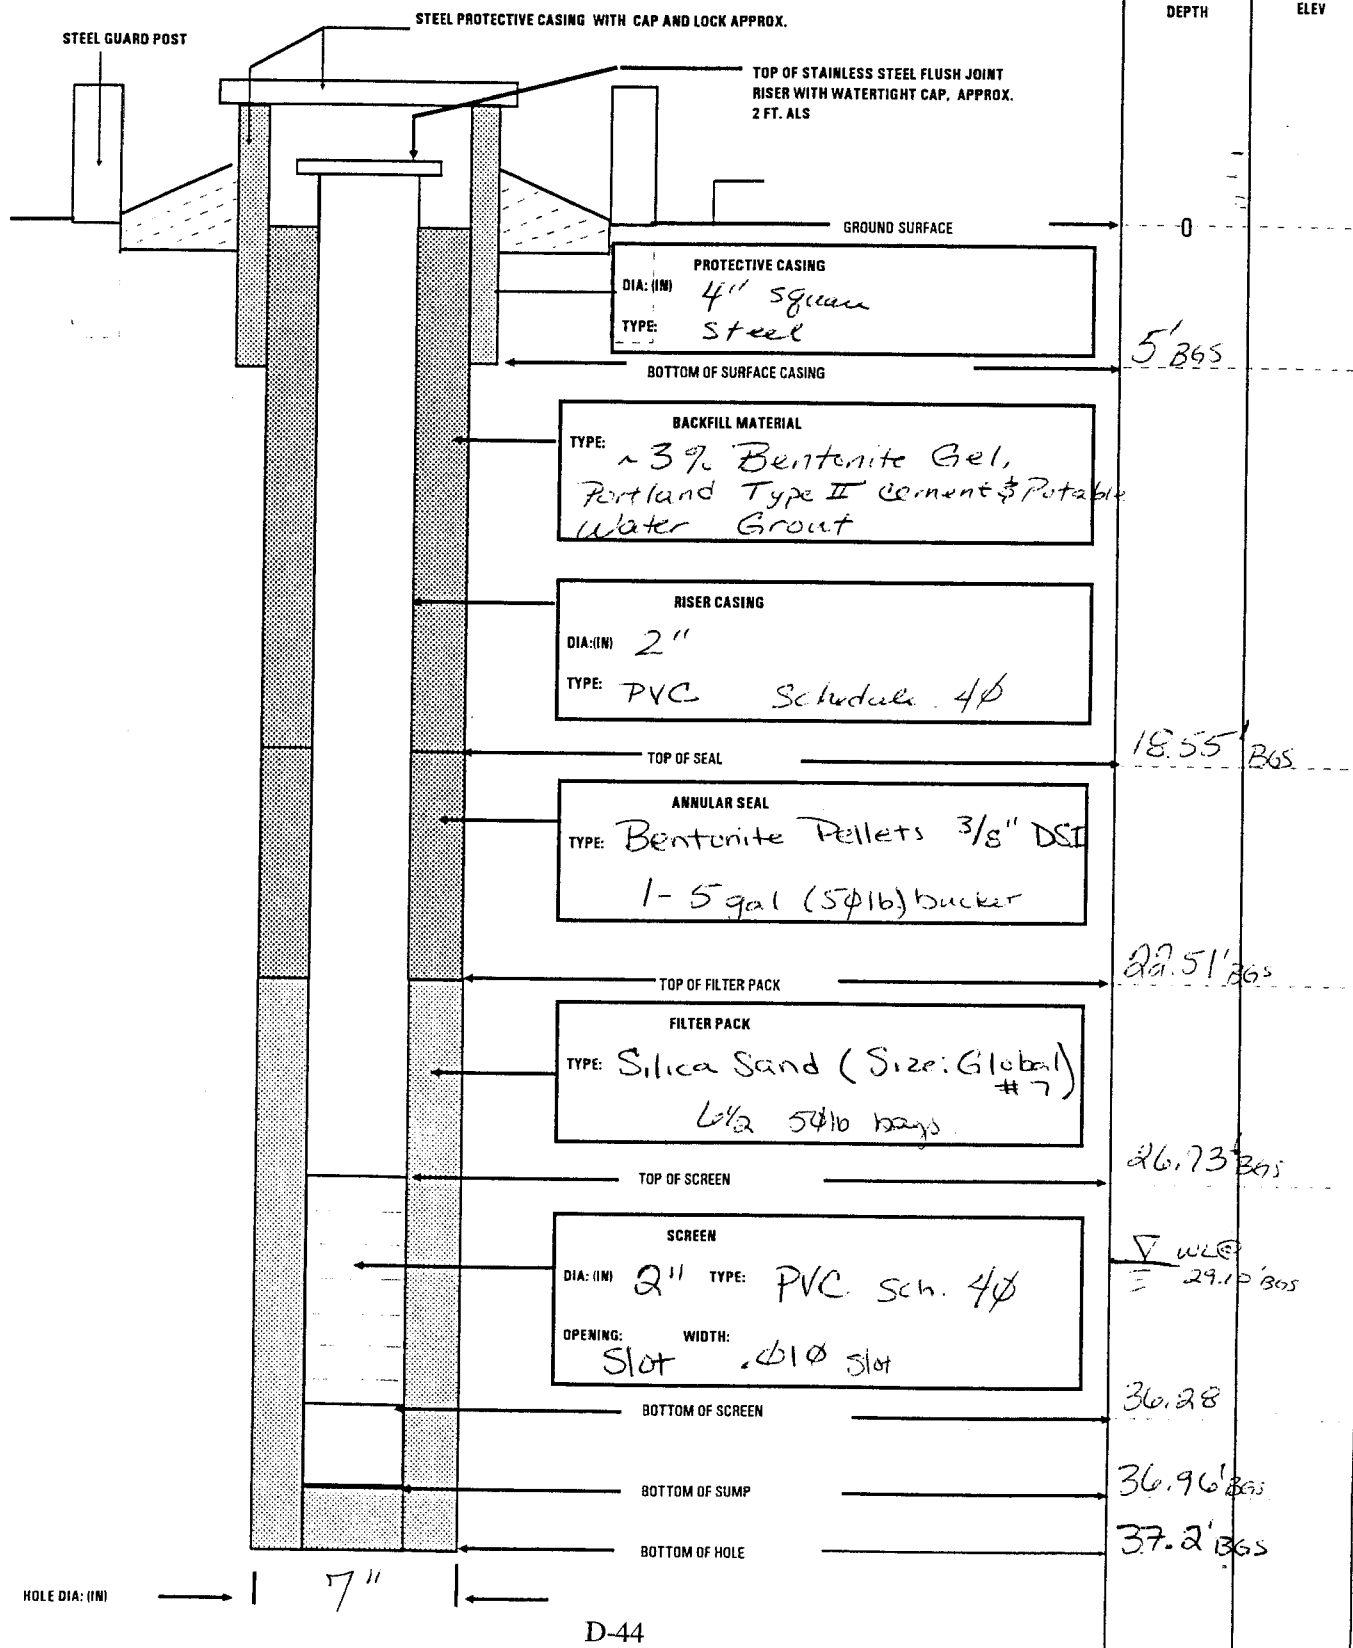

HTRW DRILLING LOG

DISTRICT

Louisville

HOLE NUMBER

MW-85

1 COMPANY NAME

SAIC

2 DRILL SUBCONTRACTOR

Miller Drilling Co.

SHEET

1 OF 5 SHEETS

3 PROJECT

RVAAP, LL1, Phase II RI

4 LOCATION

RVAAP, LL1, Ravenna Ohio

5 NAME OF DRILLER

P. Brown

6 MANUFACTURERS DESIGNATION OF DRILL

CME-75

7 SIZES AND TYPES OF DRILLING AND SAMPLING EQUIPMENT

2" Spl. + 5' run (steel)
4 1/4" ID HSA, 6" PVC

8 HOLE LOCATION

See Sketch Below

9 SURFACE ELEVATION

10 DATE STARTED

08/17/99

11 DATE COMPLETED

08/21/99

12 OVERBURDEN THICKNESS

6.1' BGS

13 DEPTH GROUNDWATER ENCOUNTERED

Using water to core, could not identify where ground water first encountered

13 DEPTH DRILLED INTO ROCK

38.9' BGS Total (6.1' - 45.0' BGS)

16 DEPTH TO WATER AND ELAPSED TIME AFTER DRILLING COMPLETED

35.5' BGS after 1hr / 35.5' after 24 hrs.

14 TOTAL DEPTH OF HOLE

45.0' BGS

17 OTHER WATER LEVEL MEASUREMENTS (SPECIFY)

18 GEOTECHNICAL SAMPLES

15x3 ft of core / Shelby tubes

DISTURBED

N/A

UNDISTURBED

Shelby Tubes

19 TOTAL NUMBER OF CORE BOXES

4

20 SAMPLES FOR CHEMICAL ANALYSIS

None

VOC

N/A

METALS

N/A

OTHER (SPECIFY)

N/A

OTHER (SPECIFY)

N/A

OTHER (SPECIFY)

N/A

21 TOTAL CORE RECOVERY %

98%

22 DISPOSITION OF HOLE

installed well

BACKFILLED

N/A

MONITORING WELL

2" PVC

OTHER (SPECIFY)

N/A

23 SIGNATURE OF INSPECTOR


Matthew B. Vest

LOCATION SKETCH/COMMENTS

N 562046.245 E 237746.938

SCALE:

NOT TO SCALE

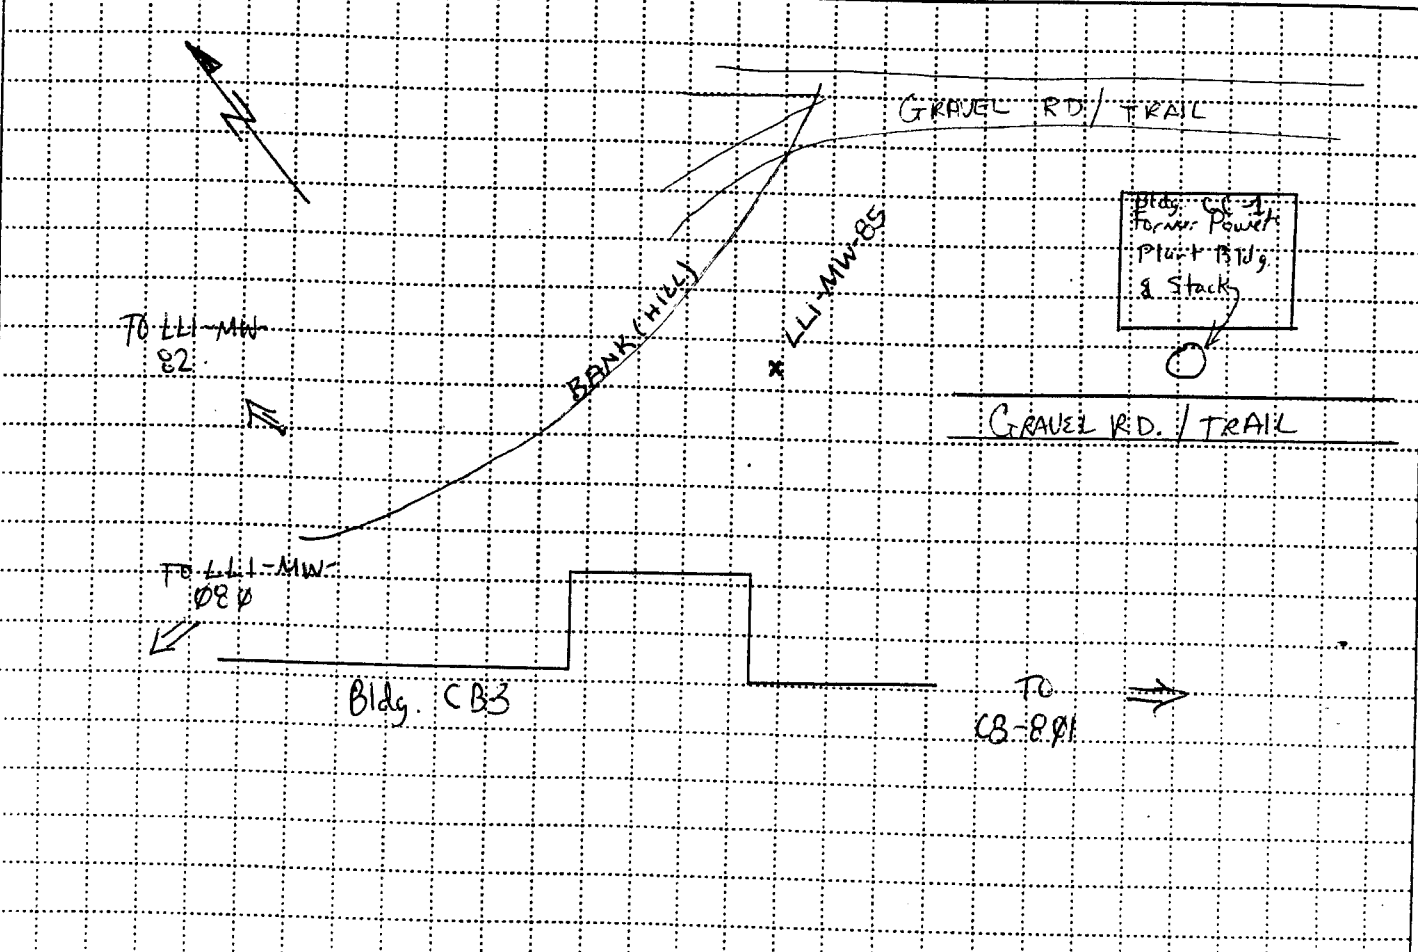

PROJECT

RVAAP, LL1, Phase II, RI

HOLE NO

LL1-MW-85

DRILLING LOG

5

PROJECT		INSPECTOR			HOLE NUMBER	
RVAAP, LLI, Phase II RI		M. Vest			LLI-MW- 84 85	
DEPTH (ft)	DEPTH (ft)	DESCRIPTION OF MATERIALS (C)	FIELD SCREENING RESULTS (D)	GEOLOGIC SAMPLE OR CORE LOG NO (E)	ANALYTICAL SAMPLE NO (F)	REMARKS (G)
	1.0	Top soil w/ grass roots & rock fragments $\phi .3$	$\phi . \phi$ ppm		N/A	sample w/ 2" split spoon $\phi . 0$ to $\phi . 3'$ Refusal. Auger $\phi . 3'$ - 2 $\phi . 8$ GCS. Run $\phi . 3'$ Rec $\phi . 3'$
		No Sample Taken.				
	2.0	SILTY SAND, 1 ϕ YR $\frac{1}{2}$ v. pale brown, loose, non-plas., v. f. gr., dry, w/ 45% rock fragments (SS) up to 2" dia.	$\phi . 2$ ppm		N/A	Push/Drive spoon 2.0' - 4.0' BCS. Run 2.0' Rec 1.0'
	3.0	No Recovery.				No recovery 3.0' - 4.0' BCS due to spoon shoe plugged w/ rock fragments.
	4.0	SILTY SAND, 1 ϕ YR $\frac{1}{2}$, v. pale br., med. to hard, non-plas., v. f. gr., dry w/ 45% rock fragments (sandstone) up to 2" dia.	$\phi . 2$ ppm		N/A	Push/Drive spoon 4.0' - 5.0' BCS. Run 2.0' Rec 1.2'
	5.0	No Recovery				No recovery 5.2' to 6.0' BCS due to spoon shoe plugged w/ rock fragment
	6.0	Same as above		6.1	N/A	Spoon refusal @ 6.1' BCS. Begin coring @ 6.1' BCS.
	7.0	SANDSTONE, thin bedded, 2.5Y 7/2 light gray, hard, mod. cemented, m. gr., horizontal bedding, weathered moderately, breaks continuously (weathered), lossy	$\phi . \phi$ ppm	Box 1 of 4		Loss of circulation within 0.5 ft into rock (6.6' BCS). Corel 5.0' (6.1' - 11.1' BCS) Rec 3.4' Loss 1.6' RQD = ϕ
	8.0		$\phi . \phi$ ppm		N/A	Fractures occur every 0.1 - 0.4' throughout core.
	9.0	SANDSTONE w/ silt, thin bedded, shale lens, 7.5Y 10/2 gray, medium hardness moderately cemented, f. gr., st. wea., breaks common (weathered).	$\phi . \phi$ ppm		N/A	
	10.0	SHALE, thin bedded, 5Y 10/2 greenish gray, soft, hor. z. bedding, highly wea., core loss from (cont)				

DRILLING LOG

HOLE NUMBER
LLI-MW-85

PROJECT RVAAP, LLI, Phase II RI

INSPECTOR M Vest

SHEET 3 of 5

DEPTH (A)	DEPTH (B)	DESCRIPTION OF MATERIALS (C)	FIELD SCREENING RESULTS (D)	GEOLOGIC SAMPLE OR CORE BOX NO (E)	ANALYTICAL SAMPLE NO (F)	REMARKS (G)
	9.5	9.5' to 11.1' BGS. Bottom of shale interval (9.5' BGS) weathered to a clay.	φ φ ppm	Box 1 of 4 (Cont)	n/a	Loss of core from 9.5' - 11.1' BGS. Probable weathered shale interval too soft to core. Bottom of recovered core (9.5' BGS) is highly wea. shale.
	11.0	No Recovery				
	11.0	SANDSTONE, thin bedded, 7/8 lt. gray, hard, mod. cemented, f-m gr., 10° from horiz. bedding, unwea., breaks common w/ wea. staining on 11.4' BGS break, shale partings common less than φ. 0.01' thick.	φ φ ppm	Box 2 of 4	n/a	Cored 5.3' (11.1' - 16.4' BGS) Rec 5.3' - Loss φ. φ - Picked ^{up} piece $RQD = \frac{1.4}{5.3} = .264$
	12.4					
	13.4					
	14.4		φ. φ ppm		n/a	
	15.4					
	16.4		φ φ ppm	Box 3 of 4	n/a	
	16.4	SANDSTONE, thin bedded, 7/8 lt. gray, hard, mod. cemented, m. gr., 10° from hori. bedding, unwea., breaks common, shale parting common < φ. 0.01' thick.	φ φ ppm		n/a	Cored 5.0' (16.4' - 21.4' BGS) Rec 5.0' Loss φ. φ' $RQD = \frac{2.1}{5.0} = .42$
	17.4					
	18.4		φ. φ ppm		n/a	
	19.4					
	20.0		φ. φ ppm		n/a	

DRILLING LOG

HOLE NUMBER
LLI-MW-85

7

PROJECT RVAAP, LLI, Phase II RI

INSPECTOR NJWEST

SHEET 4 of 5

DEPTH (ft)	DESCRIPTION OF MATERIALS (C)	FIELD SCREENING RESULTS (D)	GEOCHEM SAMPLE OR CORE BOX NO (E)	ANALYTICAL SAMPLE NO (F)	REMARKS (G)
21.0	Same as above.	φ. 0 ppm	Box 3 of 4 (Cont)	N/A	Roller bit broke to 7" dia using water to dr. 11. (WL @ 12.3' BGS after pumping drilling circulating water out of hole & waiting 15 min. prior to roller bit dr. 11ing)
21.4	End coring @ 21.4' BGS.		Box 4 of 4	N/A	
22.0	Sandstone, f-m grained, 7/8 lt. gray, dry.	φ. 0 ppm	N/A	N/A	Water w/ roller bit not working due to no circulation. Begin air rotary to ream out borehole on 08/20/99.
23.0					Rig breakdown 08/20/99 @ 16:00 @ 32' BGS.
24.0		φ. 9 ppm	N/A	N/A	Cont. air rotary after rig repair. 08/21/99 @ 13:05.
25.0					Cont. @ 32.0' BGS.
26.0		φ. 0 ppm	N/A	N/A	Air rotary through at uncased rock advancing ~ 1' per 10 min.
27.0					
28.0		φ. 0 ppm	N/A	N/A	
28.5					
29.0					
30.0		φ. 0 ppm	N/A	N/A	

PROJECT RVAAP, LLI, Phase II RI

D-48

HOLE NO LLI-MW-85

DRILLING LOG

HOLE NUMBER
LLI-mw-85

8

PROJECT RVAAP, LLI, Phase II PI

INSPECTOR M. Vest

SHEET 5 of 5

DEPTH (A)	DEPTH (B)	DESCRIPTION OF MATERIALS (C)	FIELD SCREENING RESULTS (D)	GEOLOGIC SAMPLE OR CORE BOX NO (E)	ANALYTICAL SAMPLE NO (F)	REMARKS (G)	
	31.0	Sandstone, f-m gr, thin lt. gray, dry to moist.	φ. 0 ppm	N/A	N/A	Cont. air rotary @ 32.0' BGS on 8/21/99. No water bloom w/ air w.l. prior to drilling @ 31.7' BGS.	
	32.0		φ. 0 ppm	N/A	N/A		
	33.0						
	34.0			φ. 0 ppm	N/A		N/A
	35.0						
	36.0		φ. 0 ppm	N/A	N/A		
	37.0						
	38.0		φ. 0 ppm	N/A	N/A		
	39.0						
	40.0	Cuttings wet below ~40.0' BGS, when cuttings return is present.	φ. 0 ppm	N/A	N/A	At 40.0' BGS. can hear water in borehole being blown by air. No wet cutting or water @ surface from air return. w.l. @ 35.5' BGS.	
	41.0		φ. 0 ppm	N/A	N/A		
	42.0		φ. 0 ppm	N/A	N/A		
	43.0		φ. 0 ppm	N/A	N/A		
	44.0		φ. 0 ppm	N/A	N/A		
	45.0	45.0					
		End drilling @ 45.0' BGS				End air rotary @ 45.0' BGS. Total amount of water injected was used for coring/drilling was ~100 gal. N 562046.245 E 2377246.938	

PROJECT RVAAP, LLI, Phase II, PI

D-49

HOLE NO LLI-mw-85


MONITORING WELL

PROJECT NAME: Load Line 1 Phase II RI

DELIVERY ORDER NO: 003

WELL NUMBER: ~~LL-105~~ ~~LL-107~~ ~~LL-108~~ **LLI-MW-85** BEGIN: ~~10/23/95~~ END: 08/23/99

COORDINATES: N: 562046.245 REFERENCE POINT: TDC ELEVATION: 996.54 MSL FT
 E: 2377246.938

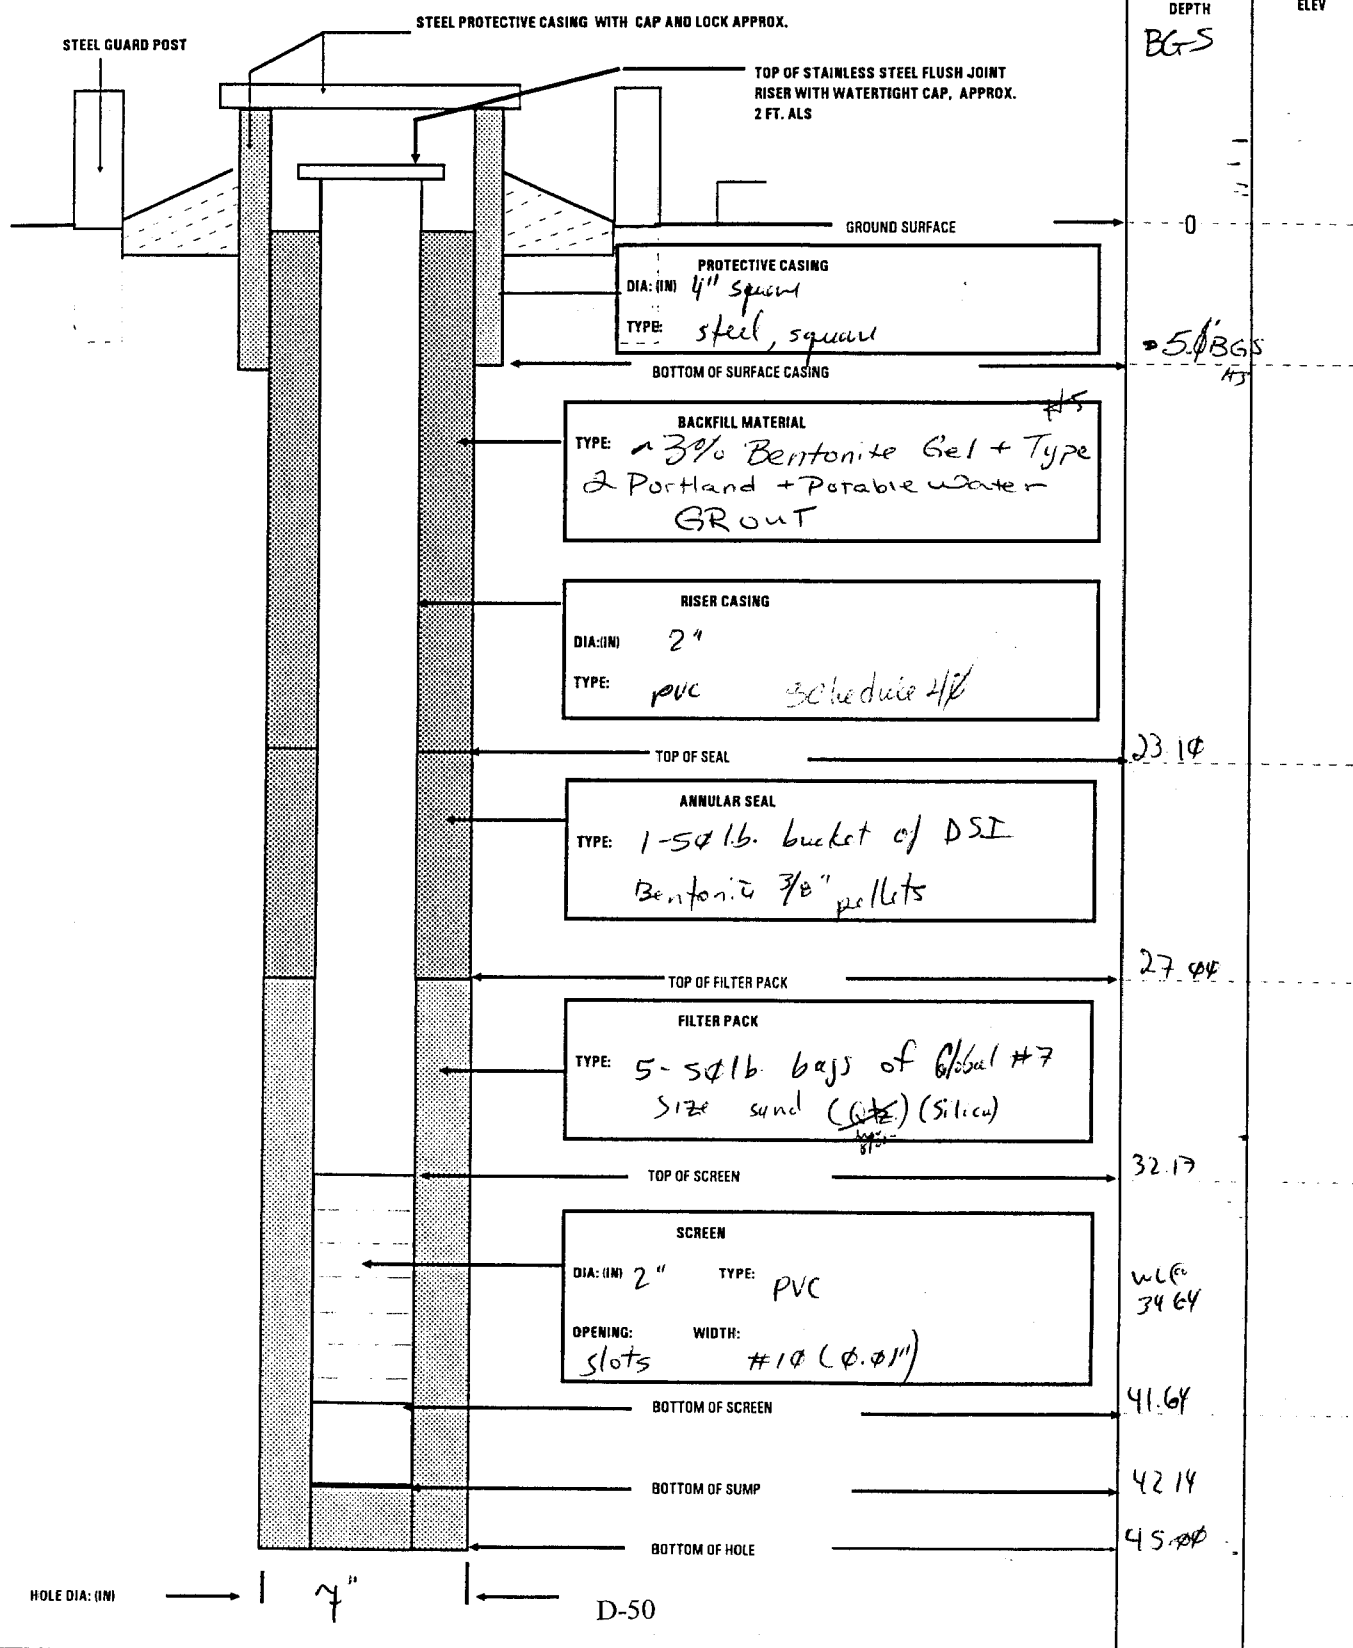


**Load Line 1 Phase II RI
Monitoring Well Installation Logs**

LL1-MW-063	D-53
LL1-MW-064	D-58
LL1-MW-065	D-62
LL1-MW-067	D-66
LL1-MW-059	D-71
LL1-MW-060	D-75

THIS PAGE INTENTIONALLY LEFT BLANK

HTRW DRILLING LOG		DISTRICT Nashville		HOLE NUMBER LL1MW63	
1. COMPANY NAME SAIC		2. DRILL SUBCONTRACTOR Alliance Environmental		SHEET 1 OF 4 SHEETS	
3. PROJECT RVAAP			4. LOCATION Lead Line 1 - RVAAP		
5. NAME OF DRILLER Dave Newman			6. MANUFACTURERS DESIGNATION OF DRILL CME-55		
7. SIZES AND TYPES OF DRILLING AND SAMPLING EQUIPMENT		8. HOLE LOCATION		9. SURFACE ELEVATION	
CME 55 AAV 6 5/8 in ID Hollow stem auger's w/ 2 1/2 in log / 2 in diameter split spoon 6 1/4 in diameter friction bit for air rotary using an Ingersoll Rand 375 air compressor		SEE SKETCH BELOW			
12. OVERBURDEN THICKNESS 3.1 ft BGS		10. DATE STARTED 7/27/96		11. DATE COMPLETED 7/30/96	
13. DEPTH DRILLED INTO ROCK 27.4 ft BGS		15. DEPTH GROUNDWATER ENCOUNTERED 19 ft		16. DEPTH TO WATER AND ELAPSED TIME AFTER DRILLING COMPLETED 19.88 ft BGS on 7/31/96 @ 1000 g	
14. TOTAL DEPTH OF HOLE 27.4 ft BGS		17. OTHER WATER LEVEL MEASUREMENTS (SPECIFY)			
18. GEOTECHNICAL SAMPLES NA		DISTURBED NA	UNDISTURBED NA	19. TOTAL NUMBER OF CORE BOXES NA	
20. SAMPLES FOR CHEMICAL ANALYSIS NA		VOC NA	METALS NA	OTHER (SPECIFY) NA	OTHER (SPECIFY) NA
22. DISPOSITION OF HOLE Monitoring well		BACKFILLED NO	MONITORING WELL LL1MW-63	OTHER (SPECIFY) NO	21. TOTAL CORE RECOVERY 100%
				23. SIGNATURE OF INSPECTOR Susan J. [Signature]	

LOCATION SKETCH/COMMENTS SCALE: **1" = 100'**

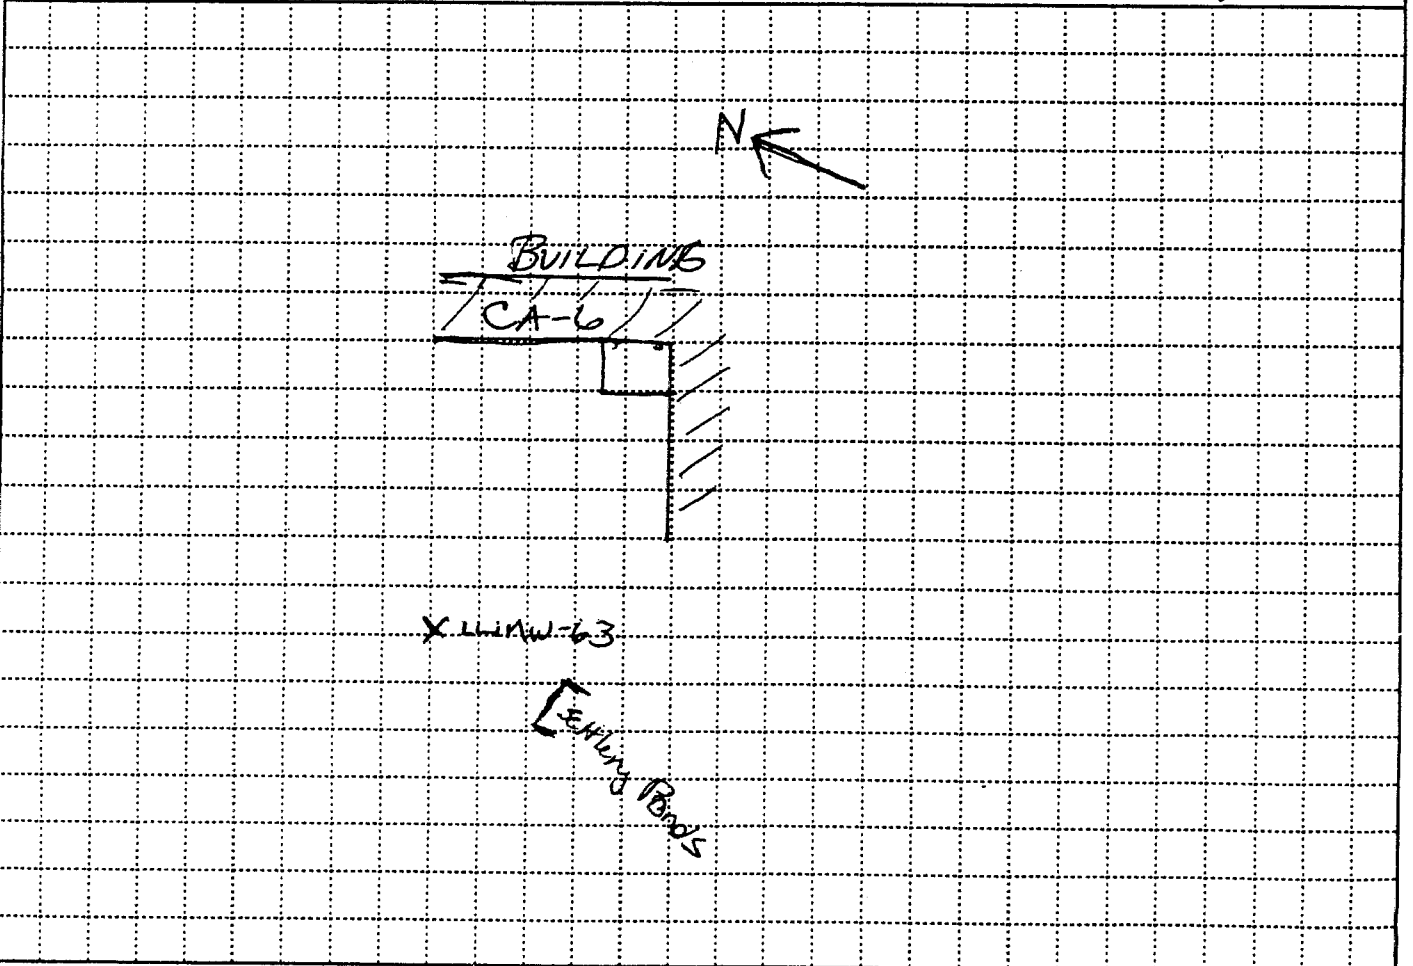

PROJECT RVAAP DO # 0022	HOLE NO. LL1MW-63
--------------------------------	--------------------------

HTRW DRILLING LOG

HOLE NUMBER LL1MW-63

PROJECT RVAAP DO# 022

INSPECTOR J.L. Abston

SHEET 2 of 4

ELEV. (A)	DEPTH (B)	DESCRIPTION OF MATERIALS (C)	FIELD SCREENING RESULTS (D)	ANALYTICAL SAMPLE NO. (E)	ANALYTICAL SAMPLE NO. (F)	REMARKS (G)
	0.5	CL, sandy silty clay, med plastic soft, dry, 7.5YR 4/1 dark grayish brown	0.0	3	3	Recovery @ 1633 1.0 ft / 2.0 ft
	0.5	SW, sand w/ rock frag + gravel, loose, dry, 7.5YR 3/1 very dark gray, Rocks consist of sandstone and slag frag.	0.0	14	14	
				13	NA	
				7	7	
		CL, silty (30%) clay med. plastic, very stiff 10YR 6/1, gray mottled with 10YR 4/4 dark yellowish brown, dry weathered fine to med grain sandstone, SW 7.5YR 6/2 pinkish gray to 10YR 6/4 light yellowish brown	0.0 ppm	5	5	Split Spoon Refusal at 3.1 ft BGS Recovery @ 1515 1.1 ft / 1.1 ft
				11	11	Augering w/ sender stem, no split spoon
				5 1/2	5 1/2	
				NA	NA	Augering through weathered sandstone
						Auger refusal at 4.5 ft BGS. Adding 6/4 in tricone bit to air rotary sandstone
		Fine grain, well graded sandy SW, dry, softer than above				
		Fine grain, ^{SP} sand dry, 10YR 6/4 light yellowish brown mottled w/ 10YR 6/6 brownish yellow, Not uniform sizes - may be weathered or fractured	0.0 ppm			Add another rod

PROJECT RVAAP

HOLE NO. LL1MW-63

HTRW DRILLING LOG

HOLE NUMBER **LLIMW-63**

PROJECT **RVAAP**

INSPECTOR **S. Absten**

SHEET **3 of 4**

ELEV. (A)	DEPTH (B)	DESCRIPTION OF MATERIALS (C)	FIELD SCREENING RESULTS - DVA	GEOTECH SAMPLE OR CORE BOX NO (E)	ANALYTICAL SAMPLE NO. (F)	REMARKS (G)
			D.P ppm	NA	NA	
			D.P ppm			Add another rod
	15	SW, fine grain, sand slightly damp, 10YR/5/6 yellowish brown with sand larger rock fragments Prob weathered fractured zone				Ratty drilling
	14	Returned to a SP, fine grain sand, dry 10YR 6/4 light yellowish brown	D.P ppm			
	7.2	SW, fine grain sand, slightly damp, 10YR 6/5 yellow with weathering, angular sandstone frag.				Arcing cutter rod Resist layer
	7.9	SP, fine grain sand, 10YR 6/4 light yellowish brown				Less resistant drilling
						Water stabilizes at 19 ft BGS

PROJECT **RVAAP**

HOLE NO. **LLIMW-63**

HTRW DRILLING LOG

HOLE NUMBER LL1MW-63

PROJECT RVAAD DO # 0022

INSPECTOR S.L. Alan

SHEET 4 of 7

ELEV (A)	DEPTH (B)	DESCRIPTION OF MATERIALS (C)	FIELD SCREENING RESULTS (D)	GEOTECH SAMPLE OR CORE BOX NO (E)	ANALYTICAL SAMPLE NO (F)	REMARKS (G)
		Same as above	Φ, Φ ppm		NA	Adding rod at 22 ft BGS. * pulling up to let borehole set open to check for water (W41)
	22	Fine to med. grain size sandstone, moist, 100R 7/4 very pale brown w/ increasing fragments of 2 7/1 light bluish grey sand - weathered	Φ, Φ ppm			At 0639 7/29/96 3.17 ft of water in borehole. Drilling an additional 5 ft Ratty drilling
	23.5	Same as above w/ less larger fragment				
	20	Increase in larger fragments	Φ, Φ ppm			Ratty drilling
	27.4					Stop drilling @ 27.4 ft BGS to set well Field Reading with Mini Ree # 000617 and MX 251 LEL/O2 meter #2330 (Hazeo)

PROJECT RVAAD


HOLE NO. LL1MW-63

MONITORING WELL


PROJECT NAME: RVAAP

DELIVERY ORDER NO: 0022

WELL NUMBER: LL1 MW-63	BEGIN: 7/29/96	END: 7/29/96
COORDINATES: N: E:	REFERENCE POINT: MSL	ELEVATION:

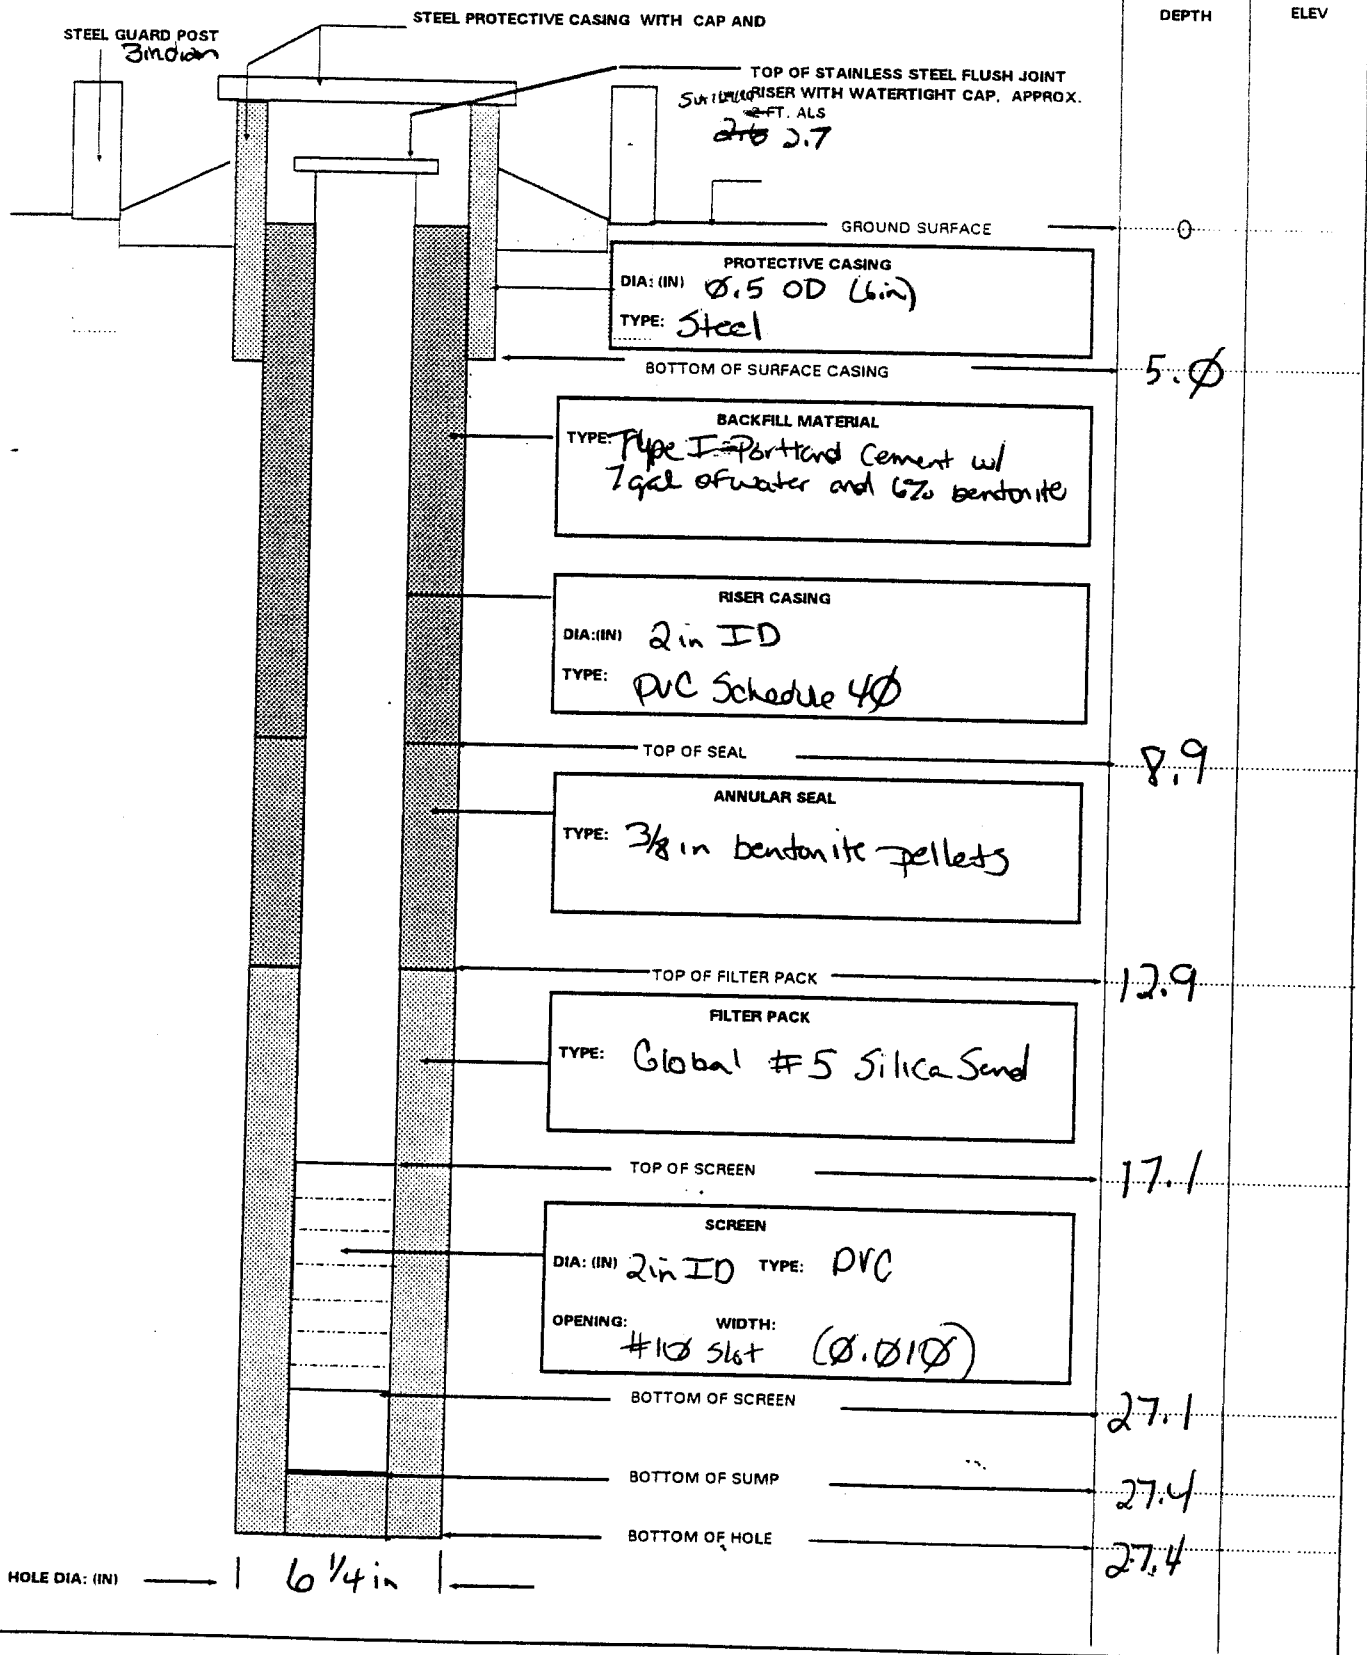

HTRW DRILLING LOG		DISTRICT NASHVILLE		HOLE NUMBER LLIMW-64	
1. COMPANY NAME SAIC		2. DRILL SUBCONTRACTOR Alliance Environmental		SHEET SHEETS 1 OF 3	
3. PROJECT 541234 RAA RVAAP			4. LOCATION Load Line 1 Ravenna Army Arm. Plant		
5. NAME OF DRILLER James Bennett			6. MANUFACTURERS DESIGNATION OF DRILL CME-55		
7. SIZES AND TYPES OF DRILLING AND SAMPLING EQUIPMENT CME 55, 6 5/8" ID Hollow Stem Augers w/ 2 ft. 3 in diameter split spoons		8. HOLE LOCATION SEE SKETCH BELOW			
		9. SURFACE ELEVATION			
		10. DATE STARTED 7/23/96		11. DATE COMPLETED 7/23/96	
12. OVERBURDEN THICKNESS NA		15. DEPTH GROUNDWATER ENCOUNTERED 6.3 ft BGS			
13. DEPTH DRILLED INTO ROCK NA		16. DEPTH TO WATER AND ELAPSED TIME AFTER DRILLING COMPLETED 3.03 BTDC 7/29/96 @ 1335			
14. TOTAL DEPTH OF HOLE 18 ft		17. OTHER WATER LEVEL MEASUREMENTS (SPECIFY) 3.02 BTDC 7/30/96 @ 1321			
18. GEOTECHNICAL SAMPLES NA		DISTURBED NA	UNDISTURBED NA	19. TOTAL NUMBER OF CORE BOXES NA	
20. SAMPLES FOR CHEMICAL ANALYSIS NA		VOC NA	METALS NA	OTHER (SPECIFY) NA	OTHER (SPECIFY) NA
21. TOTAL CORE RECOVERY % 79		OTHER (SPECIFY) NA	OTHER (SPECIFY) NA	23. SIGNATURE OF INSPECTOR Susan J. Johnston	
22. DISPOSITION OF HOLE M.W. Installed		BACKFILLED NA	MONITORING WELL 7/23/96	OTHER (SPECIFY) NA	

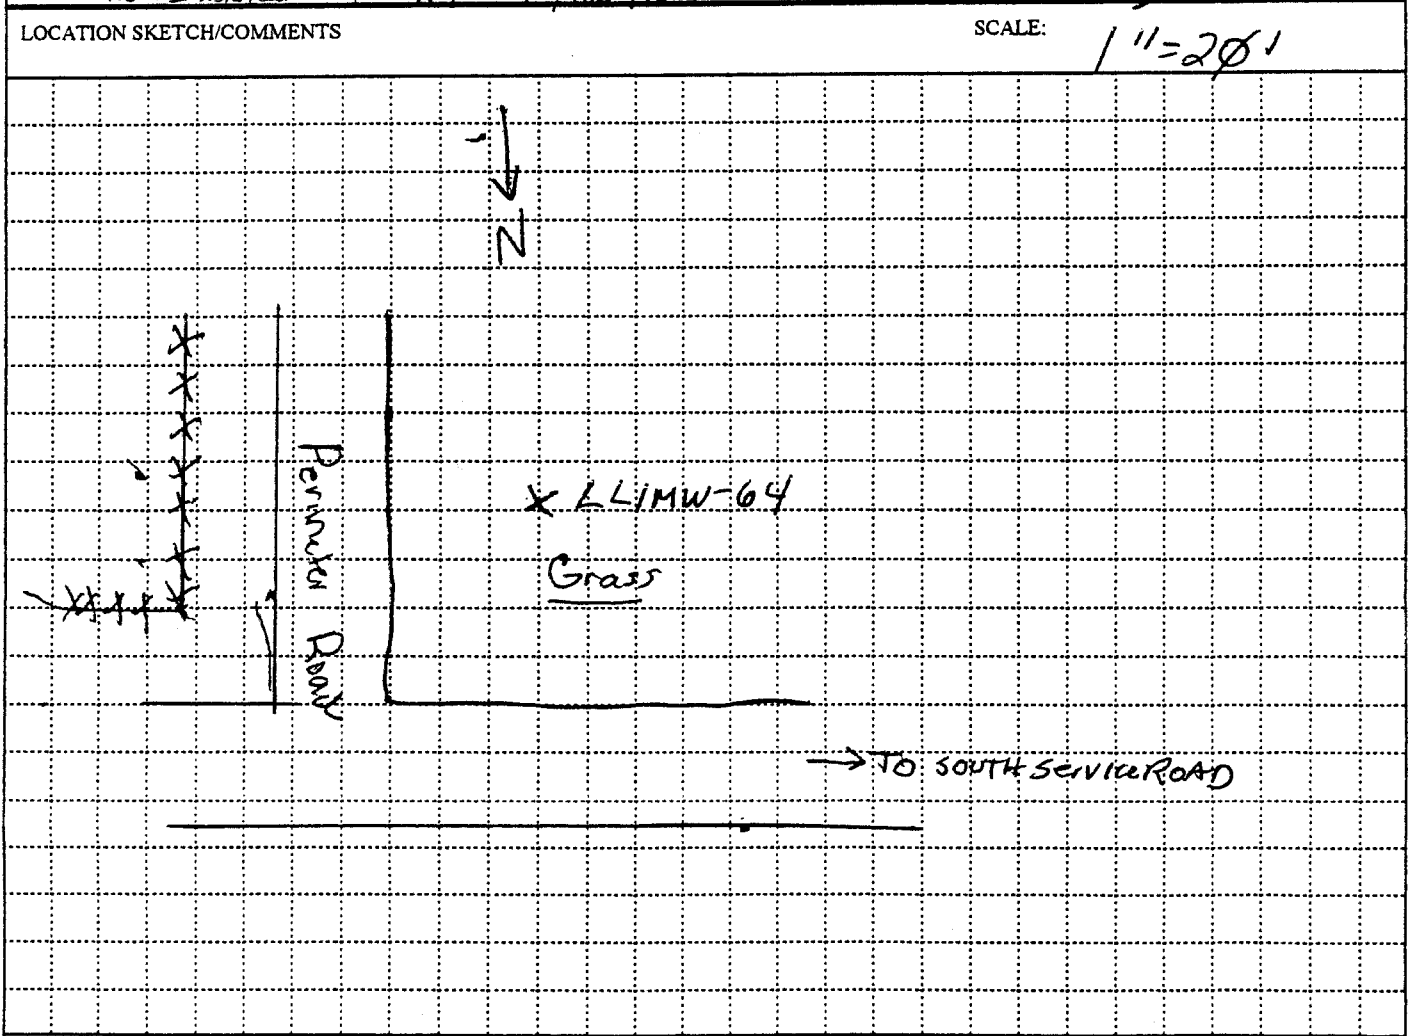

PROJECT RVAAP DO# 00ZZ	HOLE NO. LLIMW-64
---------------------------	----------------------

HTRW DRILLING LOG

HOLE NUMBER
LL1MW-064

SHEET 2 of 3

PROJECT
KVAAP

INSPECTOR

SLABSTEIN

ELEV (A)	DEPTH (B)	DESCRIPTION OF MATERIALS (C)	FIELD SCREENING RESULTS (D) <i>NA</i>	DEPOSIT SAMPLE OR CORE BOX NO (E)	ANALYTICAL SAMPLE NO (F)	REMARKS (G)
		SC, Silty sand, loose, topsoil 10YR 4/2 dark grayish brown, dry	Φ, Φ ppm	Blow Counts		Rec: 1.5 ft / 2.0 ft
		SM, Gravelly sand, med grain size medium dense, dry 2.5 y 7/4 pale yellow mottled with 10YR 7/4 very fine brown		3-13-17	NA	NO SAMPLES COLLECTED FROM BOREHOLE
		CL, sandy clay, medium plastic, soft, 10YR 4/1 dark gray mottled w/ 10YR 4/3 brown				2.0 Rec = 1.6 ft / 2.0 ft
		Clay-CL, high plastic, dry soft, 10YR 5/1 gray mottled with 10YR 4/3	Φ, Φ ppm	3-5-9-1 5-4-1-18	NA	5.0 7/23/14
			Φ, Φ ppm	3-5-9-12	NA	4.0 Rec 1.4 ft / 2.0 ft
		CL, sandy clay, low plastic soft, damp, 10YR 5/2 grayish brown mottled with 10YR 5/4 yellowish brown with subrounded pebbles	Φ, Φ ppm	5-6-8	NA	6.0 Rec 1.3 ft / 2.0 ft WATER at \approx 6.3 ft BGS (0.7 ft of lost recovery probably out of bottom of span)
		SM Gravelly sand with silt, coarse grain, loose, wet 10YR 5/2 grayish brown				
		CL, clay, high plastic very stiff, dry, 10YR 4/1 dark gray	Φ, Φ	4-7-11-18	NA	8.0 Rec 1.4 ft / 2.0 ft

PROJECT

KVAAP

HOLE NO.

LL1MW-064

10.0

HTRW DRILLING LOG

HOLE NUMBER
LHMW-064
SHEET 3 of 3

PROJECT RVAAP

INSPECTOR S.J. Abs ton 11251w

ELEV. (A)	DEPTH (B)	DESCRIPTION OF MATERIALS (C)	FIELD SCREENING RESULTS (D)	GEOTECHNOLOGICAL OR CORE BOX NO. (E)	ANALYTICAL SAMPLE NO. (F)	REMARKS (G)
		SP, fine grain sand, loose saturated, 10/25/1 grey	QVA	BROWNS	NA	Recovery: 1.8 ft / 2.0 ft
		Grades to a coarse grain sand, saturated	0.0 ppm	1-3-6-8	NA	
			0.0 ppm	4-3-49	NA	Recovery: 1.4 ft / 2.0 ft
		CL, clay, high plastic, very stiff, damp, 10/25/1 grey	0.0 ppm	5-8-11-14	NA	Recovery 1.8 ft / 2.0 ft
		SP, fine to med grained sand, loose, saturated 10/25/1 grey	0.0 ppm		NA	Recovery 2.0 ft / 2.0 ft
			0.7 (down auger) ppm	3-5-7-12	NA	Having trouble w/ sands coming up in the auger
		CL, clay, high plastic, very stiff, 10/25/1 grey, loose				Stopped drilling at 18 ft - setting well
						Field Readings with Mini Rae # 000617 and Mx 251 L6L/02 meter # 2330 (H&K)

PROJECT RVAAP DO. # 0022

HOLE NO. LHMW-064

MONITORING WELL

PROJECT NAME: RVAAP

DELIVERY ORDER NO: 0022

WELL NUMBER: LLI MW-064


BEGIN: 7/23/96

END: 7/25/96

COORDINATES: N:
E:

REFERENCE POINT:
MSL


ELEVATION:

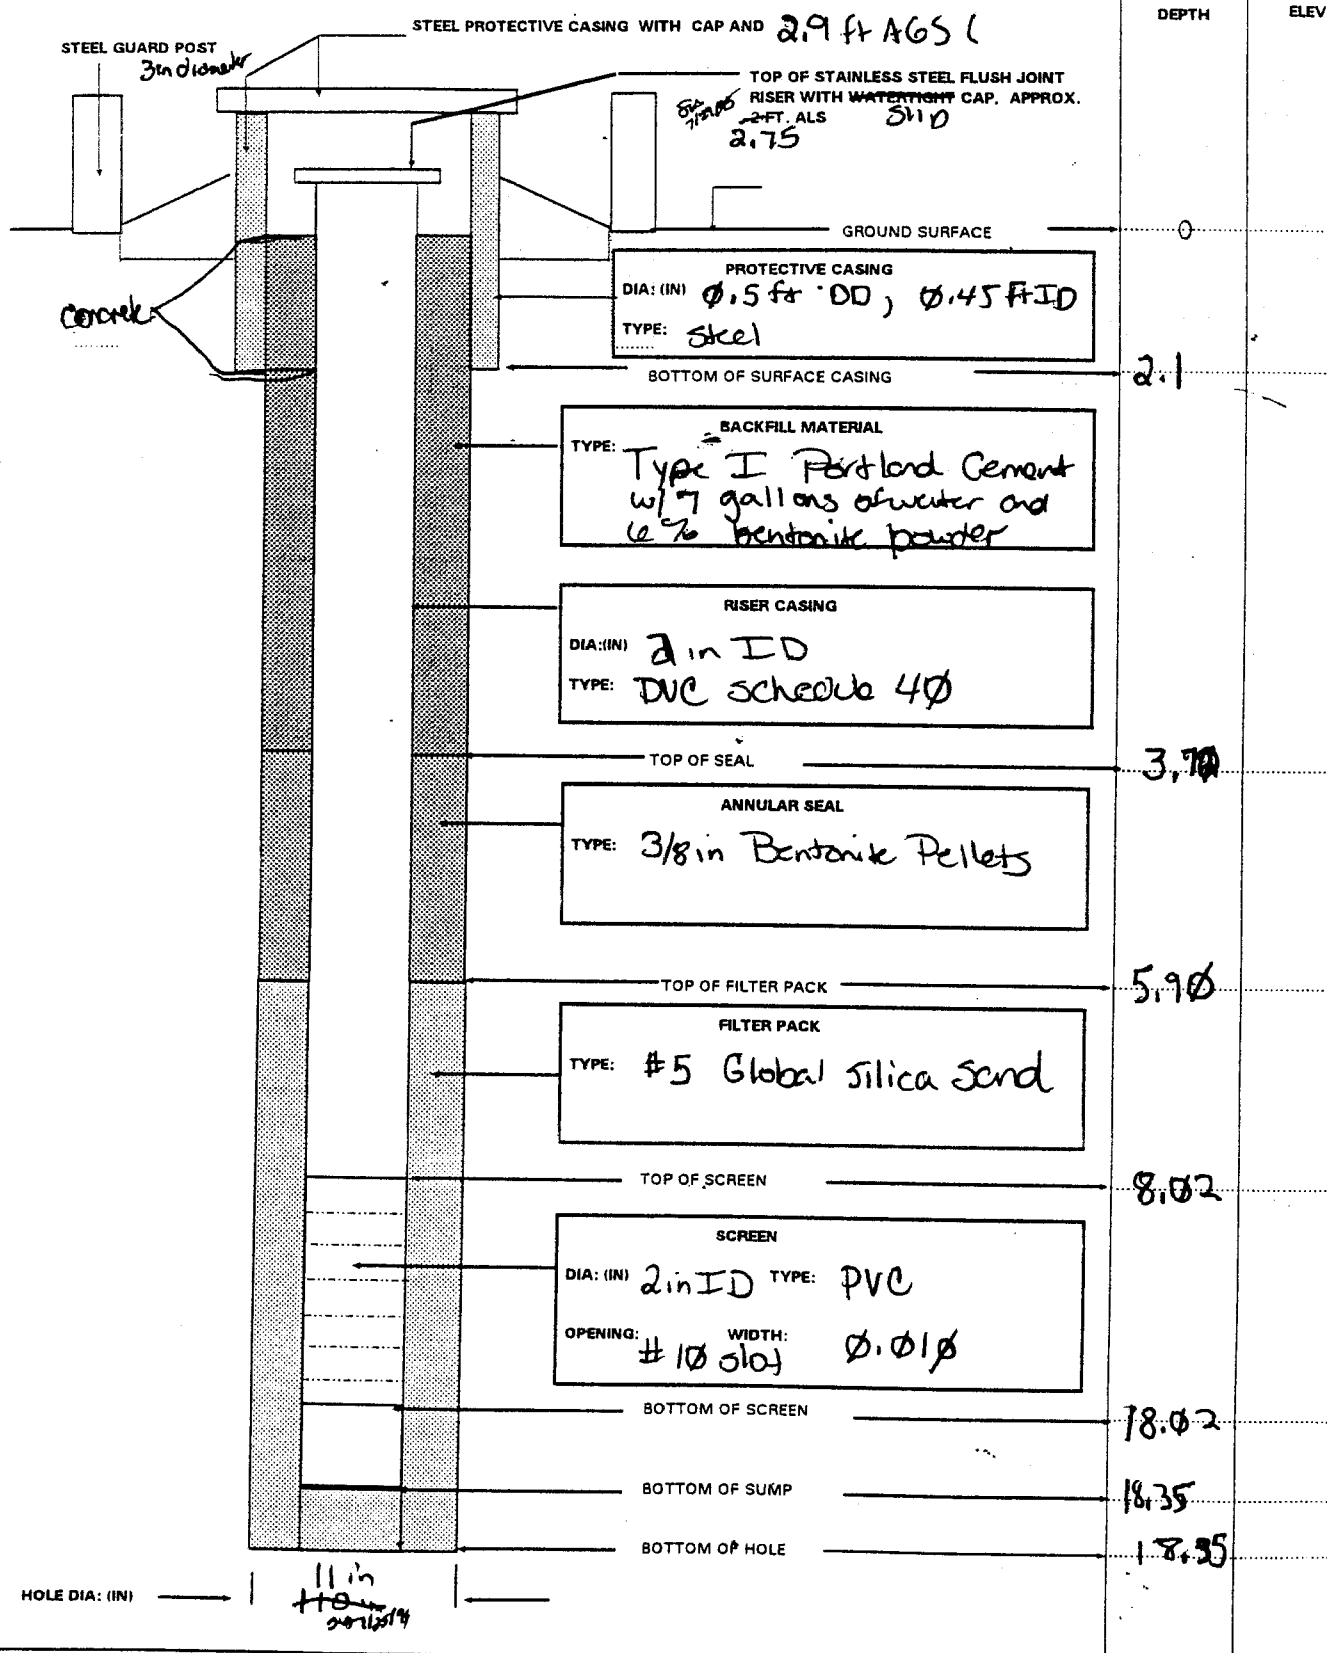

HTRW DRILLING LOG		DISTRICT Nashville		HOLE NUMBER LL1 MW-065	
1. COMPANY NAME SAIG		2. DRILL SUBCONTRACTOR Alliance Environmental		SHEET SHEETS 1 of 3	
3. PROJECT RVAAP			4. LOCATION Load Line 1, RVAAP		
NAME OF DRILLER James Bennett			6. MANUFACTURERS DESIGNATION OF DRILL CME 55		
7. SIZES AND TYPES OF DRILLING AND SAMPLING EQUIPMENT CME 55, 6 5/8 in ID Hollow stem augers with 2 ft - 2 in diameter split spoons		8. HOLE LOCATION See Sketch Below			
12. OVERBURDEN THICKNESS NA		15. DEPTH GROUNDWATER ENCOUNTERED 14.2			
13. DEPTH DRILLED INTO ROCK NA		16. DEPTH TO WATER AND ELAPSED TIME AFTER DRILLING COMPLETED 10.28 (7/28/96) # BGS			
14. TOTAL DEPTH OF HOLE 20.5		17. OTHER WATER LEVEL MEASUREMENTS (SPECIFY) 10.33 # BGS 7/30/96 @ 16.29			
18. GEOTECHNICAL SAMPLES NA		DISTURBED NA	UNDISTURBED NA	19. TOTAL NUMBER OF CORE BOXES NA	
20. SAMPLES FOR CHEMICAL ANALYSIS NA		VOC NA	METALS NA	OTHER (SPECIFY) NA	OTHER (SPECIFY) NA
22. DISPOSITION OF HOLE NA		BACKFILLED NA	MONITORING WELL NA	OTHER (SPECIFY) NA	21. TOTAL CORE RECOVERY % 95
				23. SIGNATURE OF INSPECTOR J. Sumner J. Clifton	

LOCATION SKETCH/COMMENTS

SCALE:

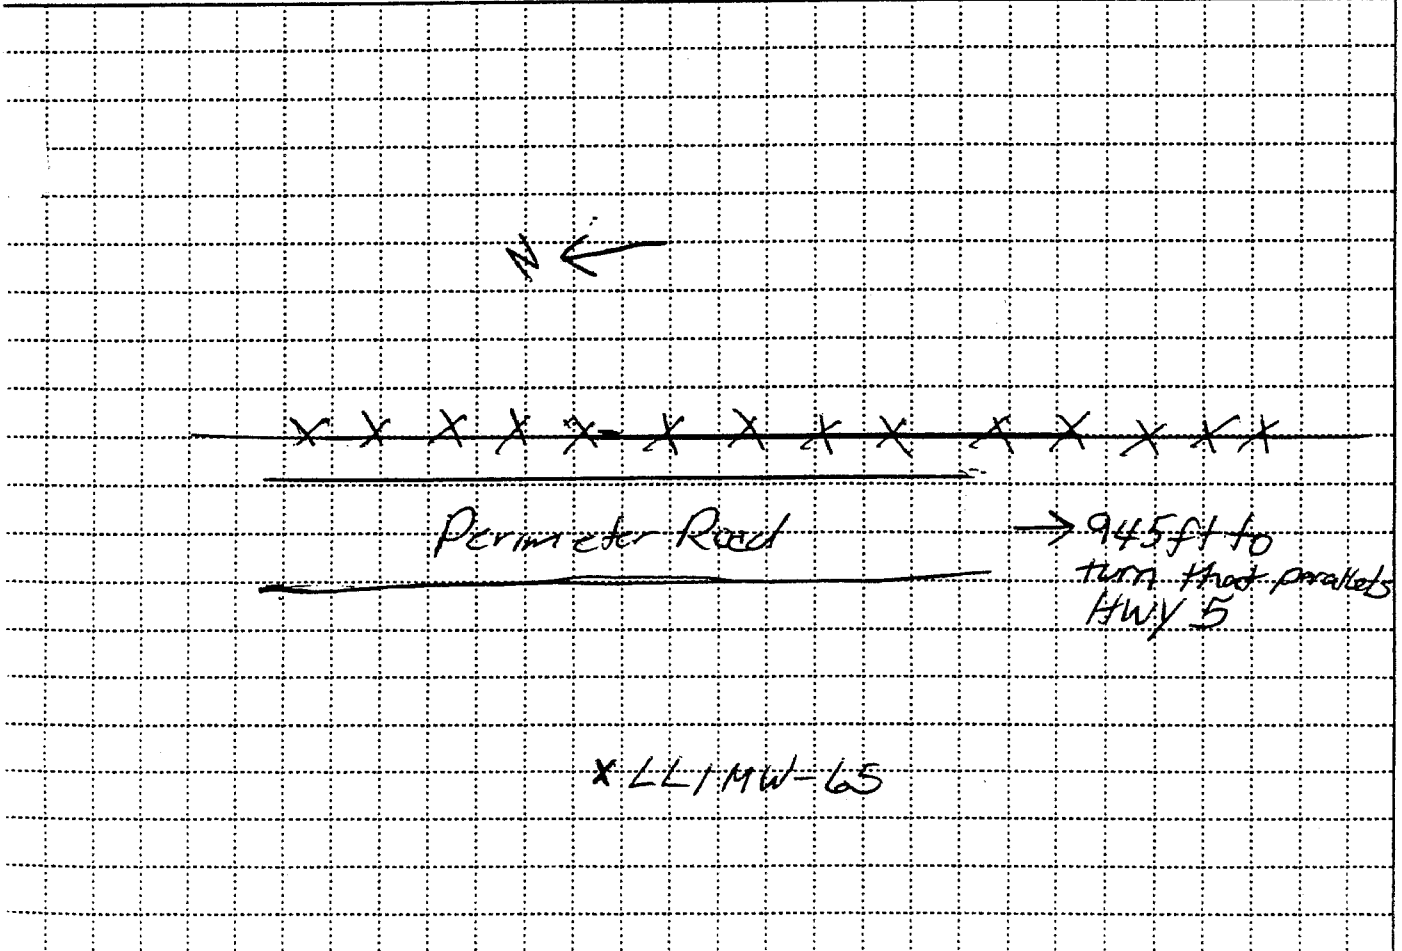

PROJECT

RVAAP

HOLE NO

LL1 MW-065

HTRW DRILLING LOG

HOLE NUMBER
LL1 MW-065
SHEET
2 of 3

PROJECT
RVAAP

INSPECTOR
S.L. Abston sur 7124RL

ELEV (A)	DEPTH (B)	DESCRIPTION OF MATERIALS (C)	FIELD SCREENING RESULTS (D) D/A	GEOTECH SAMPLE OR CORE BOX NO (E)	ANALYTICAL SAMPLE NO. (F)	REMARKS (G)
	0.3	SD, clayey fine grained, med conc. 10YR 4/2 pale greenish brown with rootlets (top soil) CL - silty clay, med. low plastic, firm, 10YR 6/3 pale brown mottled with 7.5YR 6/8 reddish yellow dry - prob. 0.7 loss	1.7 ppm	BLAWCOULS 3 11 9 11	NA	Recovery 1.3 ft / 2.0 ft Field readings with Mini Raet# 00 0617 and MX251 LEL102 meter # 2330 (Hawco)
		some as above but also mottled w/ 10YR 6/3 pale brown, dry - prob. 0.9 loss	3.8 ppm	8 14 17 19	NA	Recovery 1.1 ft / 2.0 ft At 2.0 BGS Borehole reading of 17.8 ppm Breathing zone of 2.7 ppm At 4.0 BGS Borehole reading of 0.7 ppm and Breathing zone of 0.8 ppm
	4.0	- gradation + sandy CL - silty clay, low plastic, hard 10YR 6/3 pale brown mottled with 10YR 6/3 pale brown with small small rock frag. dry - prob 0.8 loss	0.0 ppm	6 15 21 24	NA	At 2.0 BGS Borehole reading of 17.8. Breathing zone reading of 2.7 ppm Breathing zone 0.8 ppm at 4.6 BGS Recovery 1.2 ft / 2.0 ft
		Becoming mottled w/ 7.5YR 5/4 strong brown - iron - prob 0.6 ft loss - - Gradation - - -	0.0 ppm	9 17 26 45	NA	Recovery 1.4 ft / 2.0 ft Inside Auger OVA reading of 33 ppm Breathing zone 0.8 ppm At 6.0 BGS
	7.0	CL, med to high plastic, hard, dry, 10YR 5/3 brown with < 1% small sub angular rock fragments	0.0 ppm	8 16 26 32	NA	Recovery 2.0 ft / 2.0 ft

PROJECT
RVA AP

HOLE NO.
LL1 MW-065

HTRW DRILLING LOG

HOLE NUMBER
LI MW-65

PROJECT **RVAAP**

INSPECTOR **Blow Counts**

S.L. Webster

SHEET **Pg 3 of 3**

ELEV. (A)	DEPTH (B)	DESCRIPTION OF MATERIALS (C)	FIELD SCREENING RESULTS (D)	GEOTECH SAMPLE OR CORE BOX NO. (E)	ANALYTICAL SAMPLE NO. (F)	REMARKS (G)
			NA	17		10' Recovery 2.0' / 2.0'
			0.0 ppm	14	NA	
				19		
	11.3	CL, clay, high plastic, Firm, slightly damp 10YR 5/1 grey		19		
			0.0 ppm	2		12.0' Recovery 2.0' / 2.0'
			0.0 ppm	4	NA	
				4		
		sf Silty, fine grain, loose, wet sand, dense, 10YR 5/4 yellow brown		7		
	14.2	sw, med. grain size, loose, saturated sand 10YR 5/3 brown	0.0 ppm	4		14.0' Recovery 2.0' / 2.0'
			0.0 ppm	2	NA	Water at 14.2 ft BGS
				3		1.5 ft of sand coming into the auger
				2		at 16.0 ft BGS
			0.0 ppm at borehole	2	NA	Recovery 0.5' / 2.0'
				3		
				6		2.5 ft of sand in auger when preparing to drive the 18-20 ft spoon Pulling open cover to flush sand
			0.0 ppm	3		18.0' 1.9' / 2.0' ft Recovery
				3		
				2		
		sw, fine to med grain size loose sand, saturated, 10YR 5/1, grey		3		20.0' Boring terminated at 20.0 ft to install monitoring well Tagged at 20.5 ft BGS
		pass. test 0.1 ft				

PROJECT **RVAAP**

HOLE NO.
LI MW-65

MONITORING WELL

PROJECT NAME: RVAAP

DELIVERY ORDER NO: 0022

WELL NUMBER: **LL1MW 65**


BEGIN: **7/24/96**

END: **7/25/94**

COORDINATES: N:
E:


REFERENCE POINT:
MSL

ELEVATION:

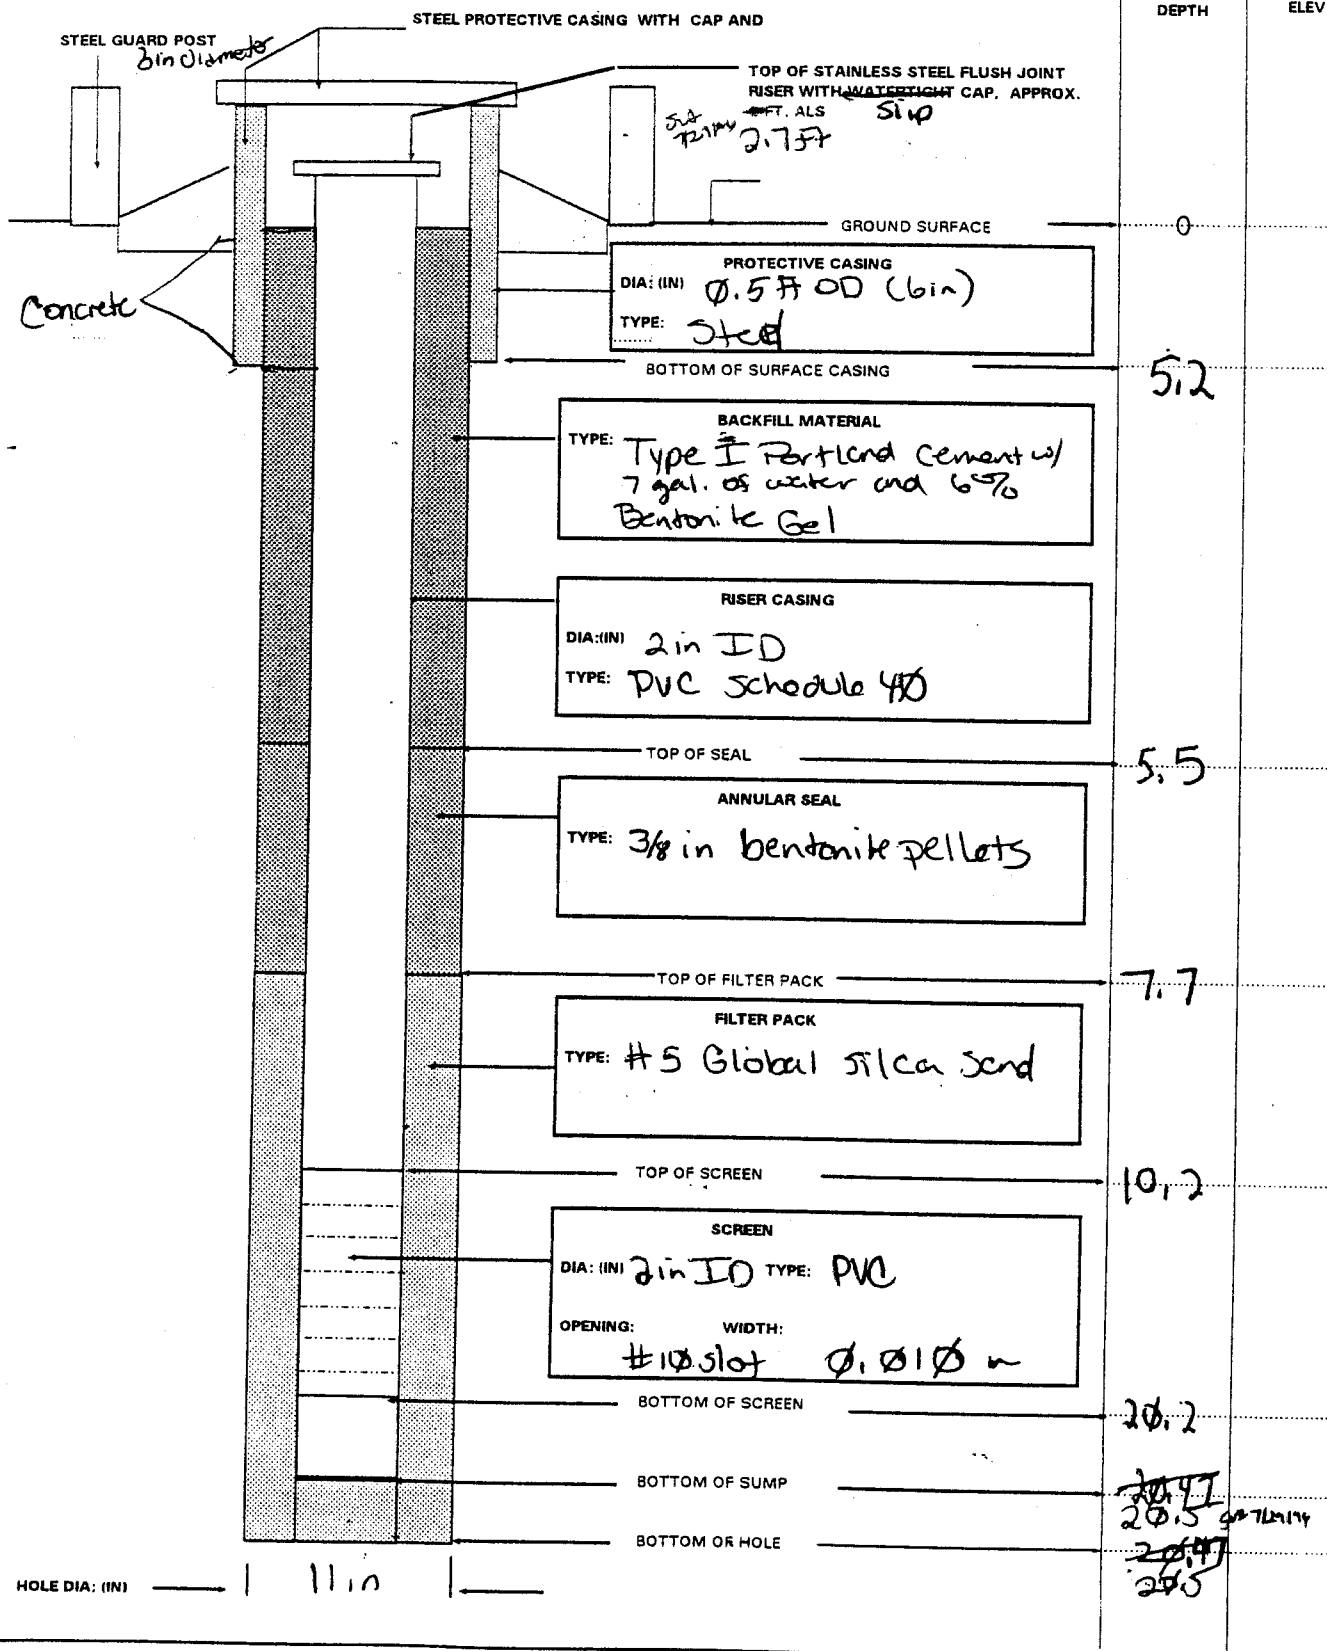

HTRW DRILLING LOG		DISTRICT NASHVILLE		HOLE NUMBER LL1MW67	
1. COMPANY NAME SAIC		2. DRILL SUBCONTRACTOR AEL		SHEET 1 OF 4	
3. PROJECT RVAAP		4. LOCATION LL1 AREA @ RVAAP RAVERINA, OH.			
5. NAME OF DRILLER DAVE NEWMAN		6. MANUFACTURER'S DESIGNATION OF DRILL MOBILE B-G1 HDX			
7. SIZES AND TYPES OF DRILLING AND SAMPLING EQUIPMENT Mobile B-G1 HDX, 5 7/8" tri core roller bit, 6 3/8" in HS Augers, Ingersoll Rand 375 Air Compressor, 2" steel split spoons, & safety driving hammer.		8. HOLE LOCATION LL1 OUTSIDE OF FENCE.			
		9. SURFACE ELEVATION		10. DATE STARTED 12 AUG 96	
				11. DATE COMPLETED 13 AUG 96	
12. OVERBURDEN THICKNESS 5.7 FT BGS		15. DEPTH GROUNDWATER ENCOUNTERED 18.4 FT BGS			
13. DEPTH DRILLED INTO ROCK 17.7 FT BGS		16. DEPTH TO WATER AND ELAPSED TIME AFTER DRILLING COMPLETED			
14. TOTAL DEPTH OF HOLE 23.4 FT BGS		17. OTHER WATER LEVEL MEASUREMENTS (SPECIFY) N/A			
18. GEOTECHNICAL SAMPLES NA	DISTURBED NA	UNDISTURBED NA	19. TOTAL NUMBER OF CORE BOXES NA		
20. SAMPLES FOR CHEMICAL ANALYSIS NA	VOC NA	METALS NA	OTHER (SPECIFY) NA	OTHER (SPECIFY) NA	OTHER (SPECIFY) NA
					21. TOTAL CORE RECOVERY NA
22. DISPOSITION OF HOLE MW INSTALLED	BACKFILLED NA	MONITORING WELL INSTALLED	OTHER (SPECIFY) NA	23. SIGNATURE OF INSPECTOR Matthew B. Vent	

LOCATION SKETCH/COMMENTS SCALE: NOT TO SCALE

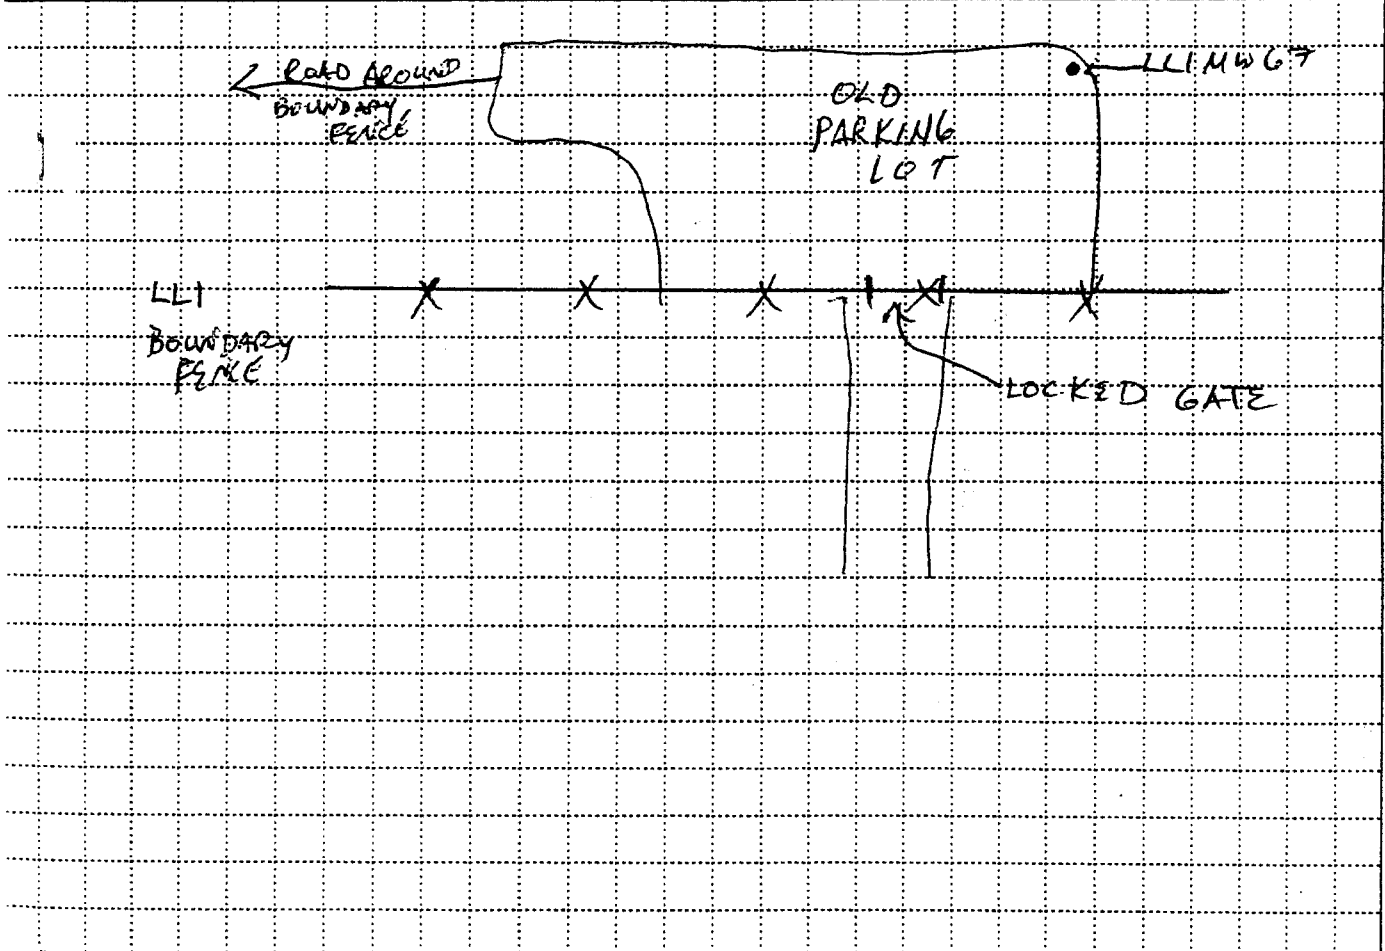

SUBJECT RVAAP	HOLE NO. LL1MW67
-------------------------	----------------------------

HTRW DRILLING LOG						LL1 MW67
PROJECT: RVAAP			INSPECTOR: Matthew B. Verr		SHEET: 2 of 9	
DEPTH (FT)	DESCRIPTION OF MATERIAL	FIELD SCREENING RESULTS	LABORATORY ANALYSES (BGS COUNTS)	ANALYTICAL SAMPLE NO.	REMARKS	
0.7	TOP SOIL w/ ROOTS	0.0 ppm	4 50/2	NA	0.7' REC out of 0.7' Borehole Zone (B2) 0.0 ppm Because 0.0 ppm @ 0.7'	
2.5	f. - m. grained SANDSTONE, sl. damp clay, 10YR 6/8 brownish yellow, weathered & broken up. NO SAMPLE TAKEN, ONLY DRILL CUTTINGS.	NA	NA	NA	Spoon Refusal @ 2.5' B2 0.0 ppm BOREHOLE @ 0.0 ppm Auger without sampling to 2.5 ft BGS.	
3.2	Mt. SILT w/ CLAY, low plasticity, 100% damp, dry, 2.5 4 1/4 olive brown, mottled w/ 2.54 silt gray, w/ occasional black organic specs.	S.T. ppm w/ silty NA	3 6 50/2	NA	0.7' REC out of 0.7' B2 0.0 ppm BOREHOLE @ 0.0 ppm 3.2	
4.0	NO SAMPLE TAKEN	NA	NA	NA	Spoon Refusal @ 3.2' Auger, no sampling - 4.0	
5.7	WEA. f. to med. grained SANDSTONE, interbedded w/ silty clayey SILT, low plasticity, loose, dry, 2.54 4/4 olive brown. Loss of 1.2 FT.	0.0 ppm	30 42 30 50/2	NA	0.5' REC out of 1.7' B2 @ 0.0 ppm BOREHOLE @ 0.0 ppm 5.7	
10.0	TOP OF ROCK @ 5.7 FT BGS f. - m. grained SANDSTONE 10YR 7/4 v. pale brown, sl. damp.	0.0 ppm	NA	NA	Spoon Refusal @ 5.7' AUGER TO 5.5 FT BGS & BEGIN AIR ROTARY @ 5.5 FT BGS. CHECKING B2 & BOREHOLE w/ Mini Rod MODEL PGM-75 SERIAL # 000 167 & 02 LEL MX252 SERIAL # 92 @ 6083-160 DRILLER FEELS THAT @ COMPETANT ROCK @ 5.7 FT BGS. HAD 15 @ lbs. TRYING TO DRILL DEEPER. B2 BOREHOLE @ 0.0 ppm.	

PROJECT: RVAAP

HOLE NO: LL1 MW67

HTRW DRILLING LOG

LL1 MW67

PROJECT RVAAP

INSPECTOR MATHEW B. VEST

SHEET 3 of 4

DEPTH	DESCRIPTION OF MATERIALS	FILLING/SCREENING RESULTS	GRAIN SIZE DISTRIBUTION	ANALYTICAL SAMPLE NO.	REMARKS
12.0	SANDSTONE, f.-m. grained, 10YR 7/4 v. pale brown, damp.	0.2 ppm	NA	NA	E2 @ 0.2 ppm
12.0 - 18.4	SANDSTONE, f.-m. grained, 10YR 7/4 v. pale brown, damp.	0.9 ppm			B2 @ 0.9 ppm
18.4 - 20.0	SANDSTONE, f.-m. grained, 10YR 7/4 v. pale brown, wet.	0.8 ppm			Hit first water @ 18.4 FT BGS B2 @ 0.8 ppm
20.0					20.0

PROJECT RVAAP

HOLE NO. LL1/MW67

HTRW DRILLING LOG

HOLE NO. LLIMW67

PROJECT RVAAP

INSPECTOR MATHEW B. VEST

SHEET 4 of 4

DEPTH	DESCRIPTION OF MATERIALS	FIELD SCREENING RESULTS	GEOCHEMISTRY ANALYSIS	ANALYTICAL SAMPLE NO.	REMARKS
22.7	SAME AS ABOVE	Ø. φ ppm	NA	NA	BZ. @ φ. 9 ppm 24 d
23.4	END OF DRILLING @ 23.4 FT BGS.				STOP DRILLING @ 23.4 FT BGS TO SEE IF BOREHOLE MAKES ENOUGH WATER. 23.4

PROJECT RVAAP

HOLE NO. LLIMW67

MONITORING WELL

PROJECT NAME: RVAAP

DELIVERY ORDER NO: 0022

WELL NUMBER: *LL1 amw 67*


BEGIN: *12 AUG 96*

END: *13 AUG 96*

COORDINATES: N:
E:


REFERENCE POINT:
MSL

ELEVATION:

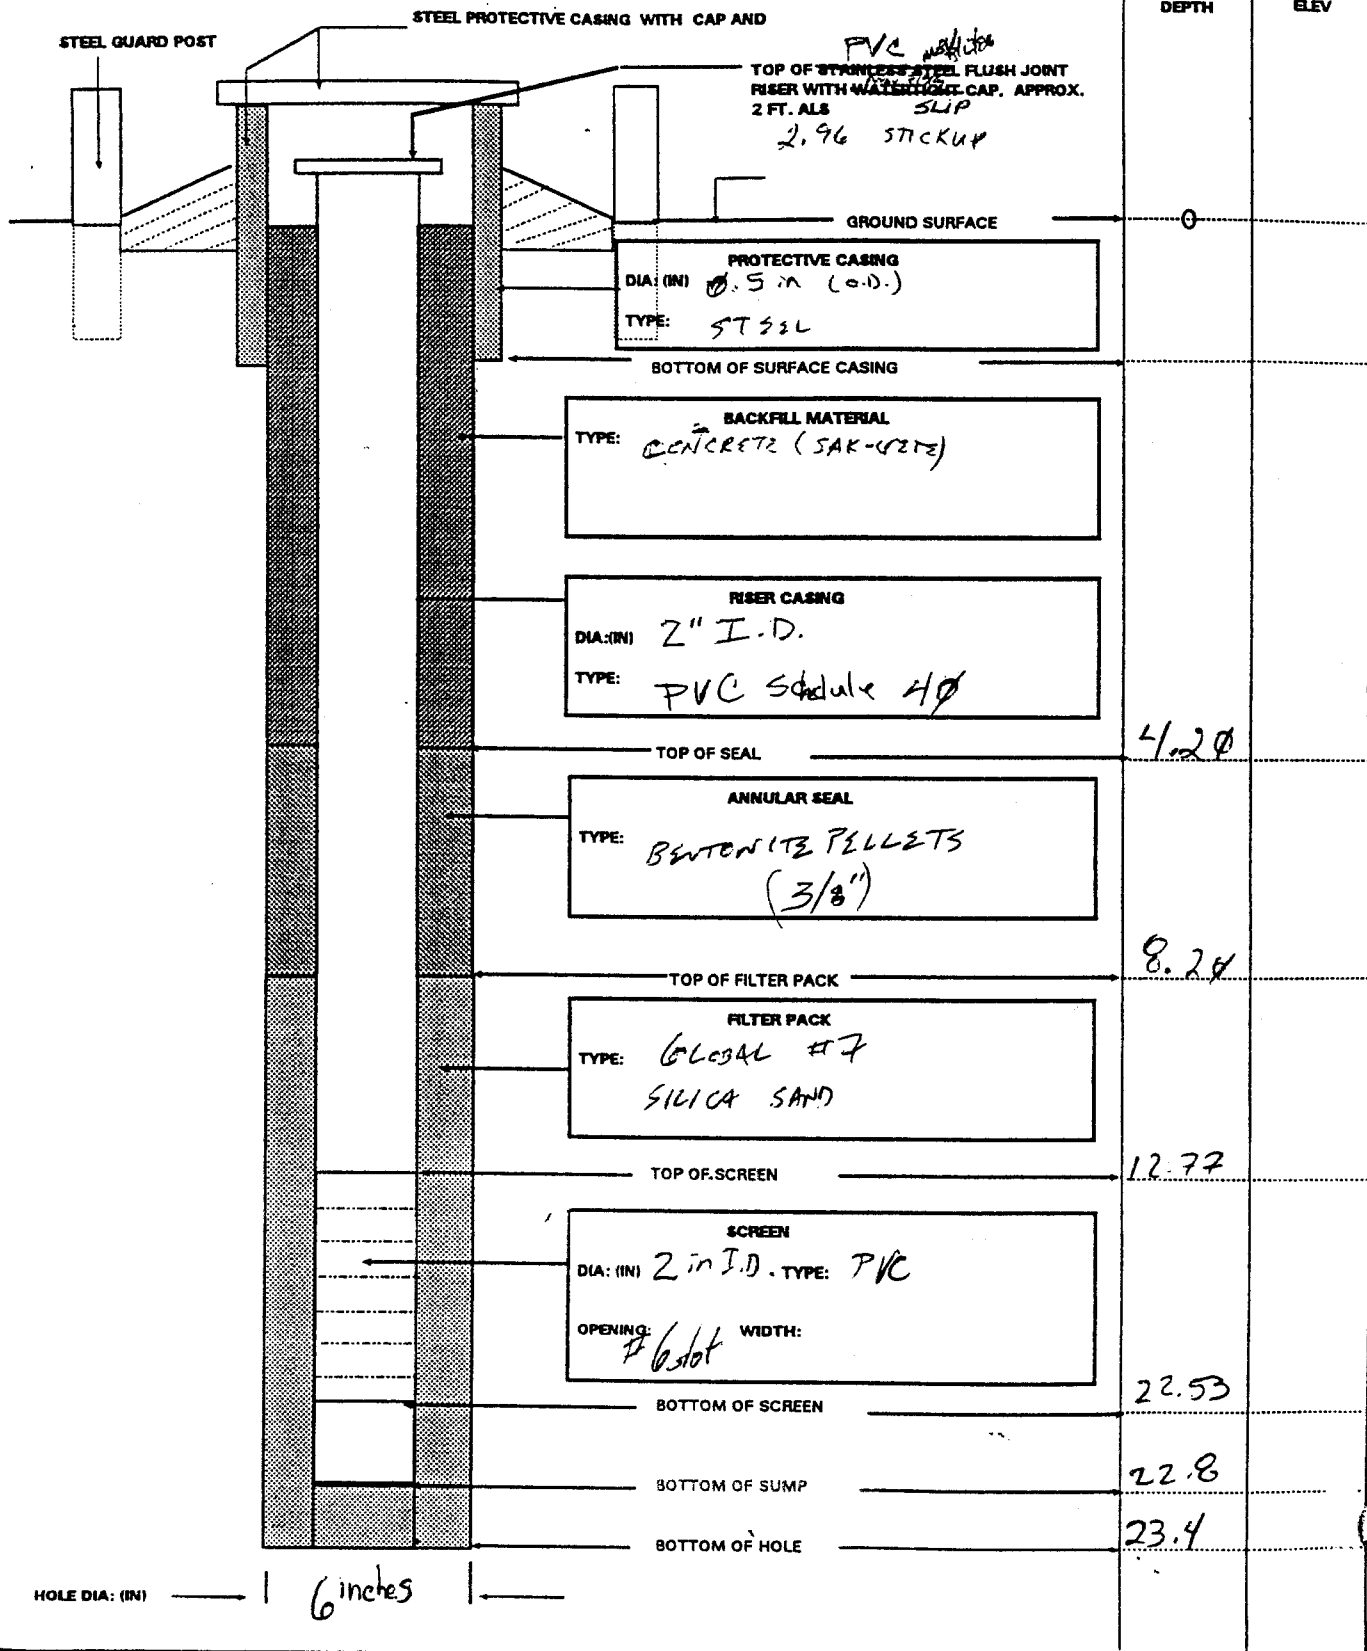

HTRW DRILLING LOG		DISTRICT NASHVILLE		HOLE NUMBER LL2mw59	
COMPANY NAME SAIC		DRILL SUBCONTRACTOR ALLIANCE ENVIRONMENTAL, INC		SHEET 1 OF 4	
SITE # RVAAP		LOCATION LL2 Area @ RVAAP, Ravenna, OH.			
NAME OF DRILLER ED MILLER ^{NOV} DAVE NEWMAN ^{SHOW}		MANUFACTURERS DESIGNATION OF DRILL MOBILE B-61 HDX			
SIZE AND TYPE OF DRILLING AND SAMPLING EQUIPMENT 6 5/8 in HSA, Mobile B-61 HDX, 5 7/8 in Tri-cone roller bit, air compressor; 2" steel split spoons, & safety driving hammer.		HOLE LOCATION S. of KELLY'S POND along rd. @ Well Pt. location			
		SURFACE ELEVATION			
		DATE STARTED 10 AUG 96		DATE COMPLETED 11 AUG 96	
OVERBURDEN THICKNESS 7.7 FT BGS		DEPTH GROUNDWATER ENCOUNTERED 14.5 FT BGS.			
DEPTH DRILLED INTO ROCK 15.2 FT BGS.		DEPTH TO WATER AND ELAPSED TIME AFTER DRILLING COMPLETED 1 hr 30 min later W.L. @ 10.2 FT BGS			
TOTAL DEPTH OF HOLE 22.9 FT BGS		OTHER WATER LEVEL MEASUREMENTS (SPECIFY)			
GEOTECHNICAL SAMPLES NA		DISTURBED NA		UNDISTURBED NA	
TOTAL NUMBER OF CORE BOXES NA					
SAMPLES FOR CHEMICAL ANALYSIS NA		VOC NA	METALS NA	OTHER (SPECIFY) NA	OTHER (SPECIFY) NA
		OTHER (SPECIFY) NA	OTHER (SPECIFY) NA	OTHER (SPECIFY) NA	TOTAL CORE RECOVERY NA
DISPOSITION OF HOLE M.W. Installed.		BACKFILLED NA	MONITORING WELL INSTALLED	OTHER (SPECIFY) NA	SIGNATURE OF INSPECTOR Matthew B. Vest

LOCATION SKETCH/COMMENTS **SAME LOCATION AS WELL PT., LL2 wp-057** SCALE: NOT TO SCALE

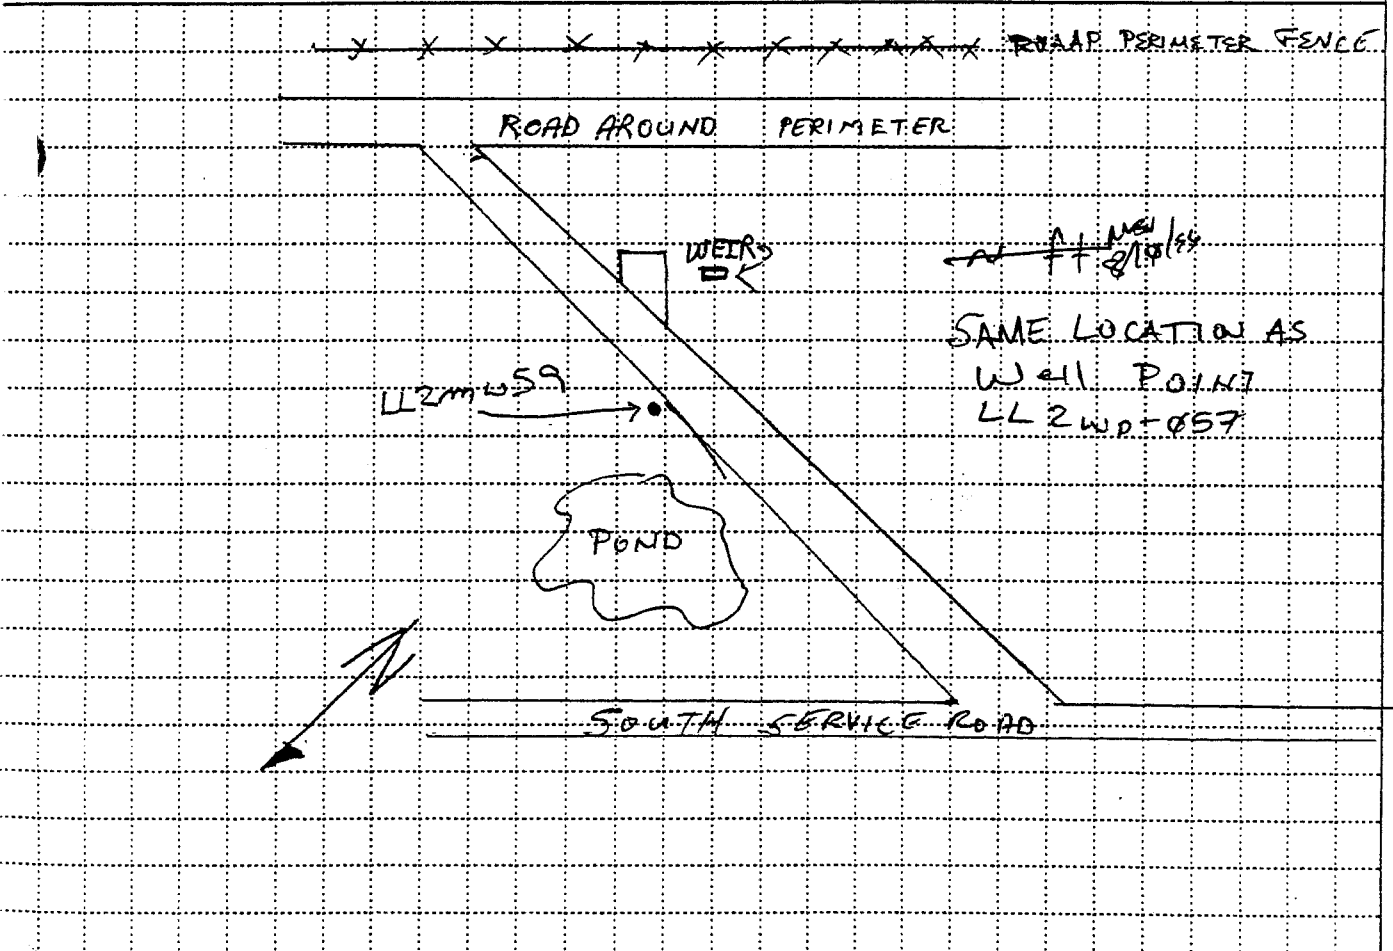

PROJECT RVAAP	HOLE NO. LL2mw59
-------------------------	----------------------------

HTRW DRILLING LOG

HOLE NO. LL2MWS9

PROJECT RVAAP

INSPECTOR Matthew B VEST

SHEET 2 of 4

DEPTH	DESCRIPTION OF MATERIALS	FIELD SCREENING RESULTS	LABORATORY ANALYSIS	ANALYTICAL SAMPLING	REMARKS
0.0	TOPSOIL w/ ROOTS	φ φ ppm	4	NA	REC 1.4' out of 2.0'
0.4	M/L SANDY SILT, low plasticity, loose, sl. damp, 10YR 5/4 yellowish brown.	φ φ ppm	6		Breathing zone (bz) φ φ ppm. Borehole φ φ ppm
0.9			9		USING MINIMAX MODEL PGM-75 SERIAL # 000107 & O2 LEL 111X25 Serial # 9206083-160.
2.0	probable loss of 0.6'		4		2.0
2.0	SM, SILTY SAND, low plas., loose, moist, 10YR 5/4 yellowish brown, w/ small root fragments & sand grains up to 1/16 in. dia.	φ φ ppm	2	NA	REC 1.5' out of 2.0'
3.0			3		Breathing zone (bz) φ φ ppm
4.0			4		Borehole φ φ ppm.
4.0	PROBABLE LOSS OF 0.5'		11		4.0
4.9		φ φ ppm	4	NA	REC 1.5' out of 2.0'
5.9			11		BZ φ φ ppm Borehole φ φ ppm
6.0	M/L CLAYEY SILT w/ SAND, low plas., medium density, sl. damp, 10YR 5/2 grayish brown, w/ specs of black organic material throughout.		20		6.0
6.3			23		
6.3	SAME AS ABOVE, BUT NO BLACK ORGANIC SPECS	φ φ ppm	6	NA	REC 1.7' out of 1.7'
7.2			12		BZ φ φ ppm BOREHOLE φ φ ppm
7.2	Fine to med. grained SANDSTONE, 10YR 6/2 lt. brownish gray, sl. damp, fractured.		30		SPLIT SPOON REFUSAL @ 7.7 FT BGS.
7.7			42/02'		
8.0	NO RECOVERY / Spoon Refusal @ 7.7 FT BGS				8.0
7.7	TOP OF ROCK @ 7.7 FT BGS.	NA	NA	NA	TRIED ANOTHER SPOON @ 8.0 FT BGS BUT REFUSAL @ 8.0 FT BGS. Mini Roc φ ABOVE BACKGROUND AUGER WITHOUT SPOONS TO 10.0 FT BGS.
10.0	Fine to med. gr. SANDSTONE, 10YR 6/2 brownish yellow, sl. damp.				VERY HARD & SLOW DRILLING. DRILLER THINKS WE ARE ON BEDROCK.
10.0	END AUGERING @ 10.0 FT SWITCHING TO ROLLER BIT BGS.				10.0

PROJECT RVAAP

HOLE NO. LL2MWS9

HTRW DRILLING LOG

LL2 mw 59

RVAAP

INSPECTOR: MATTHEW B. VEST

RDT: 3 of 4

DEPTH (FEET)	DESCRIPTION OF MATERIALS	FILLING/GRINDING RESULTS	GRAVIMETRIC ANALYSIS (PERCENTS)	ANALYST'S SAMPLE NO.	REMARKS
14.5	fine to med. gr. SANDSTONE, 10YR/6 brownish yellow, sl. damp.	Ø. Ø ppm	NA	NA	BEGIN DRILLING W/ TRI-CONE ROLLER BIT & AIR COMPRESSOR (AIR ROTARY) @ 10.0 FT BGS. BZ & HOLE @ Ø. Ø ppm
14.5	fine to med. gr. SANDSTONE 10YR 6/6 brownish yellow, wet.	Ø. Ø ppm	NA	NA	HIT ^{SOME} WATER @ 14.5 FT BGS. Not large amount of water. BZ & HOLE @ Ø. Ø ppm
19.3					Below 19.3 ft BGS DRILLING IS SLOWER, POSSIBLY HARDER ROCK BZ & HOLE @ Ø. Ø ppm
20.0					Water is ^{more} prevalent @ 19.3 FT BGS Good water @ this depth. 20.0

PROJECT RVAAP

HOLE NO. LL2 mw 59

MONITORING WELL

PROJECT NAME: RVAAP

DELIVERY ORDER NO: 0022

WELL NUMBER: LL2mw 59


BEGIN: 10 AUG. 96

END: 11 AUG. 96

COORDINATES: N:
E:


REFERENCE POINT:
MSL

ELEVATION:

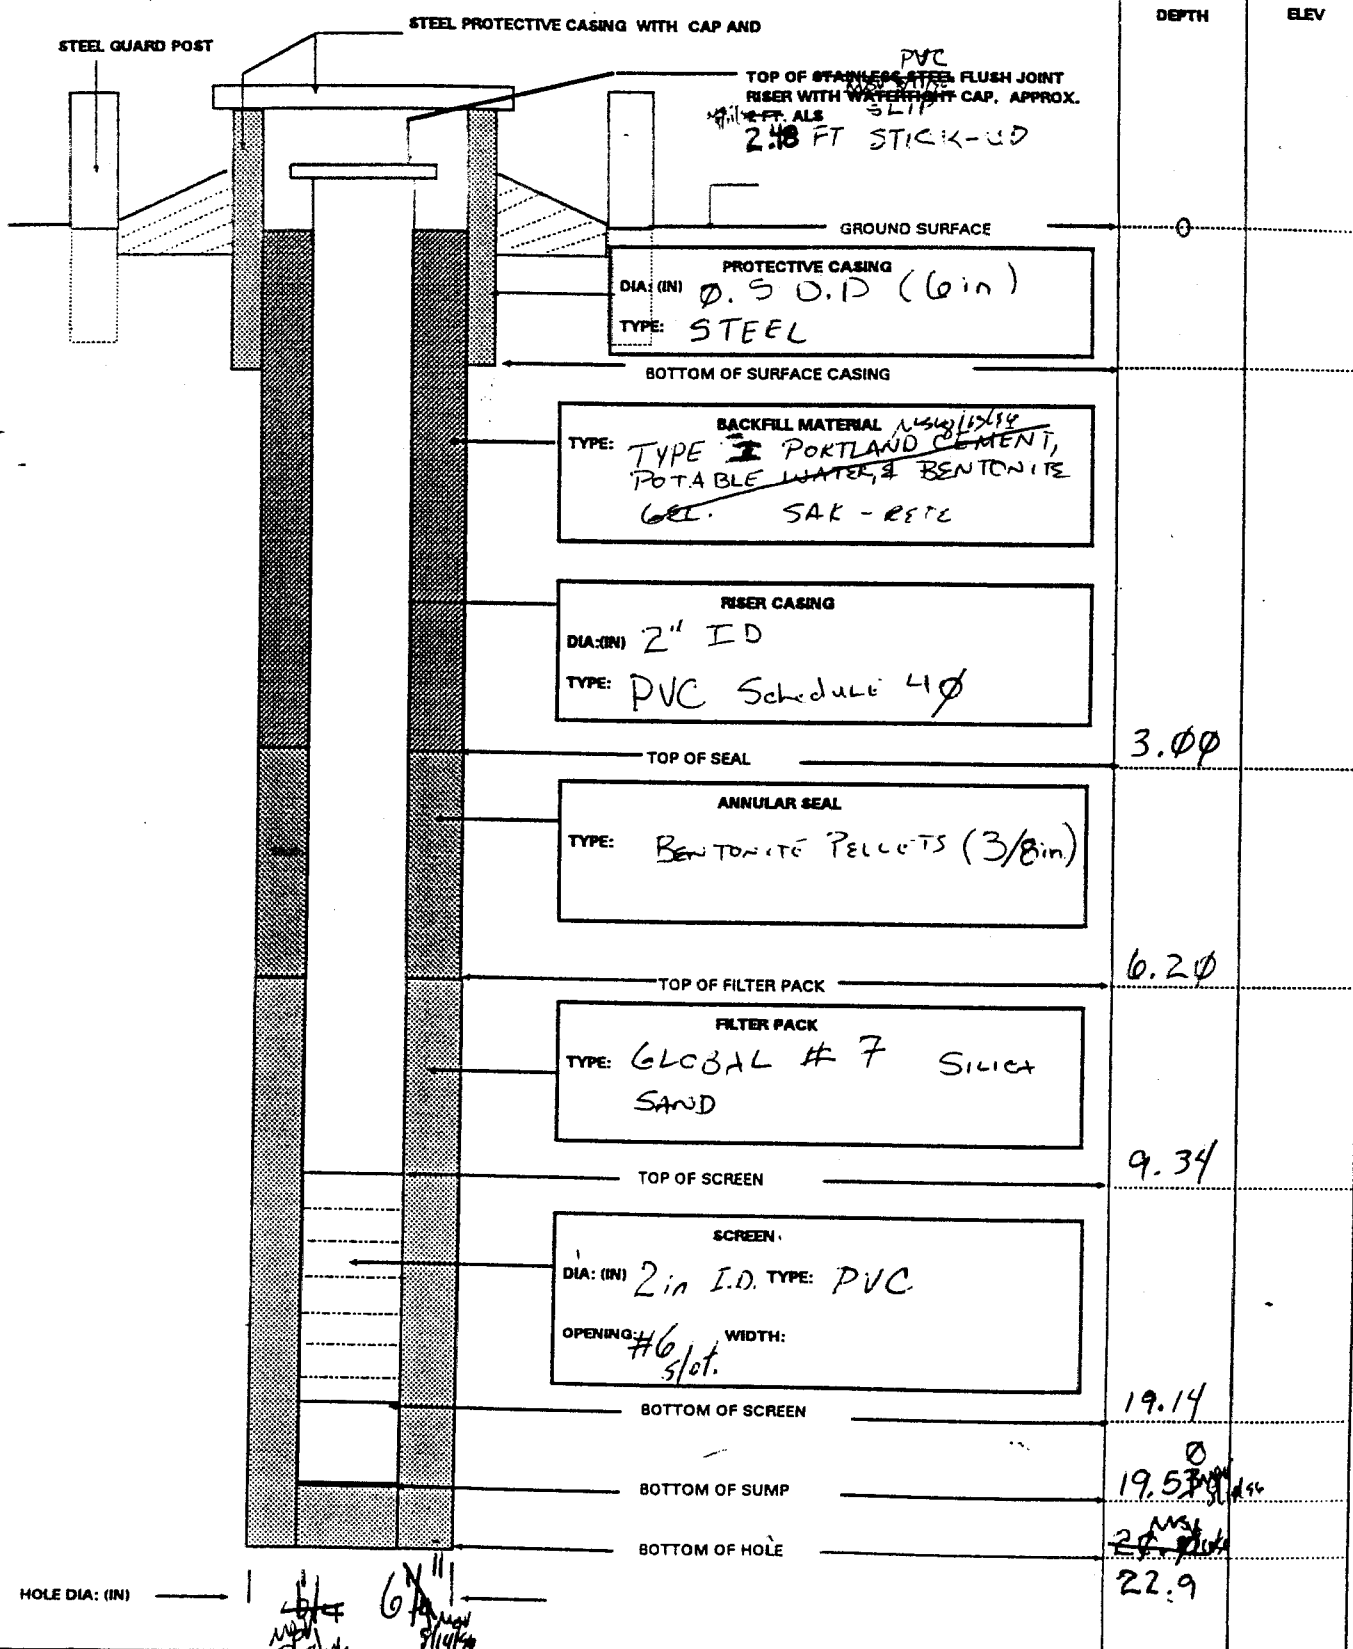

HTRW DRILLING LOG		DISTRICT NASHVILLE	HOLE NUMBER LL2mw6Ø
COMPANY NAME SAIC		DRILL SUBCONTRACTOR ALLIANCE ENVIRONMENTAL, INC.	SHEET 1 OF SHEETS 3
PROJECT RVAAP		LOCATION LL2 Area @ RVAAP, Ravenna, OH	
NAME OF DRILLER DAVE NEWMAN		MANUFACTURERS DESIGNATION OF DRILL MOBILE B-6! HDX	
SIZES AND TYPES OF DRILLING AND SAMPLING EQUIPMENT 1 1/2" (6.5/2 in HSA, 2" split spoons, tri-cone roller bit (5 3/8")		HOLE LOCATION Beside of weir, along rd., S. of Kelly's Pond.	
Mobile B-6! HDX, air compressor, 2" steel split spoons, & safety driving hammer.		SURFACE ELEVATION	
DATE STARTED 11 AUG. 96		DATE COMPLETED 12 AUG. 94	
OVERBURDEN THICKNESS 7.9 FT BGS		DEPTH GROUNDWATER ENCOUNTERED 13.2 FT BGS	
DEPTH DRILLED INTO ROCK 11.3 FT BGS		DEPTH TO WATER AND ELAPSED TIME AFTER DRILLING COMPLETED Thr. 15 min @ 7.5 FT BGS.	
TOTAL DEPTH OF HOLE 19.2 FT BGS		OTHER WATER LEVEL MEASUREMENTS (SPECIFY)	

18. GEOTECHNICAL SAMPLES		DISTURBED		UNDISTURBED		19. TOTAL NUMBER OF CORE BOXES	
NA		NA		NA		NA	
20. SAMPLES FOR CHEMICAL ANALYSIS		VOC	METALS	OTHER (SPECIFY)	OTHER (SPECIFY)	21. TOTAL CORE RECOVERY	
NA		NA	NA	NA	NA	NA	
22. DISPOSITION OF HOLE		BACKFILLED	MONITORING WELL	OTHER (SPECIFY)	23. SIGNATURE OF INSPECTOR		
MW. INSTALLED		NA	INSTALLED	NA	Matthew B. Vest.		

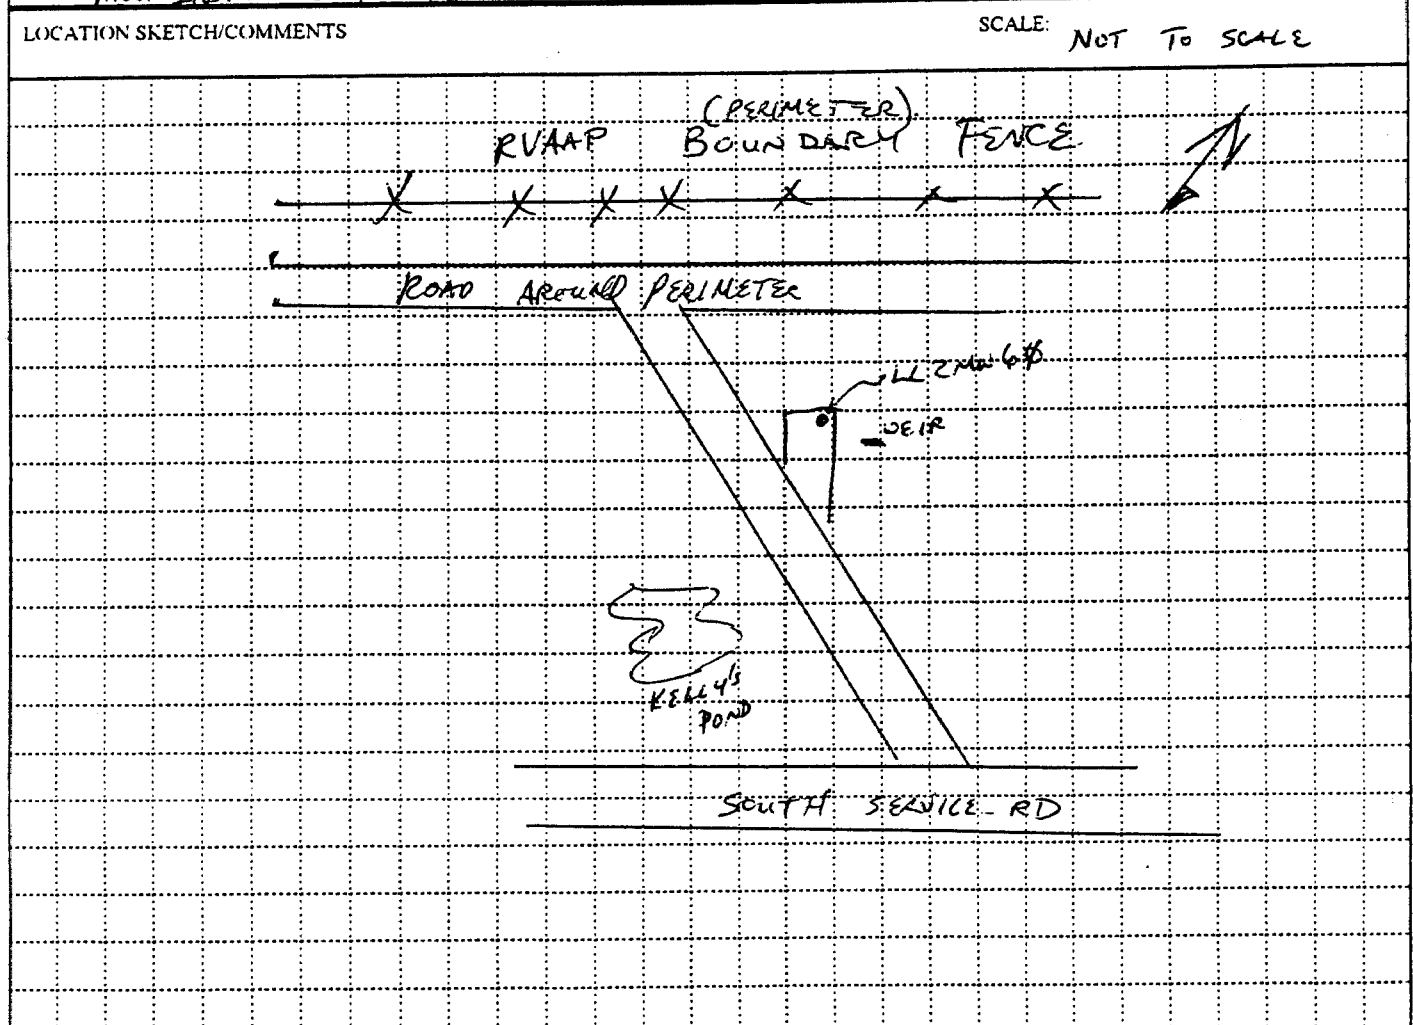

PROJECT RVAAP	HOLE NO. LL2mw6Ø
-------------------------	----------------------------

HTRW DRILLING LOG

HOLE NO. LL2mw60
SHEET 2 of 3

PROJECT RYAAP

INSPECTOR Matthew B. Vest

DEPTH (ft)	DESCRIPTION OF MATERIALS	FIELD BUREAU RESULTS (ppm)	CHLORIDE (ppm)	SULFIDE (ppm)	ANALYTICAL SAMPLE NO.	REMARKS
2.0	TAPSILL w/ roots. Ø.4	Ø.4 ppm	4		NA	REC 1.4 out of 2.0 Breathing zone (BZ) @ Ø.4 ppm Borehole @ Ø.Ø ppm Using Minikac & U ₂ LCL. MIX 251 Serial # Ø.2 Ø.6 Ø.83-16Ø. (Minikac # ØØØ167) to monitor.
4.0	ML SILT w/ sand, low plasticity, medium density, Ø. damp, 10YR 5/3 brown mottled w/ 6/10 gray & 5YR 4/6 yellowish red, w/ occasional sand grains up to Ø.1 in. dia. & chert frags, completely fractured, up to Ø.3 in. roots common & wood fragments occur occasionally. Probable loss of Ø.6 ft.	Ø.Ø ppm	9 10 12 15		NA	REC 1.4 out of 2.0 BZ Ø.Ø ppm Borehole Ø.Ø ppm.
6.0	ML CLAYEY SILT, low plasticity, loose, sl. damp, 10YR 4/1 dark gray mottled w/ 5YR 3/3 dark reddish brown, w/ occasional frags of f-m grained sandstone. Probable loss of Ø.7 ft.	Ø.Ø ppm	5 8 10 11		NA	REC 1.3 out of 2.0 BZ Ø.Ø ppm Borehole Ø.Ø ppm
6.5	ML SILT w/ SAND, low plas, med. density, damp, 7.5Y 4/6 strong brown w/ black flakes of organic matter. 7.8	Ø.Ø ppm	3 9 20		NA	REC 1.9 out of 2.0 BZ Ø.Ø ppm Borehole ppm Ø.Ø
7.0	SM SILTY SAND, low plasticity, med. density, moist, 7.5YR 4/6 strong brown w/ black flakes of organic matter. 2.5Y 5/3 lt. olive brown. 7.7		50/5			
7.9	weathered f-m grained SANDSTONE FRAGMENTS 7.9					
7.9 FT	BGS TOP OF COMPETENT ROCK.	NA	NA	NA	NA	BZ Ø.Ø ppm BOREHOLE Ø.Ø ppm AUGERED WITHOUT SAMPLING SPOONS TO 10.0 FT BGS IN ORDER TO HOOP UP AIR ROTARY SYSTEM DIRECTLY TO TOP OF ROCK @ 7.9 FT (COMPETENT)

PROJECT RYAAP

HOLE NO. LL2mw60

HTRW DRILLING LOG

HOLE NUMBER
LL 2mw 60
SHEET 3 of 3

PROJECT RVAAP INSPECTOR Matthew B. Vest

DEPTH (ft)	DESCRIPTION OF MATERIALS (ft)	FIELD SCREENING RESULTS (ft)	GEOTECHNICAL TESTS / OBSERVATIONS	ANALYTICAL SAMPLE NO. (ft)	REMARKS (ft)
10.0	fine to med grained SANDSTONE, 10-42% brownish yellow, sl. damp	0.0 ppm	NA	NA	BZ 0.0 ppm USING AIR ROTARY, DRILLING w/ TRI-CONE ROLLER BIT.
13.2	fine to med gr. SANDSTONE, 10-42% brownish yellow, wet	0.0 ppm	NA	NA	BZ 0.0 ppm Hit first water @ 13.2 FT BGS.
19.2	STOP AIR ROTARY @ 19.2 FT BGS.				STOP DRILLING @ 19.2 FT BGS.

PROJECT RVAAP

HOLE NO. LL 2mw 60

MONITORING WELL

PROJECT NAME: RVAAP

DELIVERY ORDER NO: 0022

WELL NUMBER: LL2mw 6φ

BEGIN: 11/AUG/96

END:

COORDINATES: N:
E:

REFERENCE POINT:
MSL

ELEVATION:

