C-31-2

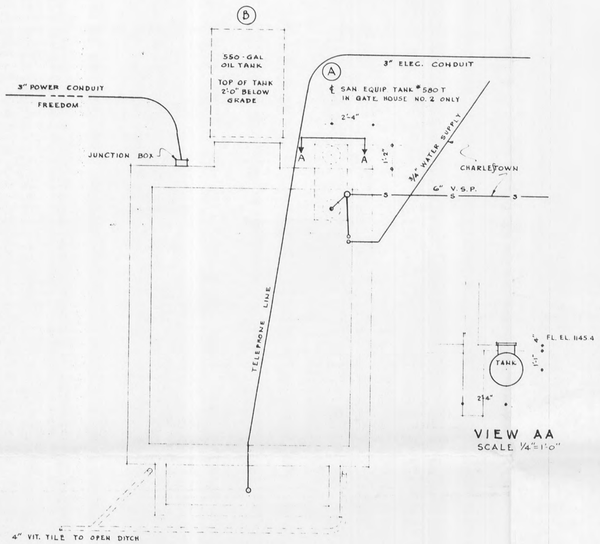

FOUNDATION PLAN
SCALE ¼"=1'-0"

VIEW AA
SCALE ¼"=1'-0"

(A) NOTE
GATE HOUSE NO.1 AS SHOWN
GATE HOUSE NO.2 IDENTICAL EXCEPT TOILET FIXTURES TO BE OMITTED AND CHEMICAL CLOSET SET IN.

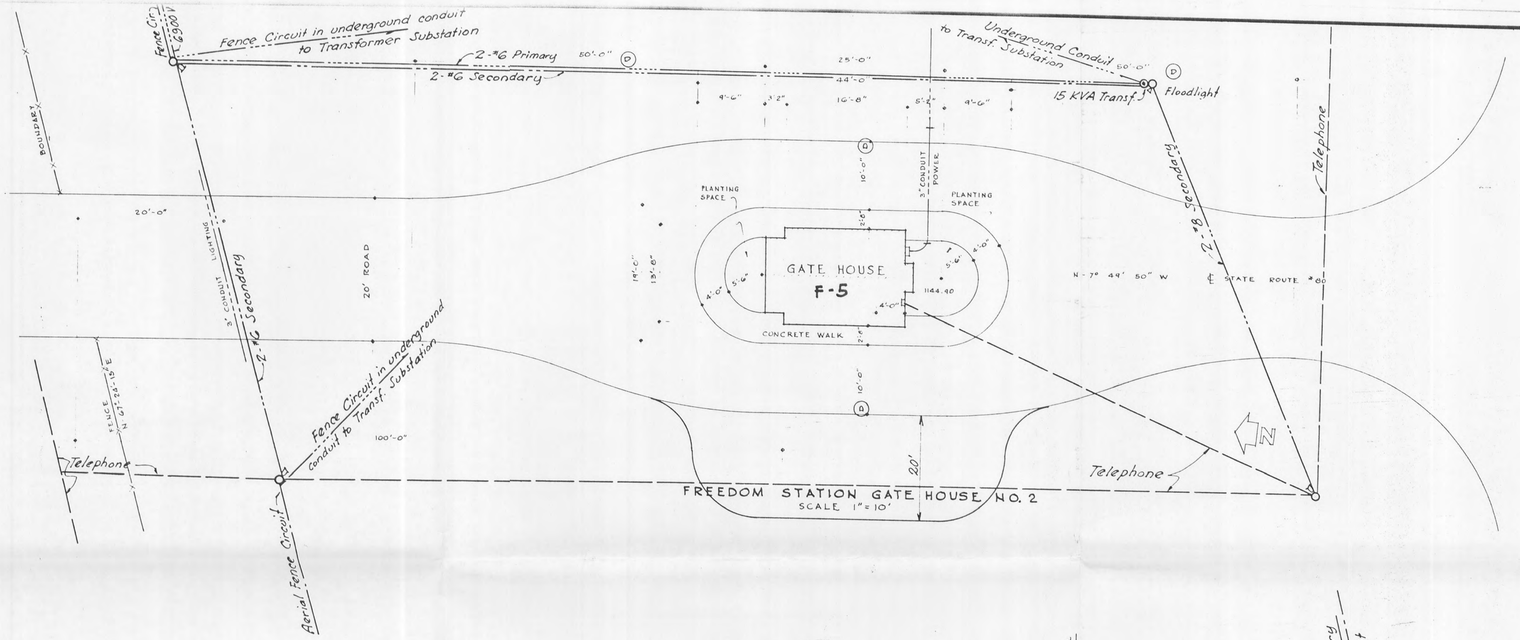

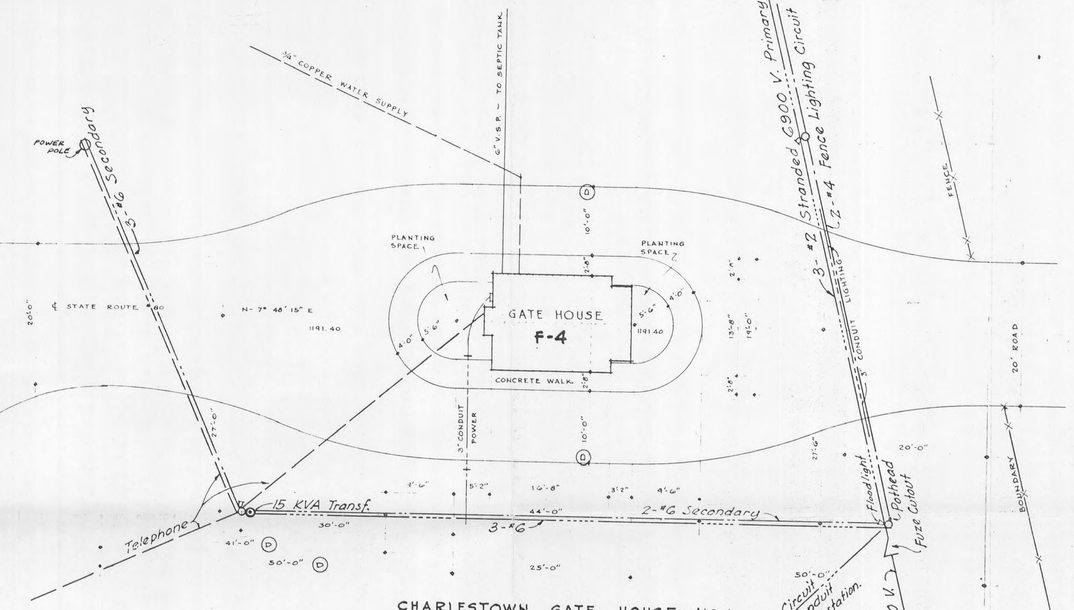

CHARLESTOWN GATE HOUSE NO.1
SCALE 1"=10'

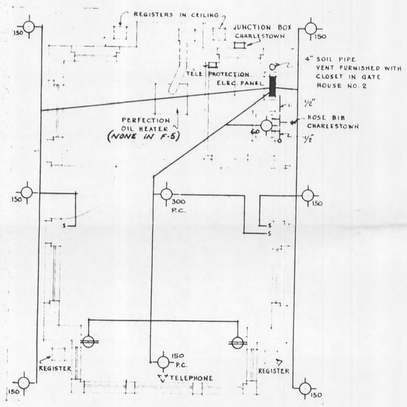

FLOOR PLAN
SCALE ¼"=1'-0"

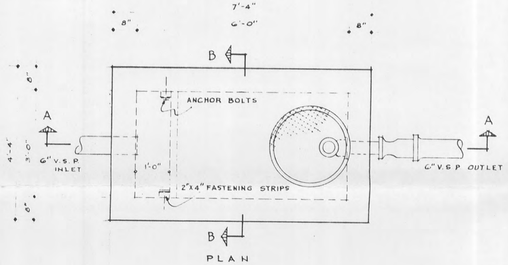

PLAN

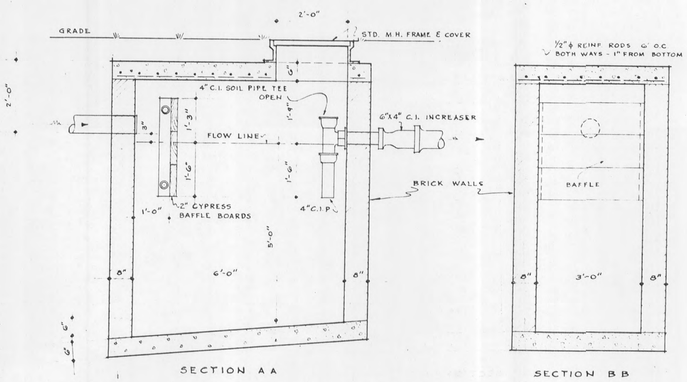

SECTION AA

SECTION BB

SEPTIC TANK
SCALE ½"=1'-0"

DRAWING PLOTTED PER FIELD SURVEY
DATE 4-28-70
RAVENNA ARMY AMMUNITION PLANT
REV. B T.C.D. CHKD BY P.C.B.

DRAWN BY F.L.S.
DATE SEPTEMBER 28th 1956
TRACED BY K.C. CHKD BY F.N.M.

REVISION NO. D, E AND F APPROVED BY-

L. H. EATON · PLANT ENGINEER

C. H. WILLISTON · ASS'T. GENERAL MANAGER

C. W. MELDRUM · LT. COL. ORD. DEPT. COMMANDING

(A) ELIMINATED PLUMBING & FIXTURES AT GATE HOUSE NO. 2 - ALSO HEATING & WELL PIT

(B) ADDED FUEL OIL TANKS TO GATE HOUSES NOS. 1 & 2 - ALSO OIL HEATERS. SAN-EQUIP. TANK & CLOSET ADDED TO GATE HOUSE NO. 2

APPROVED - HDLV 8/6

(D) ROUTE 80 COMPLETELY REPAVED. REFER TO DRAWINGS J-201 THRU J-210 (REC. NO. 6988-737 THRU 6988-746). REFER TO ATLAS POWDER CO. DWGS. SK-1026 AND SK-1027

(E) BUILDINGS NO. F-4 AND F-5

THE JENNINGS-LAWRENCE CO.
ARCHITECT - ENGINEER
COLUMBUS, O. - RAVENNA, O.

SCALE AS NOTED

CONSTRUCTION DIVISION
OFFICE OF THE QUARTERMASTER GENERAL

PORTAGE ORDNANCE DEPOT
GATE HOUSES NO 1 & 2 (E)
PLUMBING - HEATING - ELECTRICAL

REVISIONS			
A	11-11-41	J.T.W.	
B	11-25-41	E.L.S.	
C	TRACED ORIGINAL DRAWING WITH CORRECTIONS AS BUILT		3/16/42
D	REF. TO REV. DRWGS.		7/6/42
E	ADDED BLDG. NUMBERS		7/24/42
F	ADDED POWER & TELEPH. LINES		11/14/42

DRAWN BY J.T.W. CHECKED BY E.L.S. APPROVED BY DIRECTION R. S. CHAVIN LT. COL. ORD. DEPT. DATE OCT. 14, 1941

TRACED BY FV

PLAN NUMBER 6988-519

C-31-2