CORPS OF ENGINEERS

U. S. ARMY

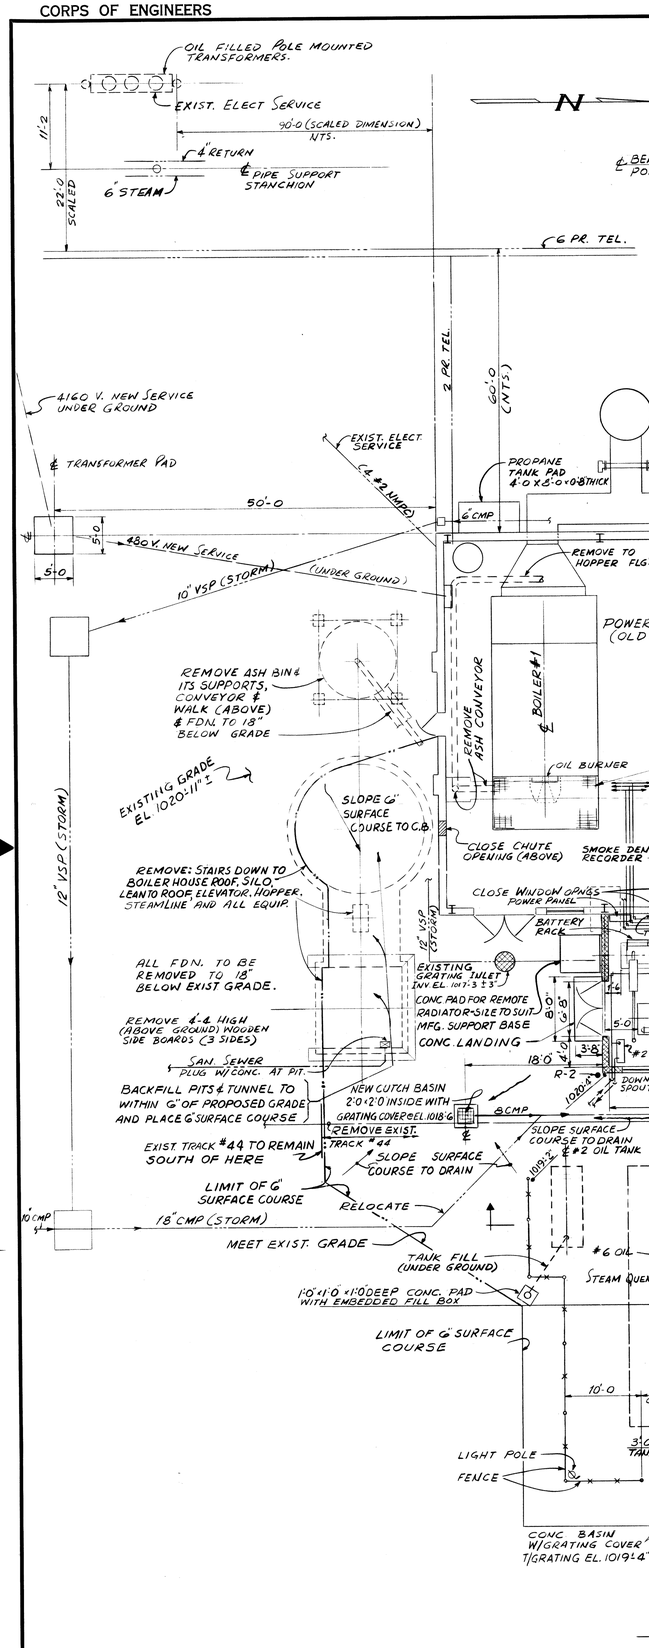

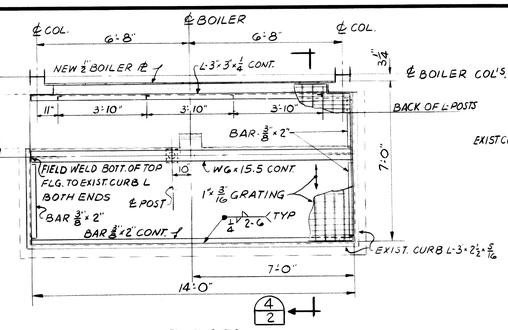

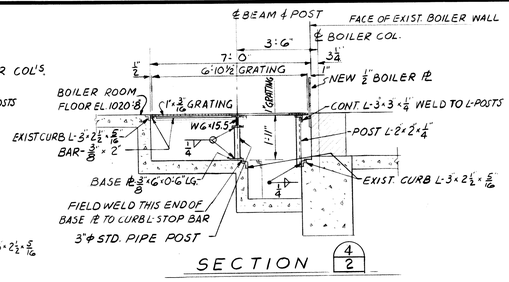

DETAIL 3/2
SCALE 3/8" = 1'-0"

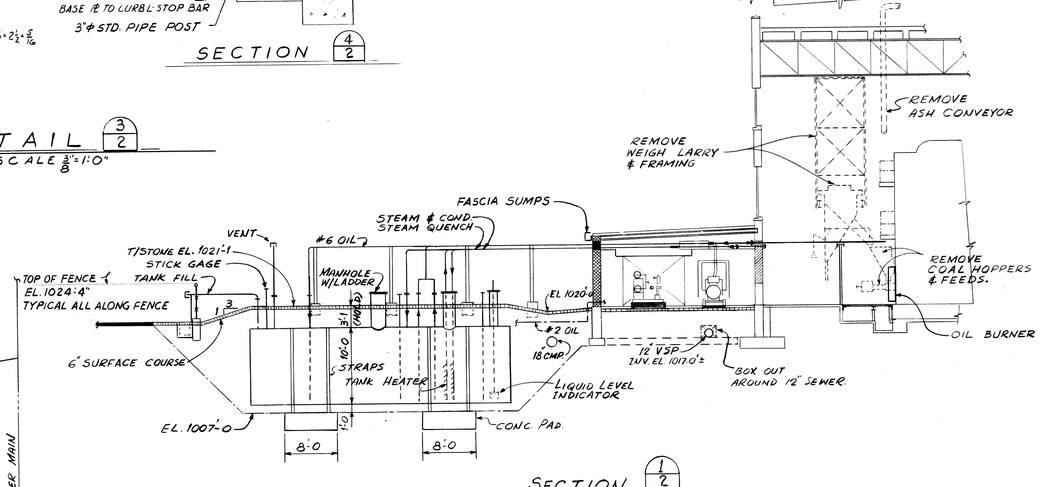

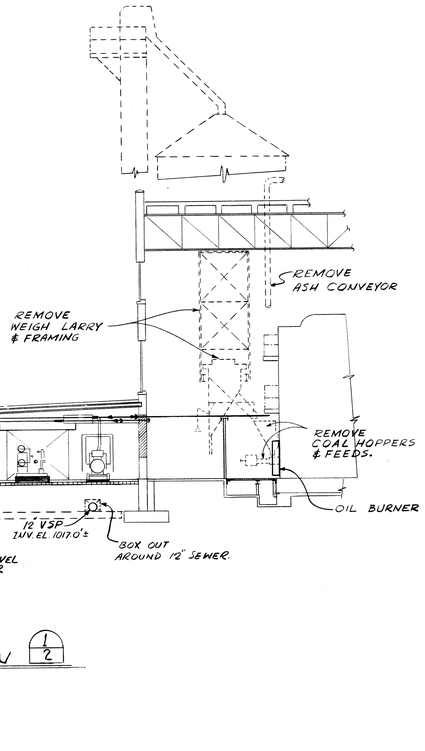

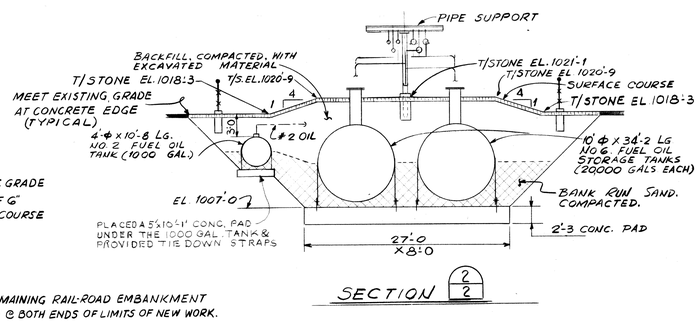

NOTES;

1. R-1 AND R-2 = LOCATION OF BORING. SEE BORING SHEET NO. 1 & 2.
2. NEW GRADE ELEVATIONS THUS 1020'-0"

REV	DATE	DESCRIPTION	BY
	Mar 75	As Constructed	EGH

DEPARTMENT OF THE ARMY
BALTIMORE DISTRICT, CORPS OF ENGINEERS
BALTIMORE, MARYLAND

RAVENNA AAP OHIO

CONVERSION OF POWERHOUSE NO. 6 FROM COAL TO NO. 6 FUEL OIL GEN. PLAN AND SECTIONS

TRYGVE HOFF & ASSOC.
CONSULTING ENGINEERS
CLEVELAND, OHIO 44106

DRAWING NUMBER 26-02-23

PLATE 2

SCALE: 1/8 = 1'-0 DATE: 11-15-72 SHEET 2 OF

BALTIMORE 19 1253 HERCULENE 49438